


**TRAP AREA**

NOTE: 6" wye branches used on this project.

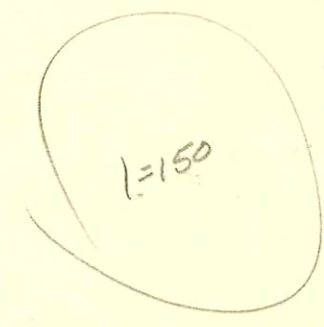

**LAT. 5, SUB. 1, S. S. N° 22**

W. B. CARTER AUG. 4, 1954

BK. N° K-17 PROJ. NO. C24-20

- (2+35) → # 2158 - 1211 Berkeley - Home - 10-1-54
- # 2150 - 6-8-1219 Berkeley - Home - 10-1-54
- 2151-6-8-1208 Catalina - Wichita - 10-18-54
- 2152-6-8-1206 Catalina - Wichita - 10-18-54
- 2153-6-8-1202 Catalina - Wichita - 10-18-54
- 2156-6-8-1118 Catalina - Wichita - 10-20-54
- 2155-6-8-1120 Catalina - Wichita - 10-29-54
- 2154-6-8-1126 Catalina - Wichita - 10-29-54
- 2164-6-8-1107 Berkeley - Wichita - 10-29-54
- 2163-6-8-1115 Berkeley - Wichita - 10-29-54
- 2157-6-8-1114 Catalina - Wichita - 10-28-54
- Bob Scott - 4" sch 40 8' w of pl - trap installed, 1V45, 6x4 Fernco, 1' from main - Fernco to CI@house
- 201-02025-8/16/01-1420 E Catalina - Apah No Leaks - 4" sch 40, (TW) WCO tied back to claytile w/ferneo ApX 18' from main

- 2001-01607
- # 2148 - 6-8 wye - 1214 Catalina - Wichita P. B. Co - 9-30-54 - 7/10/01 J-Hawk 4" sch 40 Replace 50' swr line
- # 2147 - 6-8 wye - 1220 Catalina - Wichita P. B. Co - 9-30-54
- # 2162 - 6-8 wye - 1119 Berkeley - Wichita P. B. Co - 9-30-54
- # 2161 - 6-8 wye - 1121 Berkeley - Wichita P. B. Co - 9-30-54
- # 2160 - 6-8 wye - 1201 Berkeley - Wichita P. B. Co - 9-30-54
- # 2159 - 6-8 wye - 1207 Berkeley - Wichita P. B. Co - 9-30-54 - 11/22/02 4" sch 40 (11' w. of main)
- # 2149 - 6-8 wye - 1221 Berkeley - Wichita P. B. Co - 9-30-54 - Reddi - 4" twin co, new trap, tied to 6" clay at SWL

