


RECORD BOOK

Page 220

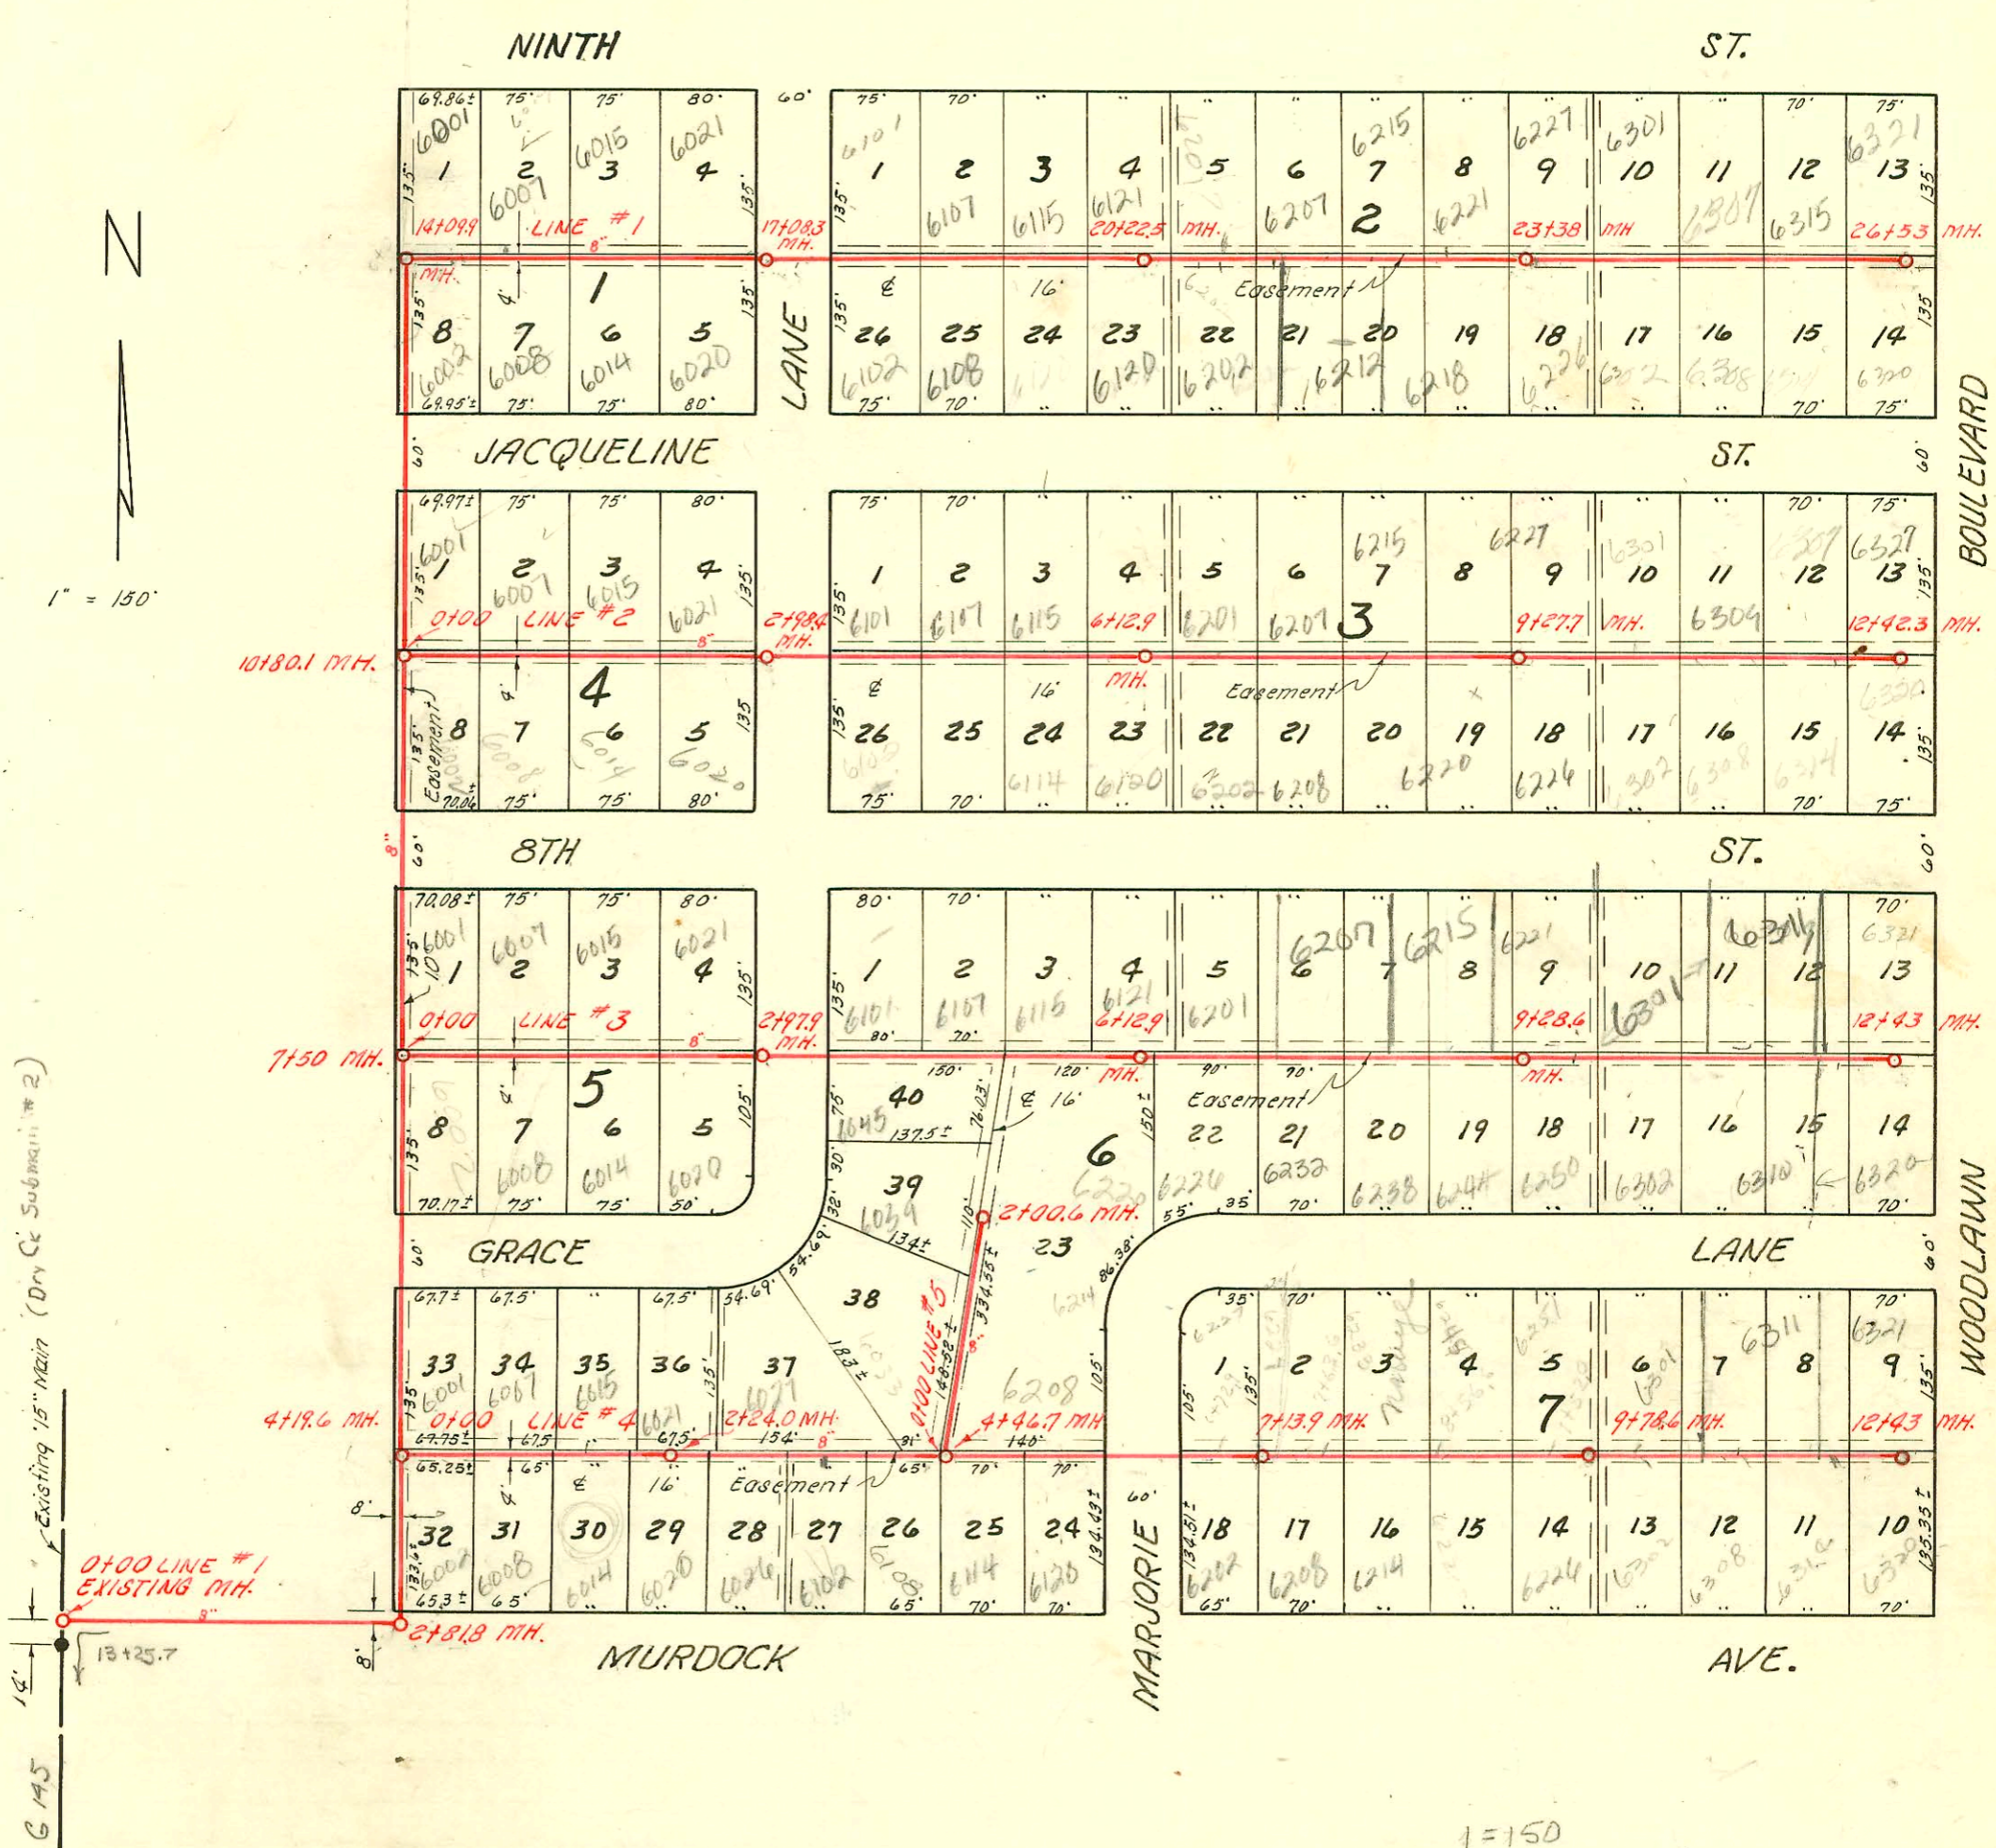

Note: Construction Record for this project booked on pages 195, 196 & 197.

Rec# 36689 346320 E 8th St - Leidy - 2-5-57
 Rec# 51664 246321 Jacqueline - Reiffel
 2003-01348 R Reddy Rootr 5119103 Predco by city 93'E of MH 9+28.6(10+21.6) Depth 13.8'
 3426 - Japn - 6301 E, 8th - Reiffel - 2/21/57 2V22, 1H45, 1H22, 1V45, 1V22, 1WYE
 2001-00279- 2/7/01- 6915 E Jacqueline - Boardman - 4" SCH 40 - CITY WYE REPAIR - 130' w of MH 2+98.4
 (1+68.4) 1TWINCO, 1H22, 1V45
 2001-00669- 3/27/01- 6121 E 9th St - Wichita Exc - 4" SCH 40 Donut 24.7' w of MH 20+22.3 (19+97.8) - 1TWINCO,
 1V22, 1H22, 1V45, Fernco to CI@ house

LAT. 36, D.C.S. No 2, S. S. No 12

W. B. CARTER

JUNE 30, 1954

BK. NO. JI. 69

PROJ. NO. C 24 - 22

CONSTRUCTION RECORD

SERVICE RECORD

STATION	ELEVATION		Depth	MANHOLE	4-INCH "Y" BRANCHES		No. of Permit		House Number		DATE OF PERMITS	
	Ground	Grade			North West	South East	North West	South East	North West	South East	North West	South East
0+0	181.4	171.65	9.8	0+00 New M.H.								
1+0	182.0	172.05	9.9									
2+0	183.9	172.45	11.4									
	185.5	176.77 out 176.77 in	8.7	2+81.8								
3+0	186.0	176.85	9.1									
4+0	188.0	177.25 out 177.33 out 179.33 in	10.7 10.8 8.8	4+19.6								
5+0	189.3	179.65	9.7									
6+0	190.1	180.05	10.0									
7+0	190.6	180.45 out 182.65 out 184.65 in	10.2 10.3 6.3	7+50.0								
8+0	191.3	184.85	6.5									
9+0	191.9	185.25	6.6									
10+0	192.7	185.65	7.0									
	192.5	185.97	6.5	10+80.1								
11+0	192.3	186.05	6.2									
12+0	193.5	186.45	7.0									
13+0	194.9	186.85	8.0									
14+0	195.8	187.25 out 187.49 in	8.5 8.3	14+09.9	14+03.9		250291		5939 E. 926		7-11-75	
					14+27.2	14+24.2						
					14+96.0	14+93.0						
15+0	196.7	187.85	8.9									
16+0	197.2	188.25	8.9									
					16+40.8	16+37.8						
17+0	198.1	188.65	9.4									
	198.1	188.68	9.4	17+08.3								
18+0	199.3	189.05	10.2									
19+0	199.2	189.45	9.8									
20+0	199.7	189.85	9.8									
	199.8	189.94	9.9	20+22.5								
21+0	200.2	190.25	10.0									
22+0	200.2	190.65	9.6									
23+0	200.6	191.05	9.5									
	200.4	191.20	9.2	23+38.0								
24+0	200.1	191.45	8.6									
25+0	198.9	191.85	7.0									
26+0	198.1	192.25	5.8									
	197.8	192.46	5.3	26+53.0								

This project continues on page 196

Line # 1

Line # 2

#5079 - 6021 E. 8th - Kennedy - 9-22-54 #2373 - 6016 R. 12-17-54 RR RAY
 #3302 - 6286 E. 8th - Dr. Donald P. King - 10-19-54 " " " " 2-28-54
 #2420 - 60115 Jacqueline - R. La. 4th - 11-4-54 (6+19.9)
 #2544 - 6045 Jacqueline - Fredenial P. King - 11-10-54
 #5157 - 6120 E. 8th - Arthur Ray - 8-1-55
 #7198 - 6001 R. 9th - Arthur Ray - 8-11-54
 #2904 - 6302 Jacqueline - 9-10-54
 #2913 - 6308 Jacqueline - 10-26-54
 #2907 - 6314 Jacqueline - 10-26-54
 #4050 - 6015 R. 6012 R. Jacqueline - 11-20-54
 #4051 - 6015 R. 6012 R. Jacqueline - 11-20-54
