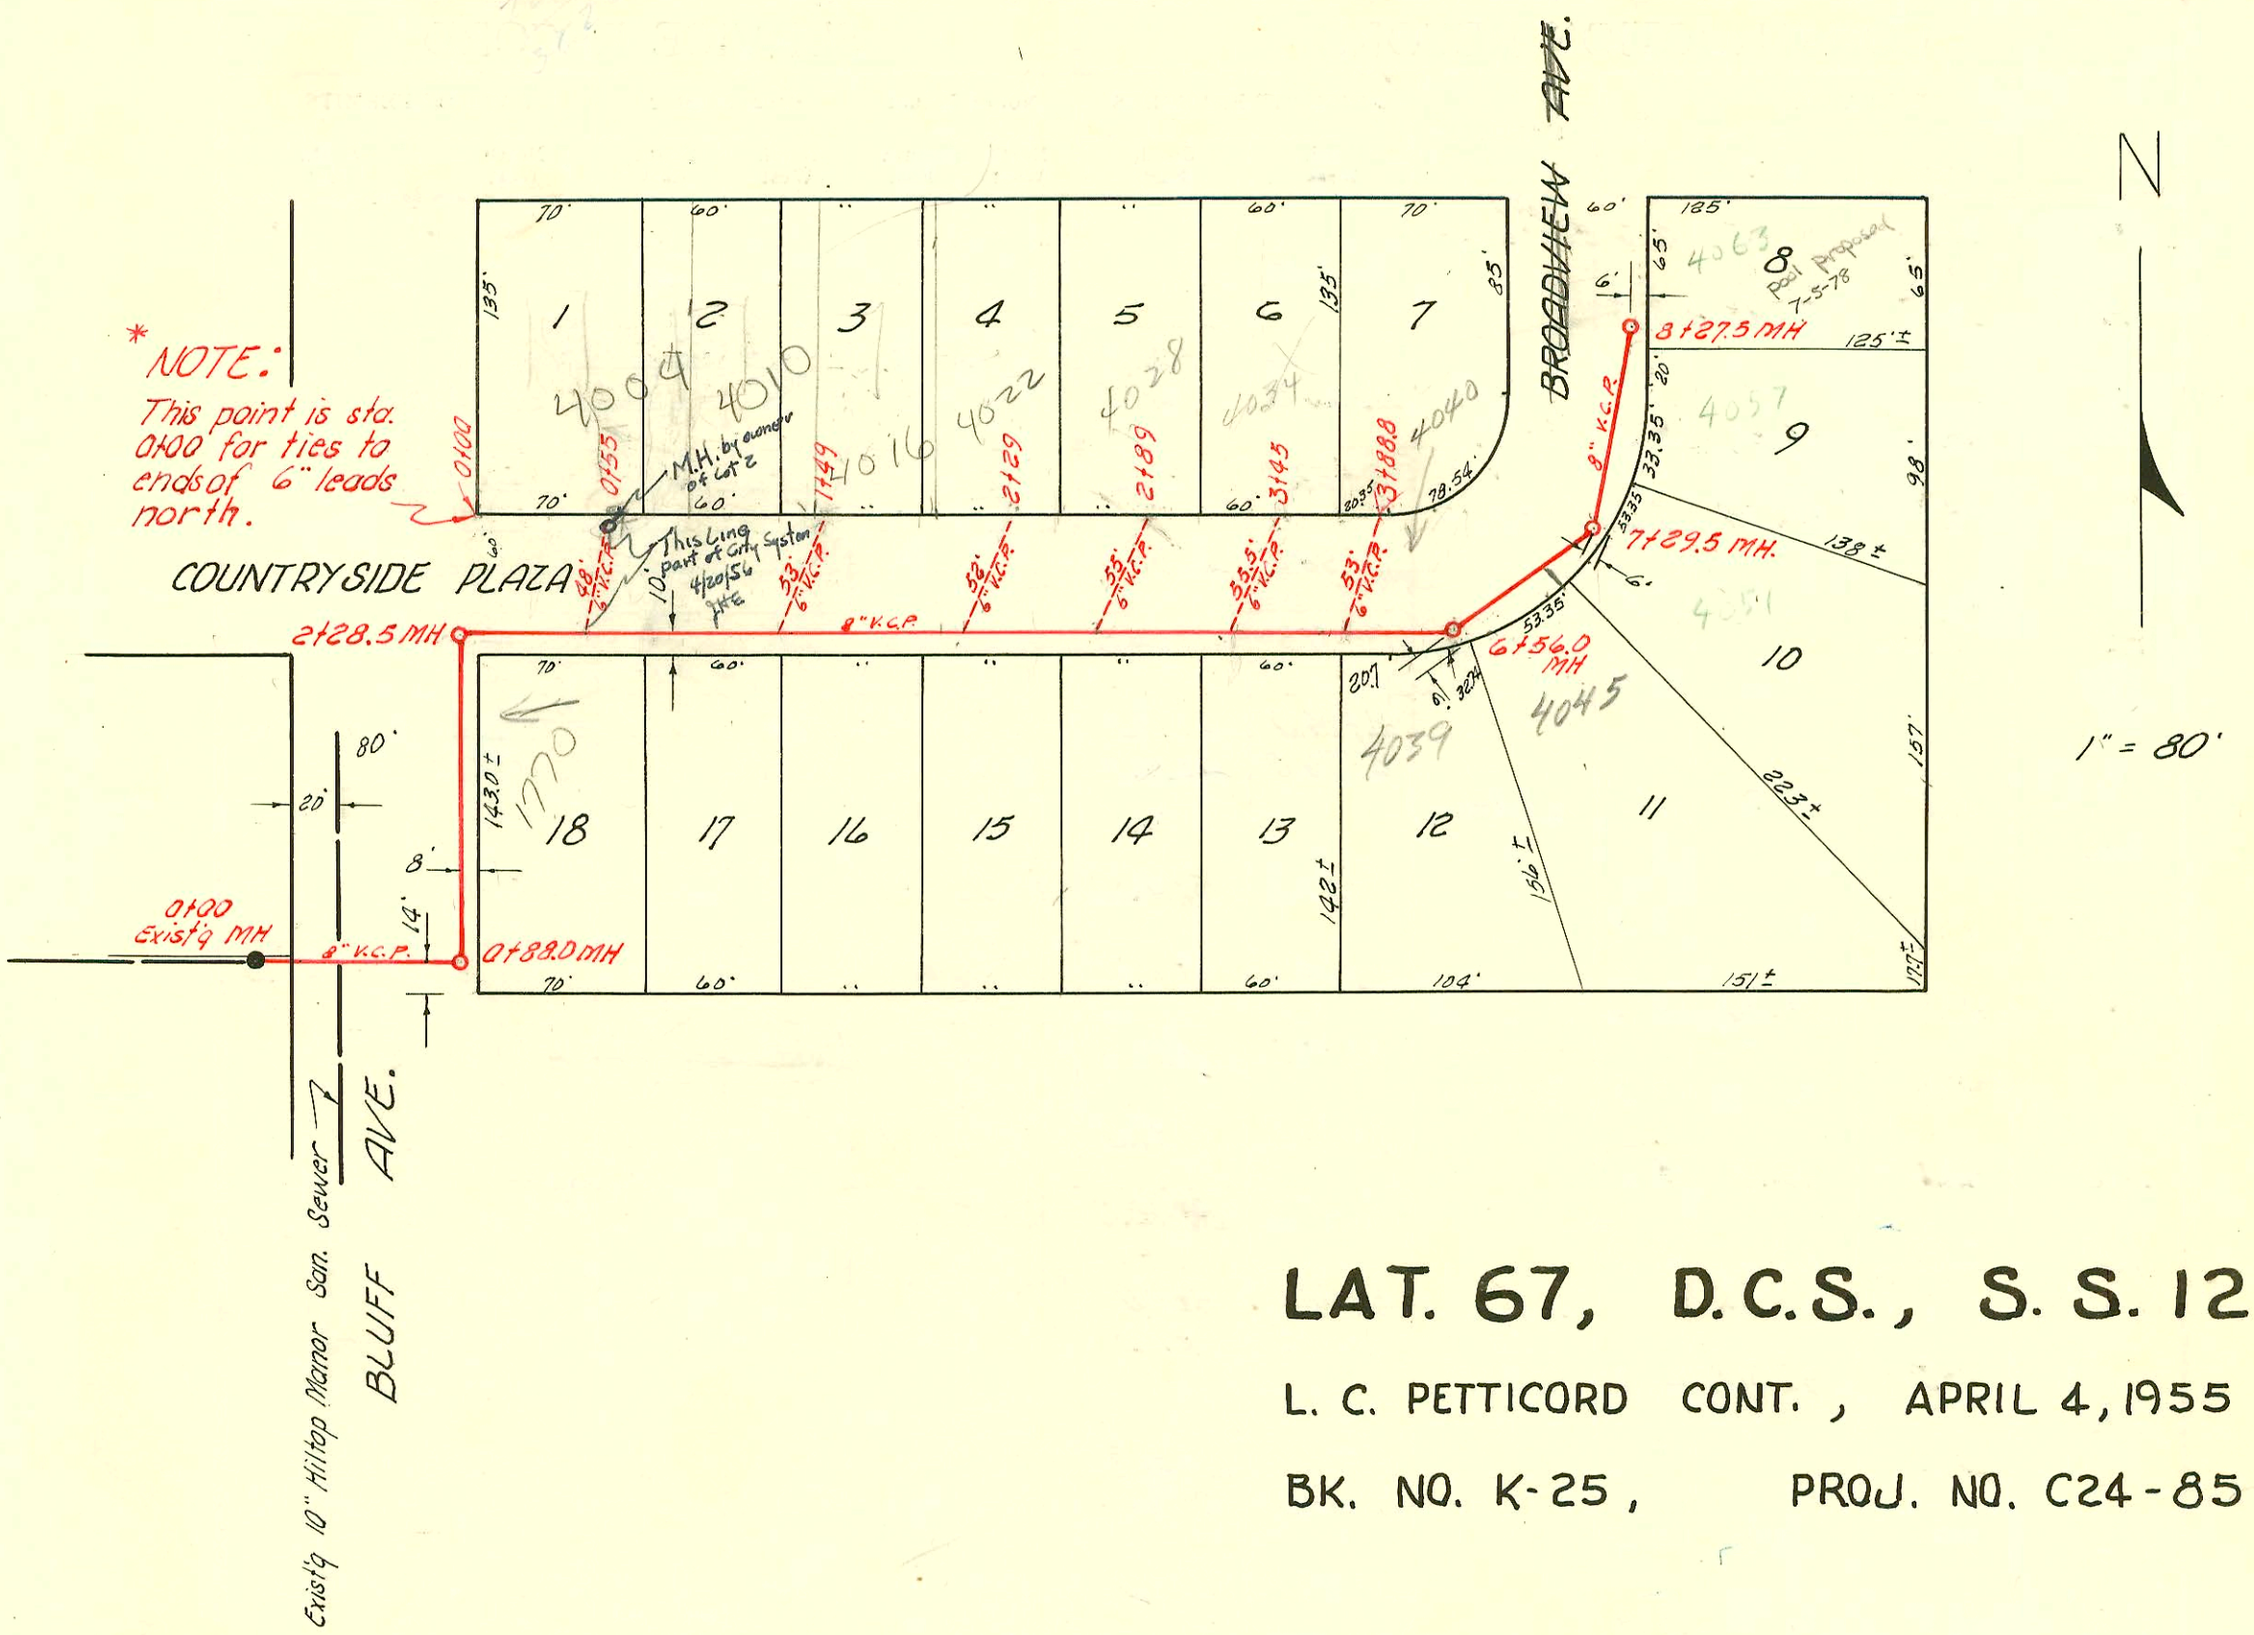

LAT. 67, D.C.S., S.S. 12

L. C. PETTICORD CONT., APRIL 4, 1955

BK. NO. K-25, PROJ. NO. C24-85

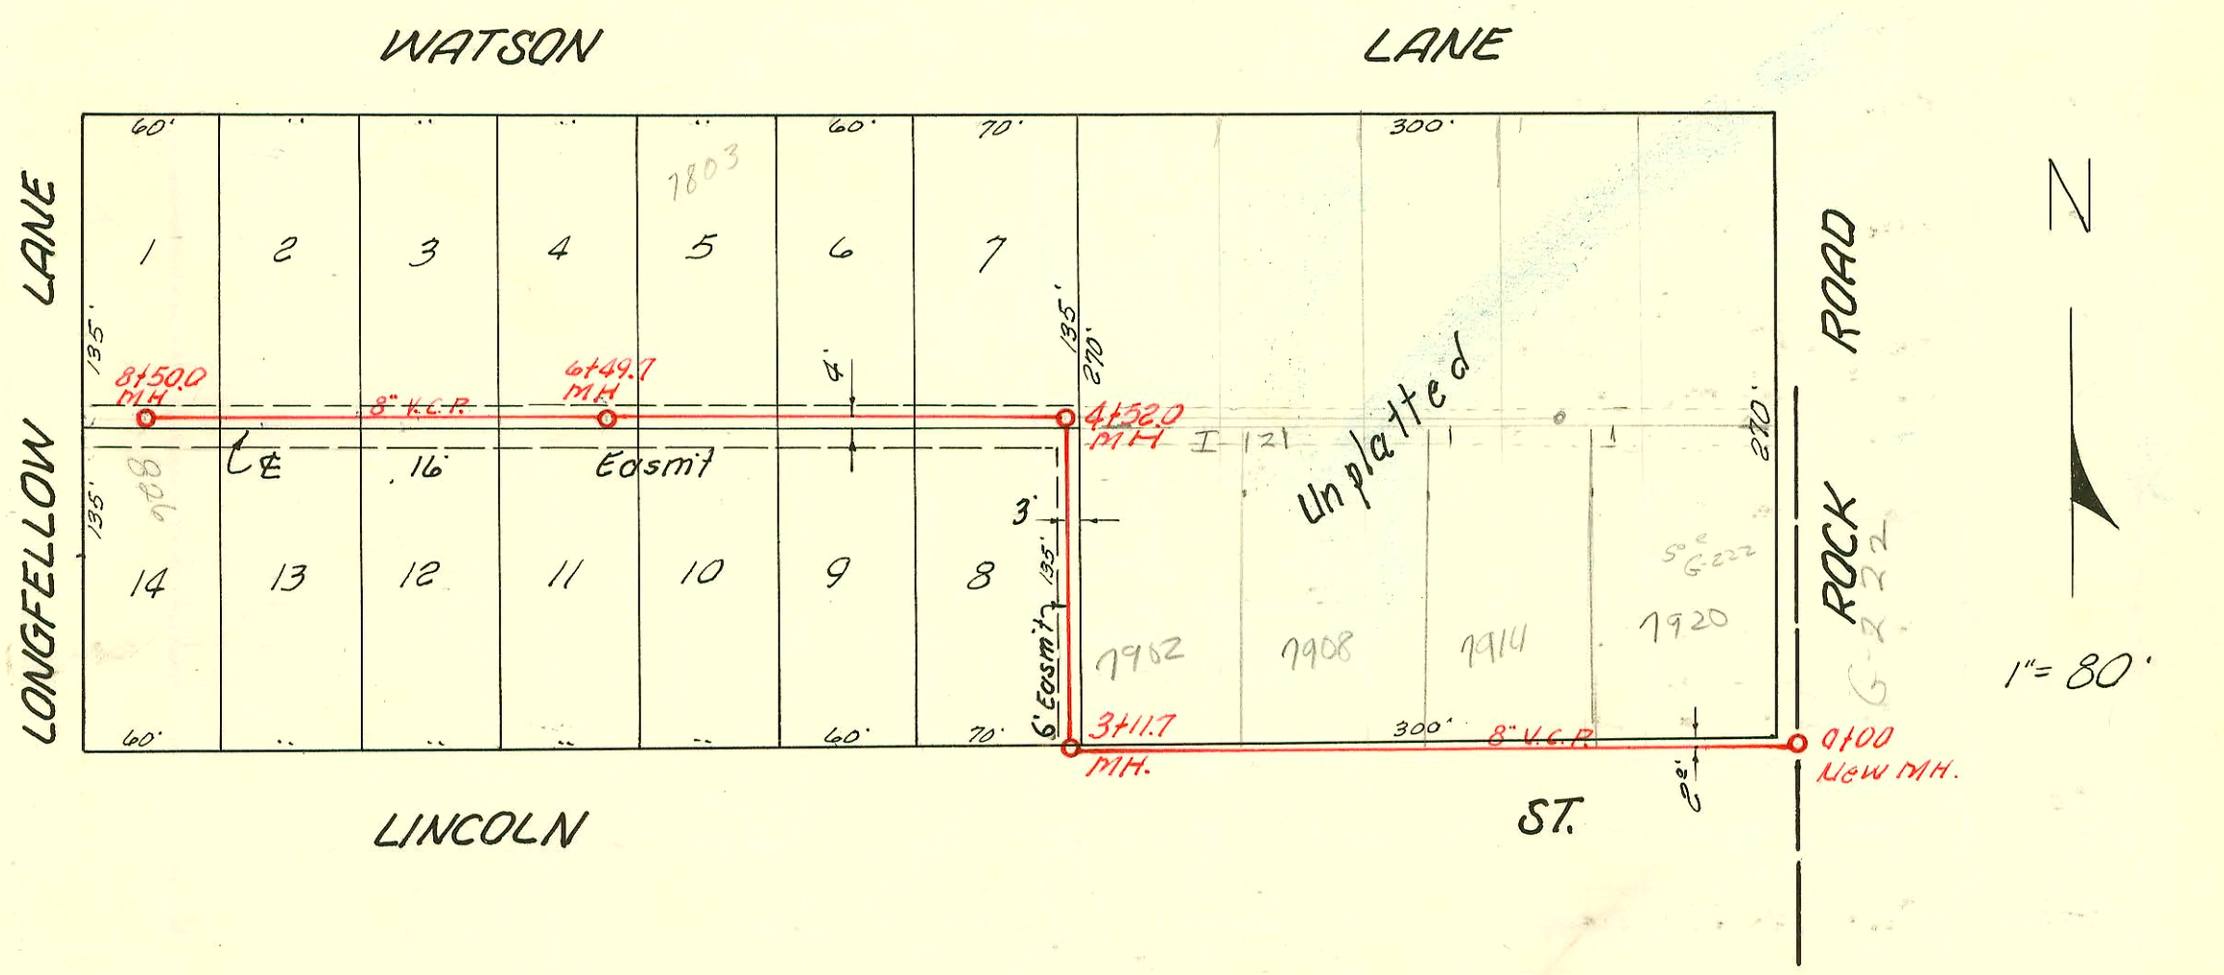

LAT. 7, SUBMAIN 7, W. I. S.

W. B. CARTER CONST. CO. INC. JUNE 29, 1955

BK. K-23, PROJ. NO. C25-3

Form 41-(54) 8-53

CONSTRUCTION RECORD / SERVICE RECORD

STATION	ELEVATION Ground	ELEVATION Grade	Depth	MANHOLE	4-INCH "Y" BRANCHES North ~~West~~	4-INCH "Y" BRANCHES ~~South~~ East	No. of Permit North West	No. of Permit South East	House Number North West	House Number South East	DATE OF PERMITS North West	DATE OF PERMITS South East
0+0	140.6	130.28	10.3	0+00 Existing MH								
	138.2	130.37 Out / 130.47 In	7.8 / 7.7	0+88.0								
1+0	138.3	130.48	7.8			1+72.0 TAP ~~1+11.0~~		23990		1770 S. Bluff Repair		10-2-89
2+0	139.1	130.58	8.5		6" Leads No.							
	139.5	130.71	8.8	2+28.5	* 2+82.5	SOUTH	#4518		4004 Countryside		4-13-55	
3+0	138.5	130.78	7.7			3+62.5		#6296		4009 Countryside		9-12-55
					* 3+65.0		#1400		4016 Countryside		9-10-56	
4+0	138.9	130.88	8.0			4+20.5		#4519		4015 Countryside		4-13-55
					* 4+45.0							
						4+75.5						
5+0	138.2	130.98	7.2		* 5+03.0		#5807		4021 Countryside Rep.		9-28-55	
						5+40.5		#4520		4027 Countryside		4-13-55
					* 5+61.5		#523		4034 Countryside		4-16-56	
						5+95.5		1184		4033 Countryside		6-20-56
6+0	135.5	131.08	4.4									
					* 6+10.5		#2458		4040 Countryside		9-20-56	
						6+47.0		#4996		4039 Countryside		6-1-55
	134.0	131.13	2.9	6+56.0								
7+0	135.1	131.18	3.9									
						7+03.0		#4221		4045 Countryside		4-13-55
						7+09.0		2900-01412 #4222		~~1776 S. Broadway~~ 4051 C.H.Ct.		6-14-00 - install CO 4-13-55 ~~4-8-66~~
	134.5	131.21	3.3	7+29.5		EAST 7+61.0						
8+0	135.4	131.28	4.1									
						8+10.5		#1025		4057 Country ~~4750 S. Sale Ct.~~ Broadview		4-8-66 6-7-56
	135.9	131.31	4.6	8+27.5								
					NORTH	SOUTH						
0+00	144.2	135.00	9.2	0+00 New MH	6" wye 0+37.0							
1+0	144.8	136.00	8.8		6" wye 1+09.7							
					6" wye 1+76.5							
2+0	146.0	137.00	9.0		6" wye 2+63.5							
3+0	146.70	138.00	8.7									
	146.6	138.05 Out / 138.37 In	8.5 / 8.2	3+11.7								
4+0	147.5	139.20	8.3		— 4" Wyes —							
	147.9	139.72 Out / 139.86 In	8.2 / 8.0	4+52.0								
					4+65.0	4+68.0	#6098-5-4-6		7815 Watson		8-22-55	
5+0	148.2	140.40	7.8									
					5+37.0	5+40.0	#6097	5914	7808 Watson	7808 Lincoln	8-22-55	8-3-55
					5+97.3		#6096		7803 Watson		8-22-55	
6+0	151.8	141.40	10.4									
						6+00.3		#5913		7802 Lincoln		8-3-55
	153.8	141.90 Out / 144.00 In	11.9 / 9.8	6+49.7								
					6+56.5	6+59.5		#5912	7721 Watson	7820 Lincoln	8-22-55	8-3-55
7+0												
					7+17.5	7+20.5	#6094	#5911	7715 Watson	7714 Lincoln	8-22-55	8-3-55
					7+80.0	7+83.0	#6093	5910	7709 Watson	7708 Lincoln	8-22-55	8-3-55
8+0	156.6	145.50	11.1									
					8+34.5	8+37.5		#5909		736 Longfellow		8-3-55
	157.8	146.00	11.8	8+50.0								

R #23990 1770 S. Bluff - Henning 10-2-89

#5712 - Tap - 1720 S. Lincoln - Wichita Pltg. Co. - 8-3-55

#6092 - Tap - 8-18 Long Fellow - Wichita Pltg. Co. - 8-22-55

#5915 - Tap - 7814 E. Lincoln - Wichita Pltg. - 8-3-55

#5497 - Sewer - 4018 E. Country Side Plaza - Hauldin Pltg. - 4-18-56

* #5945 - ~~1764 S. Broadway~~ Tap - Hauldin - 10-15-56

4063 Countryside Ct. - change 4-8-66

#6775 - Tap - 1802 S. Bluff - Carter Plbg. - Heat. - 4-29-58 (School) MH 6+56 SE side