G274A

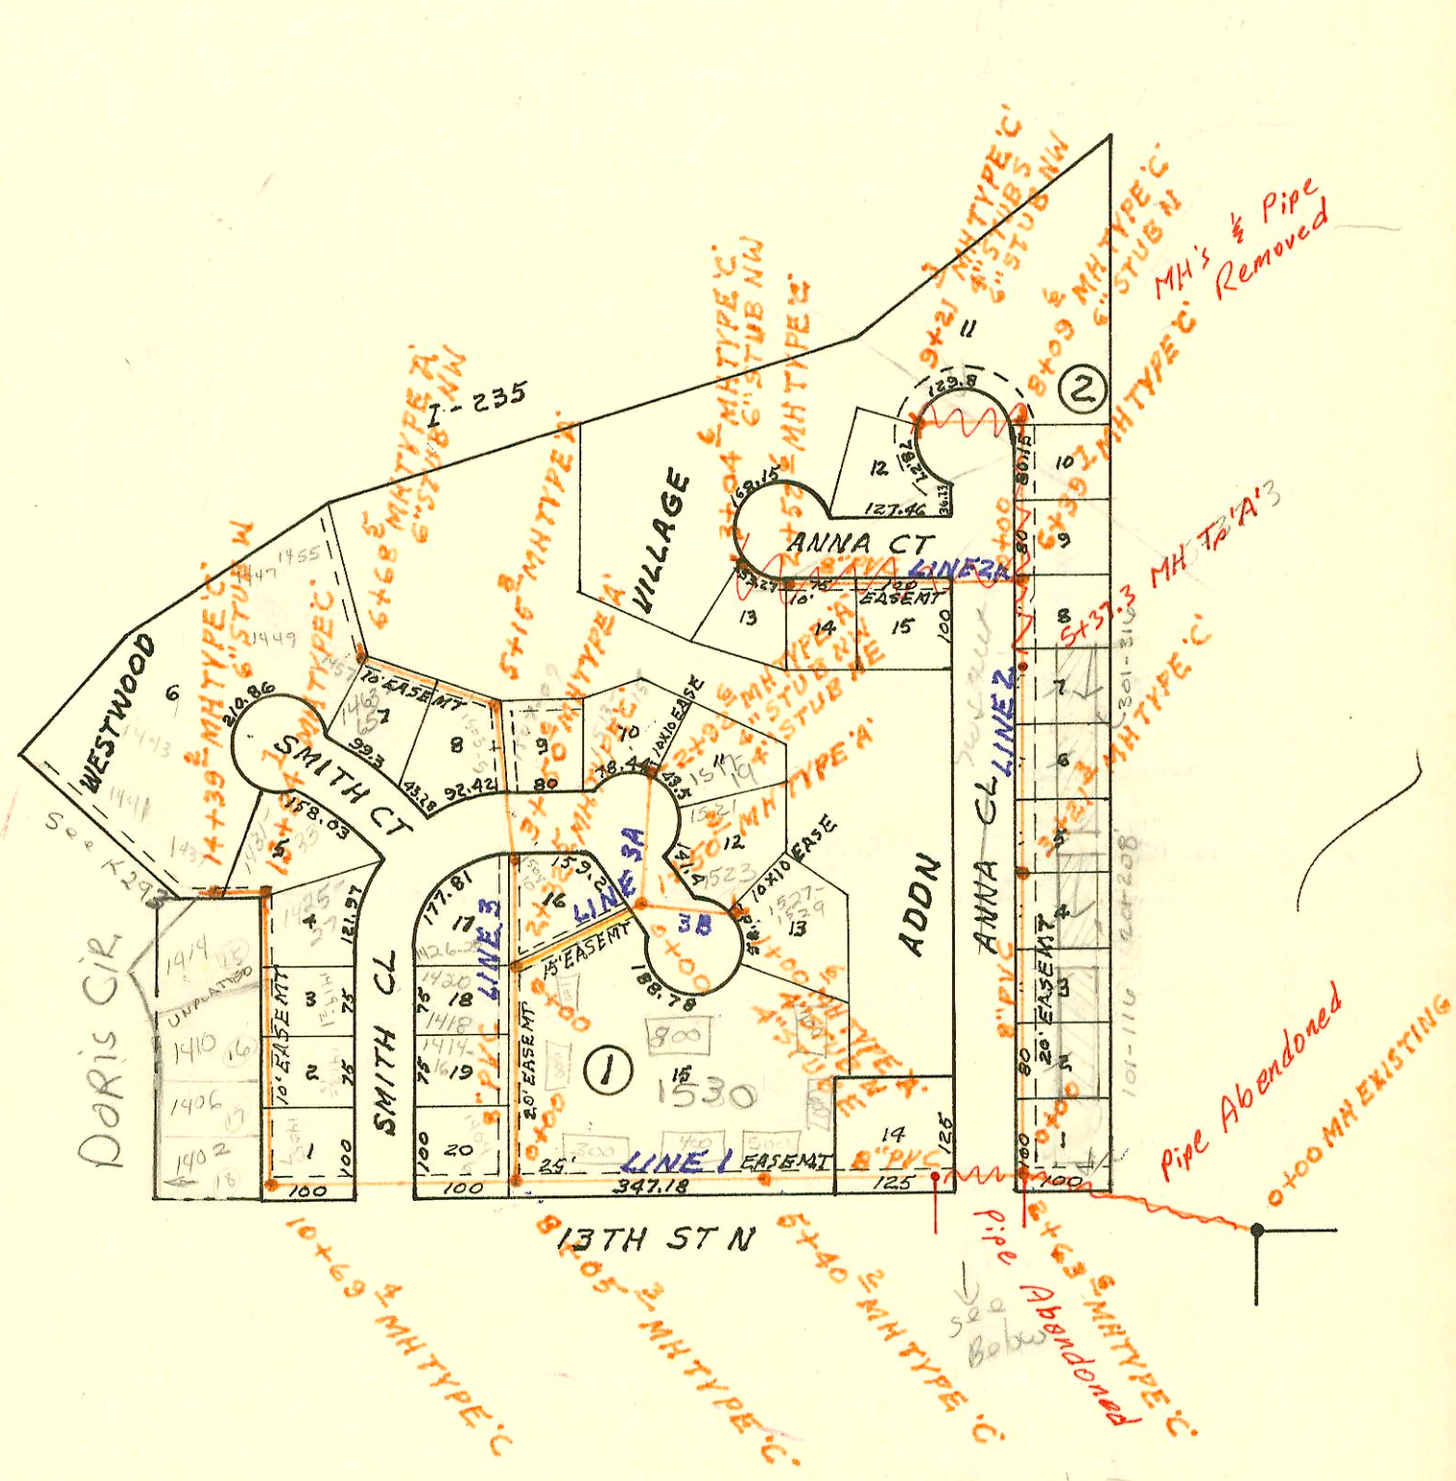

LATERAL 219 MAIN 5 SAN SEWER № 22
BUILT BY: WB CARTER CONST. CO.
PROJ. № 468-76-245-80174-000-000-001
BOOKED 3-14-81 FROM LES 24

on map

6-42

Sanitary Sewer Relocation in connection with Storm Water Sewer # 237 Phase I

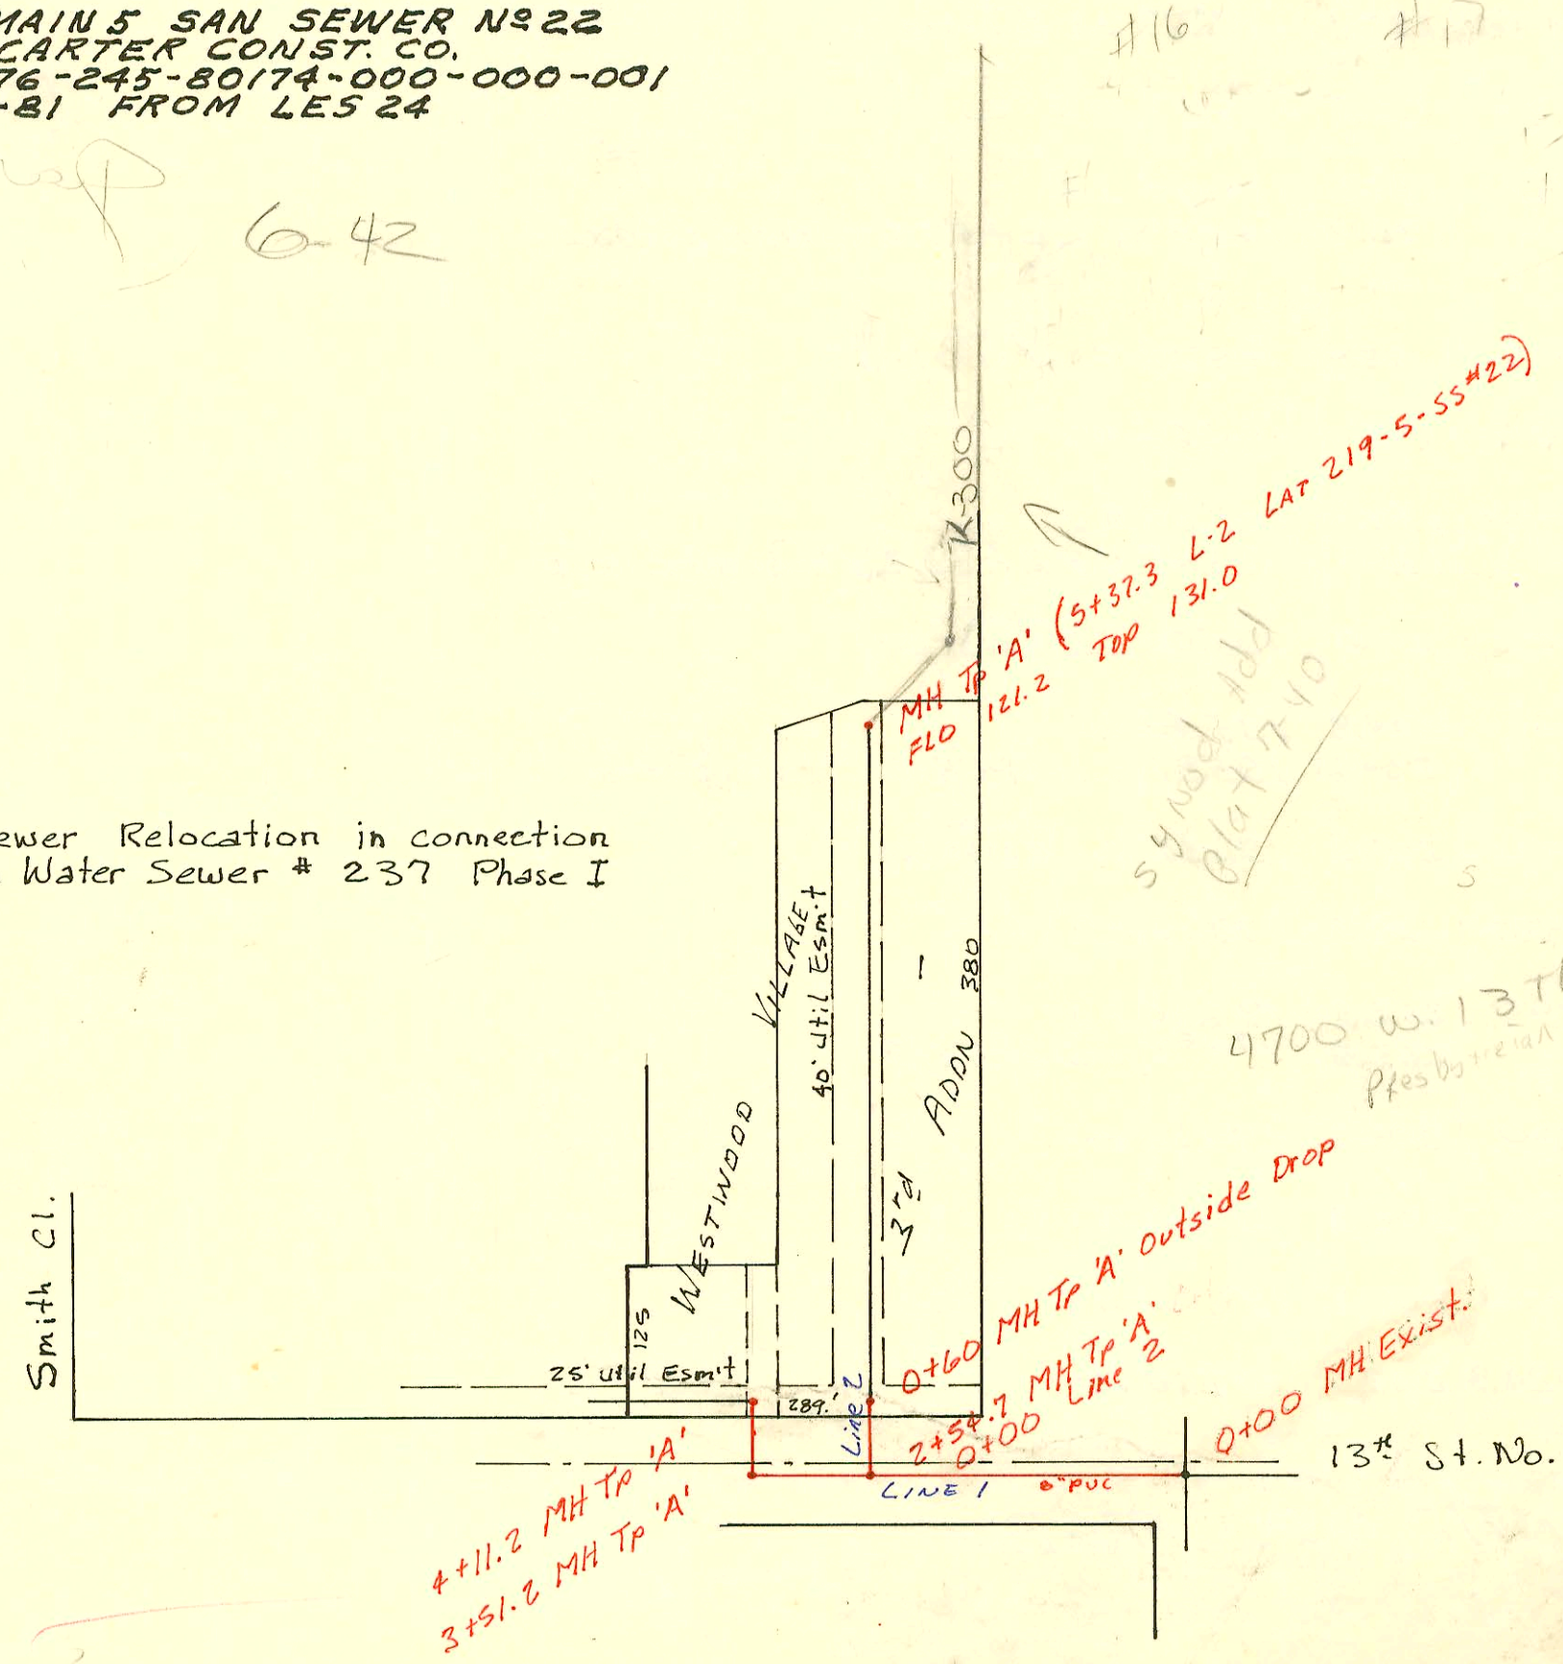

G274

Form 42-020

CONSTRUCTION RECORD							SERVICE RECORD					
STATION	ELEVATION Ground	ELEVATION Grade	Depth	MANHOLE	4-INCH "Y" BRANCHES North West	4-INCH "Y" BRANCHES South East	No. of Permit North West	No. of Permit South East	House Number North West	House Number South East	DATE OF PERMITS North West	DATE OF PERMITS South East
LAT 219 MAIN 5 55 Nº 22 (CONT'D)												
LINE 2 0+00	128.2	118.51	9.7	0+00=2+63.6 LINE 1								
						0+72.0 tag		12460		4800W 13 101-108		11-5-84
1+00	129.5	119.01	10.5									
						1+50.0 tag		12461		4800 W. 13th 109-116		11-5-84
2+00	131.7	119.51	12.2									
						2+71.3 tag		13430		4800 W 13th 200		4-10-85
3+00	131.4	120.01	11.4									
	131.2	120.12	11.1	3+21.3								
						3+88.3 tag		14566		301-308 4800W. 13th		8-22-85
4+00	130.5	120.51	10.0									
5+00	129.6	121.01	8.6									
						5+89.1 tag		14567		309-316		8-22-85
6+00	132.3	121.51	10.8									
	132.2	121.71	10.5	6+39.7								
7+00	132.2	122.01	10.1									
8+00	130.7	122.51	8.2									
	131.0	OUT 122.56 IN 122.66	8.4 8.3	8+09.6	6" STUB N							
9+00	133.1	123.11	10.0									
	132.2	123.22	9.0	9+21.3	6" STUB NW	4" STUB S						
LINE 2A 0+00	132.2	122.71	9.5	0+00=6+39.7 LINE 2								
1+00	133.2	123.21	10.0									
2+00	135.3	123.71	11.6									
	132.9	OUT 123.97 IN 124.07	8.9 8.8	2+52.6								
3+00	135.9	124.31	11.6									
	133.2	124.33	8.9	3+04.6	6" STUB NW							
LINE 3 0+00	133.7	120.09	13.6	0+00=8+05.3 LINE 1		0+44.0 tag		5912	1404-6 Smith Cl	1530-200 Smith Ch		5-24-82
					0+58.0 tag		6696				10-6-82	
1+00	132.2	120.59	11.6		1+27.5 tag	1+02.6 tag	3936	6486	1414-16 Smith	1530-200 Smith	8-17-81	4-5-83
						1+95.5 tag		5911		1530 Smith Ch 100		5-24-82
2+00	132.0	121.09	10.9									
	132.0	121.25	10.8	2+32.5			11555		1418-20 Smith		7-23-84	
3+00	132.0	121.59	10.4							1508-10 Smith Cl.		
	131.7	OUT 121.84 IN 121.94	9.9 9.8	3+50.0	3+83.0		17201	9873	1426-28 N. Smith		10-27-86	12-13-83
4+00	131.5	122.19	9.3		4+26.0 tag	4+66.8	9874	10175	1503-5 Smith Cl	1509-77 Smith Ch	12-13-83	2-13-84
						4+70.8 tag		8521		1509-77 Smith Ch		6-27-83
5+00	126.0	122.69	3.3									
	126.2	OUT 122.77 IN 122.87	3.4 3.3	5+15.8								
					6+04.5 tag		21425		1463 N Smith St		9-2-88	
6+00	126.6	123.29	3.3		6+29.5 tag		21461		1465 N Smith Ct		9-12-88	
	128.0	123.63	4.4	6+68.5	6" STUB NW		5913		1455 Smithet		5-24-82	
					mH Tag		5914		1457 Smith Ct		5-24-82	
LINE 3A 0+00	132.0	121.33	10.7	0+00=2+32.5 LINE 3								
1+00	132.7	121.83	10.9									
	131.9	OUT 122.08 IN 122.18	9.8 9.7	1+50.2								
2+00	133.1	122.43	10.7									
	131.7	122.89	8.8	2+92.6	4" STUB NW OK	4" STUB NE OK	13138	21971	1513-15 N. Smith	1517-19 Smith	3-4-85	10/24/88
LINE 3B 0+00	131.9	123.50	8.4	0+00=1+50.2 LINE 3A								
1+00	132.7	124.00	8.7	1+00.6	4" STUB N OK	4" STUB E OK	11113	14842	1521-23 Smith	1527-29 Smith	6-6-84	10-15-85

San. Sewer Relocation in conn. with SWS # 237 Phase I

Line 1	0+00	126.30	111.94	14.4	Exist. 0+00
	1+00		112.34		
	2+00		112.74		
		127.57	112.96 OUT 113.06 IN	14.6	2+54.7
	3+00		113.51		
		128.27	114.03 OUT 114.13 IN	14.2	3+51.2
	4+00		114.62		
		129.4	114.73 OUT	15.2	4+11.2
Line 2	0+00	127.57	113.06	14.5	2+54.7 L-1 0+00
		128.4	113.30 OUT 113.51 IN	15.1	0+60