


GLENN AVE.

100'	1	100'	60
	2		59
	3		58
	4		57
	5		56
100'	6		55
	7		54
	8		53
	9		52
	10		51
	11		50
	12		49
	13		48
	14		47
	15		46
	16	10+01.5 MH	45
	17		44
	18		43
	19		42
	20		41
	21		40
	22		39
	23		38
	24		37
	25		36
	26		35
	27		34
	28	7+51.0 MH	33
	29		32
100'	30	100'	31

ORIENTA

100'	1	100'	60
	2		59
	3		58
	4		57
	5		56
	6		55
	7		54
	8	5+00.0 MH	53
	9		52
	10		51
	11		50
	12		49
	13		48
	14		47
	15		46
	16		45
	17		44
	18		43
	19		42
	20		41
	21	2+50.5 MH	40
	22		39
	23		38
	24		37
	25		36
	26		35
	27		34
	28		33
	29		32
100'	30	5' 100'	31

BENNETT AVE. 5' 100' Scaled 0100 Existg MH

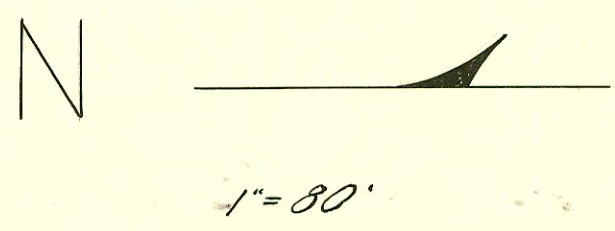

LAT. 14, SUB. 3, S. S. 22

W. B. CARTER CONST. CO. INC., SEPT. 10. 1955

BK. NO. K-24

PROJ. NO. C25-55

CONSTRUCTION RECORD						SERVICE RECORD						
STATION	ELEVATION		Depth	MANHOLE	4-INCH "Y" BRANCHES		No. of Permit		House Number		DATE OF PERMITS	
	Ground	Grade			North West	South East	North West	South East	North West	South East	North West	South East
0+0	99.3	92.64	6.7	0+00 EXIST'G MH	0+71.5	0+74.5		# 7007		2060 Dallas		12-7-55
1+0	98.3	92.84	5.5		1+10.5	1+13.5						
					1+53.0	1+56.0						
					1+85.0	1+88.0						
2+0	99.0	93.04	6.0		2+34.0	2+37.0						
	99.0	93.14	5.9	2+50.5	2+70.5	2+73.5						
3+0	99.1	93.24	5.9		3+07.0	3+10.0						
					3+54.0	3+51.0						
					3+71.0	3+77.0						
4+0	98.8	93.44	5.4		3+93.0	4+31.0	4989	710	2637 Crawford	3036 Dallas	8-12-57	5-8-56
					4+71.0	4+74.0						
5+0	98.9	93.64	5.3	5+00.0	5+12.0	5+15.0						
					5+51.5	5+54.5						
					5+87.0	5+90.0						
6+0	99.0	93.84	5.2		6+33.0	6+36.0						
7+0	98.8	94.04	4.8		7+31.5	7+34.5						
	98.8	94.14	4.7	7+51.0	7+70.0	7+73.0						
8+0	98.9	94.24	4.7		8+12.5	8+15.5						
					8+53.0	8+56.0	#942		1947 Crawford		5/31/56	
					8+94.0	8+97.0						
9+0	99.0	94.44	4.6		9+21.0	9+32.0	4766		1937 Crawford	872 Dallas	7-5-57	
					9+79.0	9+82.0		10228				7-16-57
10+0	98.7	94.64	4.1	10+01.5	10+12.0	10+15.0						
					10+51.0	10+39.5	1081		1933 Crawford		6-11-56	
					10+94.0	10+69.0		#9900		1904 Dallas		10-26-56
11+0	98.7	94.84	3.9		11+27.0	11+30.0						
					11+70.0	11+73.0						
12+0	98.6	95.04	3.6		12+12.5	12+24.5	10885 Seal Off		1911 Crawford		7-17-59	
					12+54.0	12+57.0	7189				6-10-58	
					12+79.5	12+79.5		4663		1906 Dallas		6-3-57
	99.2	95.22	4.0	12+92.0	(4" Stub NE)		#6650	1604	8552 Dallas		10-11-56	10-3-55