H 12A

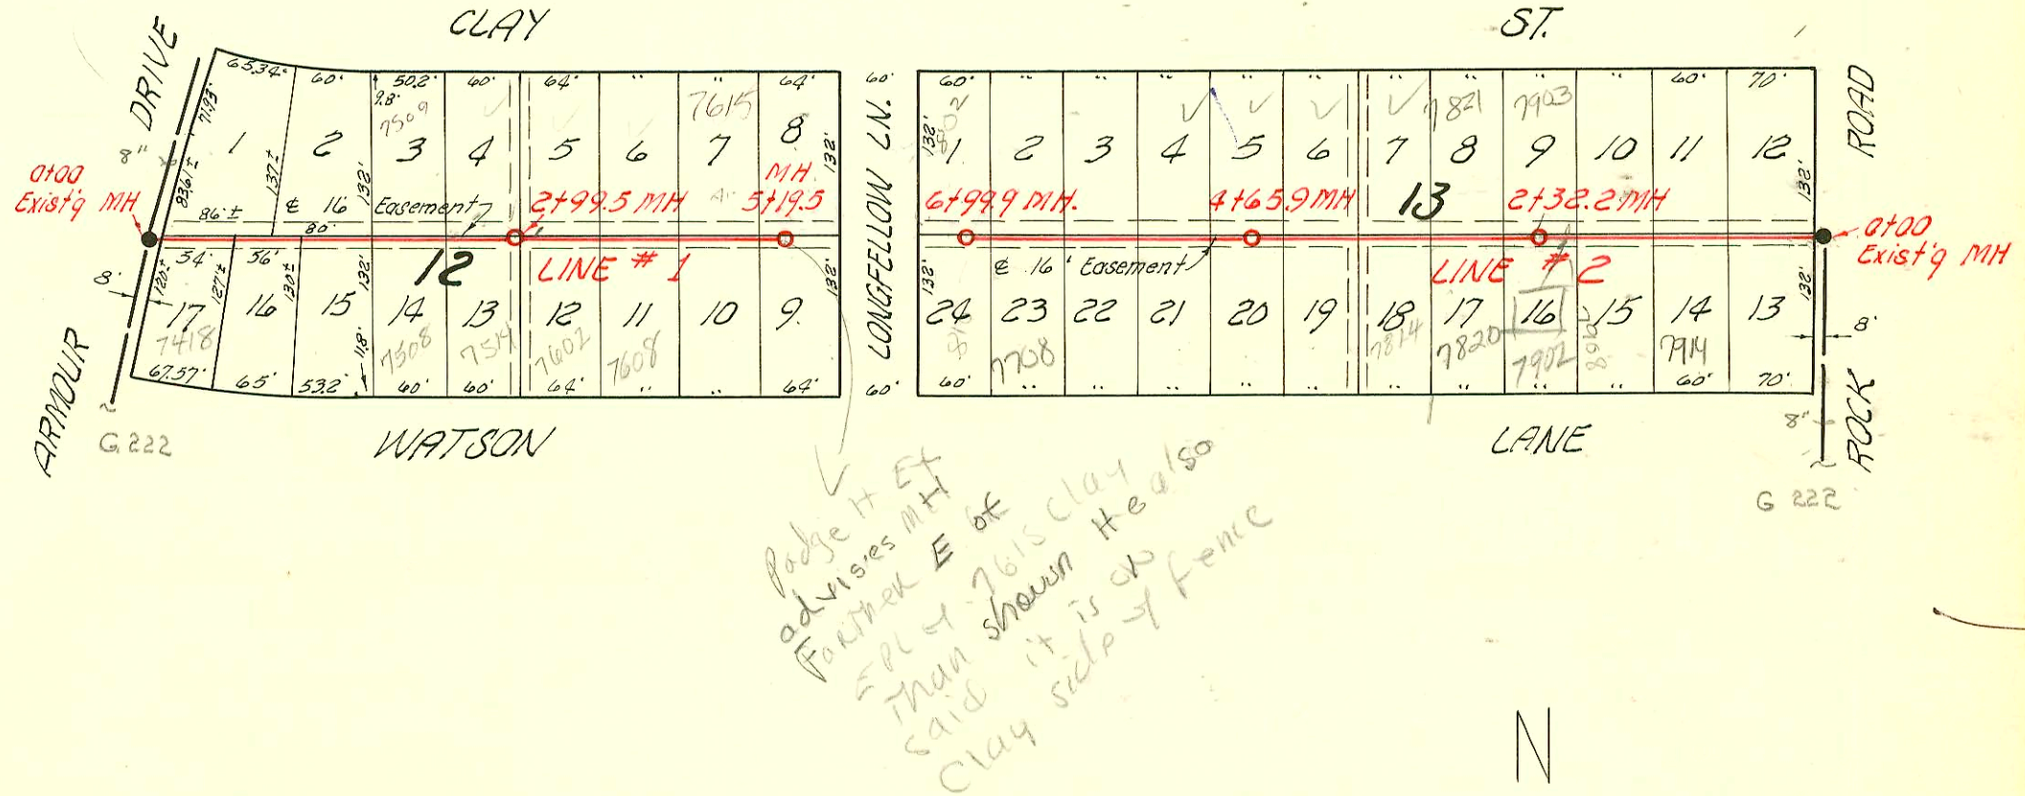

2001-00858- 4/11/01- 7615 Clay- Padgett EX- 4" SCH 40 - 4" Predco
94.2' W of MH 5+19.5 (4+25.3) - 1 TWIN CO, 2V45, Fernco to CI @ house

1" = 150'

LAT. 5, SUBMAIN 7, W. I. S.

W. B. CARTER CONST. CO. INC., MARCH 9, 1955

BK. NO. K-18 PROJ. NO. C 24-68

Form 41-(54) 8-58

CONSTRUCTION RECORD

	STATION	ELEVATION Ground	ELEVATION Grade	Depth	MANHOLE	6"-INCH "Y" BRANCHES ~~North~~ West	6"-INCH "Y" BRANCHES ~~South~~ East
LINE #3	0+00	92.2	87.38	4.8	0+00 = 167185 in Line #1		
						0+32.6	
							0+51.0
							0+91.0
	1+0	93.4	87.48	5.9			1+21.0
		93.5	87.51	6.0	1+27.5		
						1+48.0	
							1+77.0
	2+0	93.0	87.58	5.4			
						2+37.4	2+34.4
							2+93.0
	3+0	93.5	87.68	5.8			
						3+04.0	
		93.8	87.69	6.1	3+12.0		
							3+53.0
						3+67.5	
	4+0	93.9	87.78	6.1			
							4+13.7
						4+28.5	
						4+74.0	4+71.0
		93.8	87.88	5.9	4+99.0		
						4" WYES NORTH	SOUTH
LINE #1	0+0	142.2	135.02	7.2	0+00 Existg MH.		
							0+17.8
						0+51.2	
							0+70.3
	1+0	143.2	136.02	7.2			
						1+18.8	1+21.8
						1+82.3	1+85.3
	2+0	145.6	137.02	8.6			
						2+38.6	~~2+41.6~~ 2+39.5
		147.4	138.02 out 140.02 in	9.4 7.4	2+99.5		
	3+0						
						3+05.0	3+08.0
						3+64.6	3+67.6
	4+0	151.3	142.02	9.3			
						4+25.3	4+28.3
						4+97.8	
	5+0	153.7	144.02	9.7			5+00.8
		154.4	144.42	10.0	5+19.5		
LINE #2	0+0	152.5	141.54	11.0	0+00 Existg MH.		
						0+28.4	0+31.4
						0+93.5	0+96.5
	1+0	152.7	141.94	10.8			
						1+53.8	1+56.8
	2+0	153.0	142.34	10.7			
						2+10.8	2+13.0
		153.8	142.47	11.3	2+32.2		
						2+73.4	2+76.4
	3+0	154.7	142.74	12.0			
						3+34.5	3+37.5
						3+89.5	3+92.5
	4+0	153.5	143.14	10.4			
						4+50.0	4+53.0
		153.7	143.40	10.3	4+65.9		
	5+0	154.8	143.74	11.1			
						5+12.7	5+15.7
						5+73.4	5+76.4
	6+0	157.3	144.74	12.6			
						6+34.1	6+37.1
						6+91.0	6+94.0
		157.9	145.74	12.2	6+99.9		

SERVICE RECORD

No. of Permit North West	No. of Permit South East	House Number North West	House Number South East	DATE OF PERMITS North West	DATE OF PERMITS South East
#4485		2838 S. Santa Fe		5-9-55	
	#3792		2859 S. Mead		3-8-55
	#3793		2851 S. Mead		3-8-55
	#3794		2849 S. Mead		3-8-55
#3823		2832 S. Santa Fe		3-17-55	
	#3795		2833 S. Mead		3-8-55
#3822	#3796 #3917	2822 S. Santa Fe	2827 S. Mead 2821 S. Mead	3-17-55	3-8-55 3-17-55
#3821		2822 S. Santa Fe		3-17-55	
	#3916		2815 S. Mead		3-17-55
#3820		2814 S. Santa Fe		3-17-55	
95-116617 #3915			2809 S.R. Mead		7-28-95 3-17-55
#3911-7 3919		2810 S.R. Santa Fe		3-17-55	
#3918	#3798 #3924	2802 S.R. Santa Fe	2803 S.R. Mead	3-17-55	4-7-83 3-17-55
#4424	#4423	7419 Clay	7418 Watson Lane R		4-22-55
	#4422		7424 Watson Lane	4-22-55	4-22-55
#4425	#4421	7503 Clay	7502 Watson Lane	4-22-55	4-22-55
#4426	#4420	7509 Clay R	7508 R Watson Lane	4-22-55	4-22-55
#4427	93-5065-7 #4419	7515 Clay	7514 R Watson Lane	4-22-55	4-10-92 4-22-55
#5229	93-11677-7 #4418	7603 Clay	7602 R Watson Lane	6-17-55	5-17-93 4-22-55
#5228	#4417	7609 Clay	7606 Watson Lane	6-17-55	4-22-55
2001560858 #5227 #5226	#4416	7615 Clay R 803 Longfellow	See next pg 7614 Watson Lane	6-17-55 6-17-55	4-11-01 4-22-55
	#4415		81 Longfellow		4-22-55
#5806	#4301	7921 Clay	7920 Watson Lane	7-28-55	4-18-55
#5807	#4302	7951 Clay	7914 Watson Lane	7-28-55	4-18-55
#5808	12871 #4303	7909 Clay	7908 S Watson Lane	7-28-55	12-27-84 4-18-55
93-1980-7 #5809	#4304	7903 Clay L	7902 Watson Lane	7-28-55	4-18-55
#5810		7821 Clay		7-28-55	
#5811	#4541	7815 Clay	7814 Watson	8-1-55	4-29-55
#5813	#4540	7809 Clay	7808 Watson	8-1-55	4-29-55
#5812	#4539	7803 Clay	7802 Watson	8-1-55	4-29-55
#5811	#4538	7721 Clay	7720 Watson	8-1-55	4-29-55
#5784	#4537	7715 Clay	7714 Watson	7-27-55	4-29-55
#5783	#4536	7709 Clay	7708 Watson	7-27-55	4-29-55
94-14538-7 #5782	#4535	807 R Longfellow	810 Longfellow	9-9-94 7-27-55	4-29-55

#20030 8-1-88 7820 E Watson LN - Buckley - Rep - ( )