H- 33A

Private S.S. for Rubottom Addn
Built By: Mid-States Const. Co.
Booked 17 May 1972 from SS. JK #6
Project No AAKB 502007

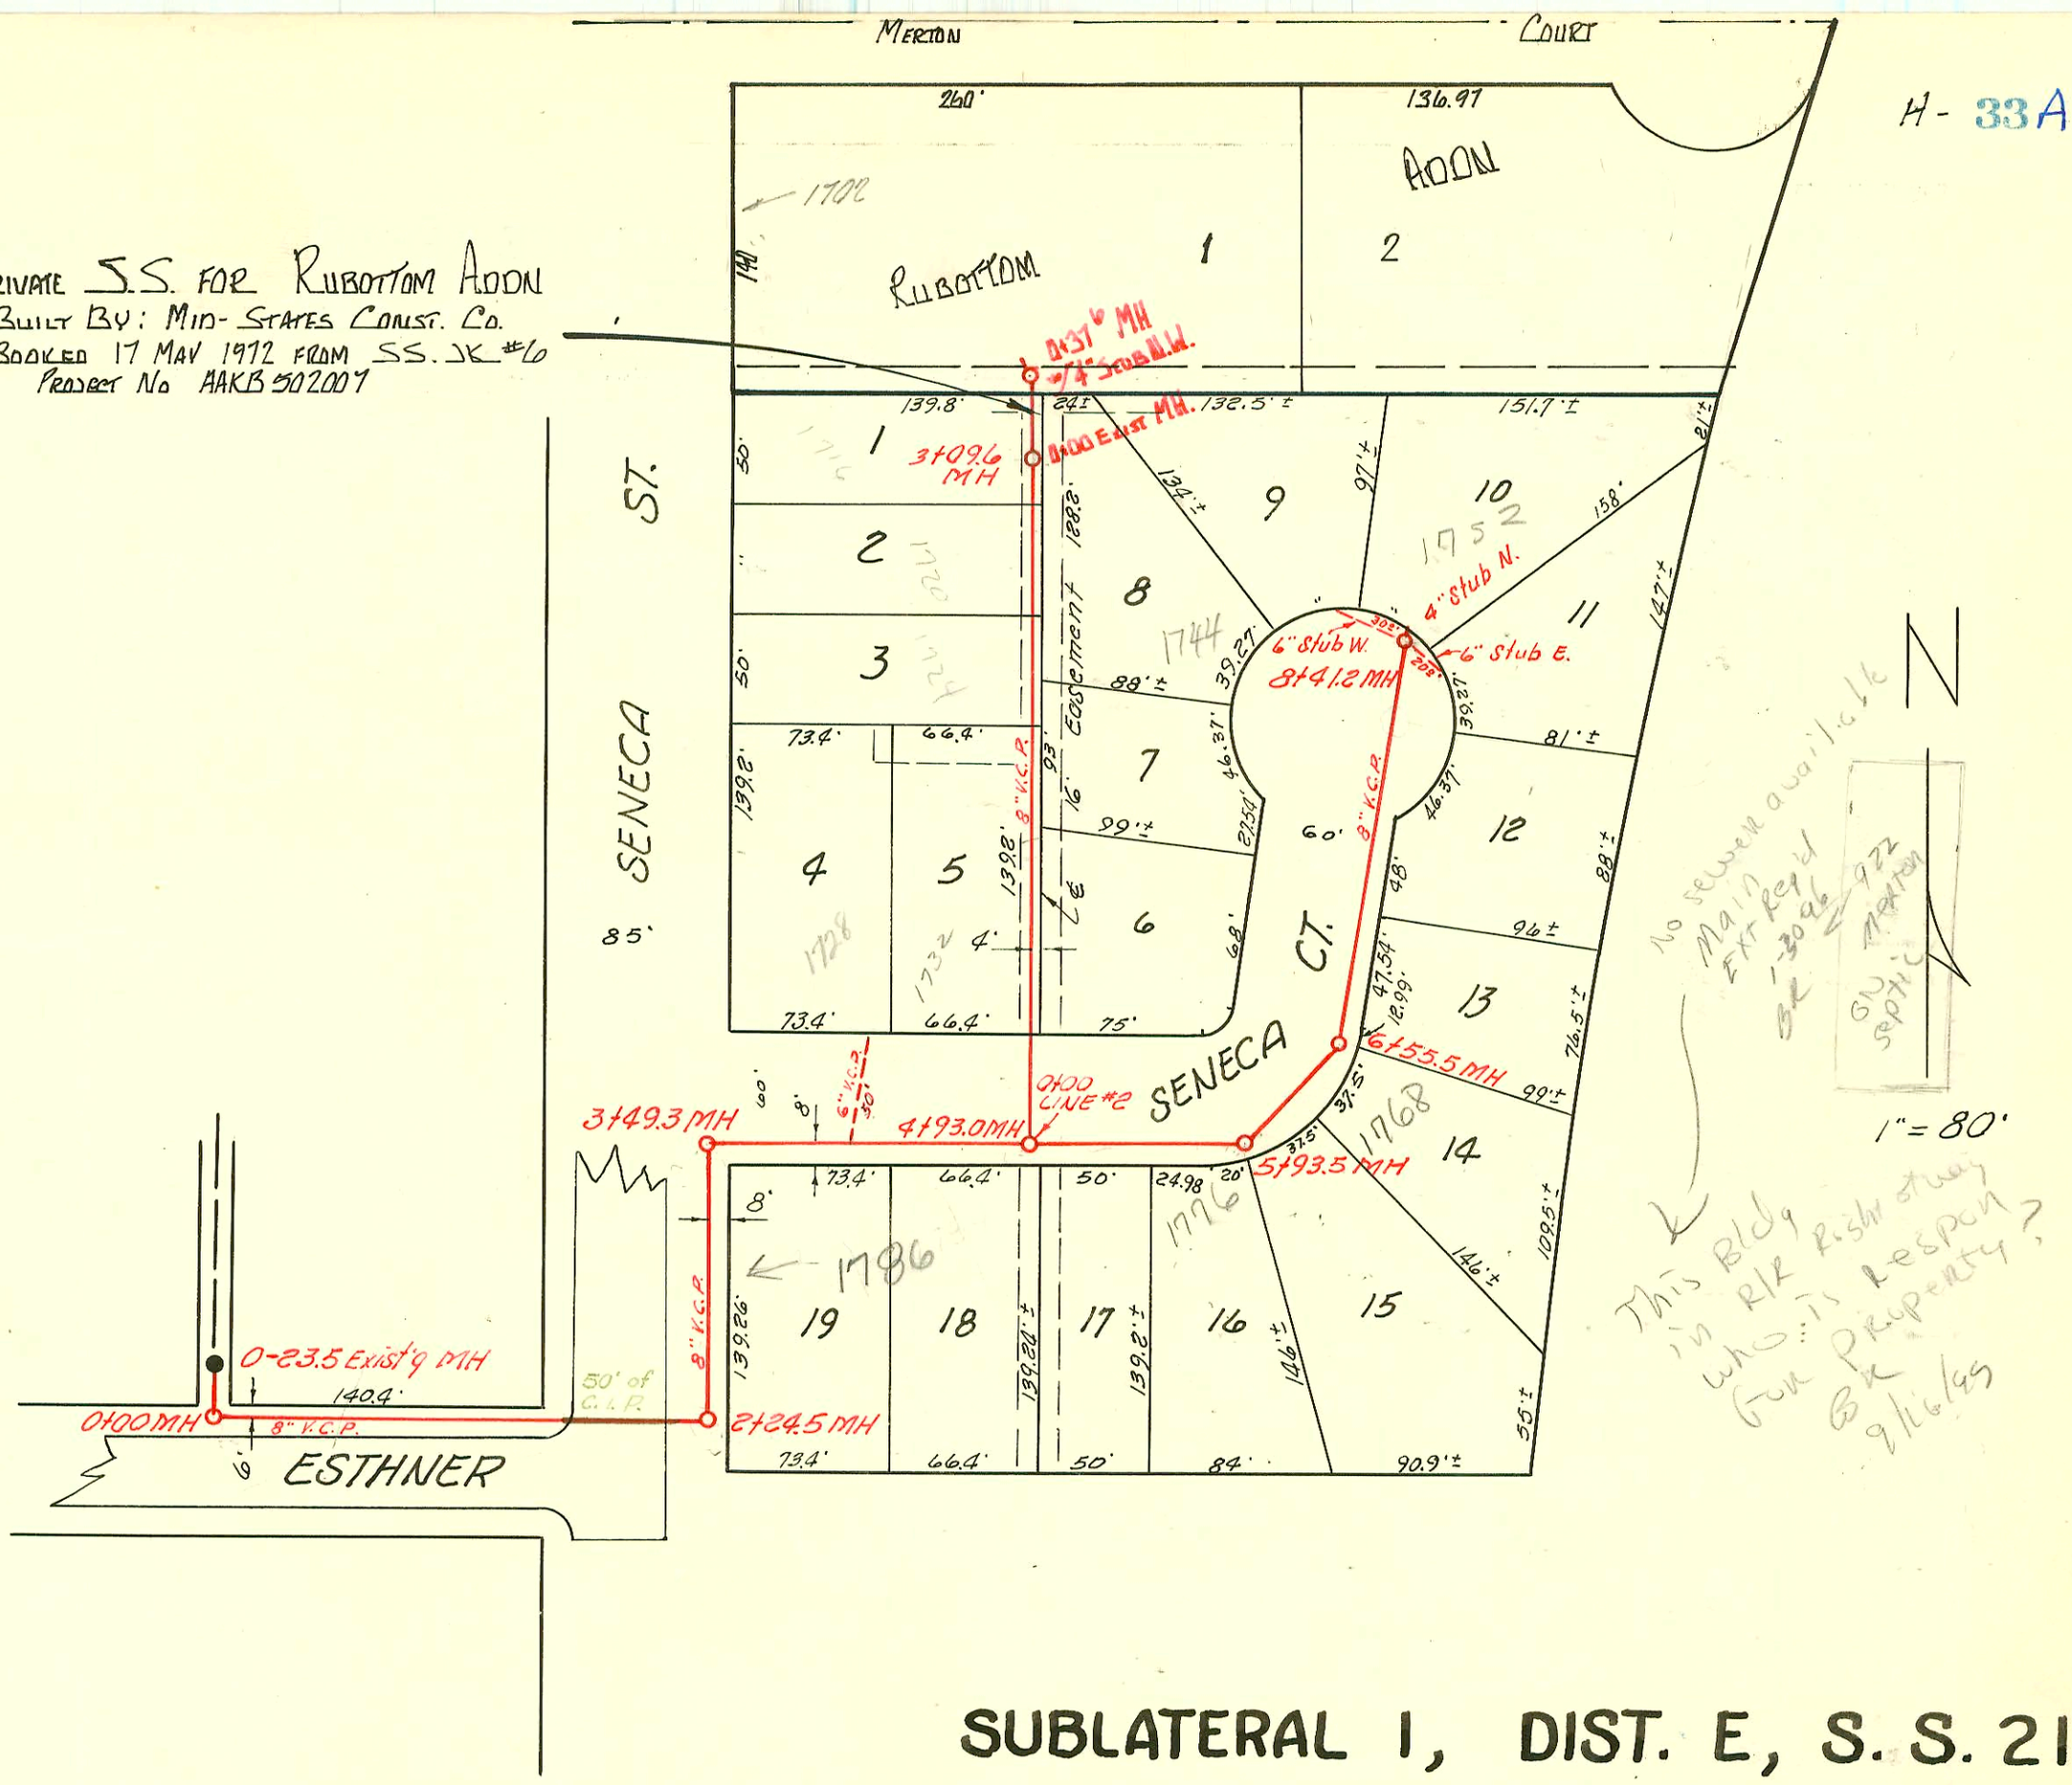

SUBLATERAL 1, DIST. E, S. S. 21

W. B. CARTER CONST. CO. INC., OCT. 10, 1955

BK. NO. K 28, PROJ. NO. C25-62

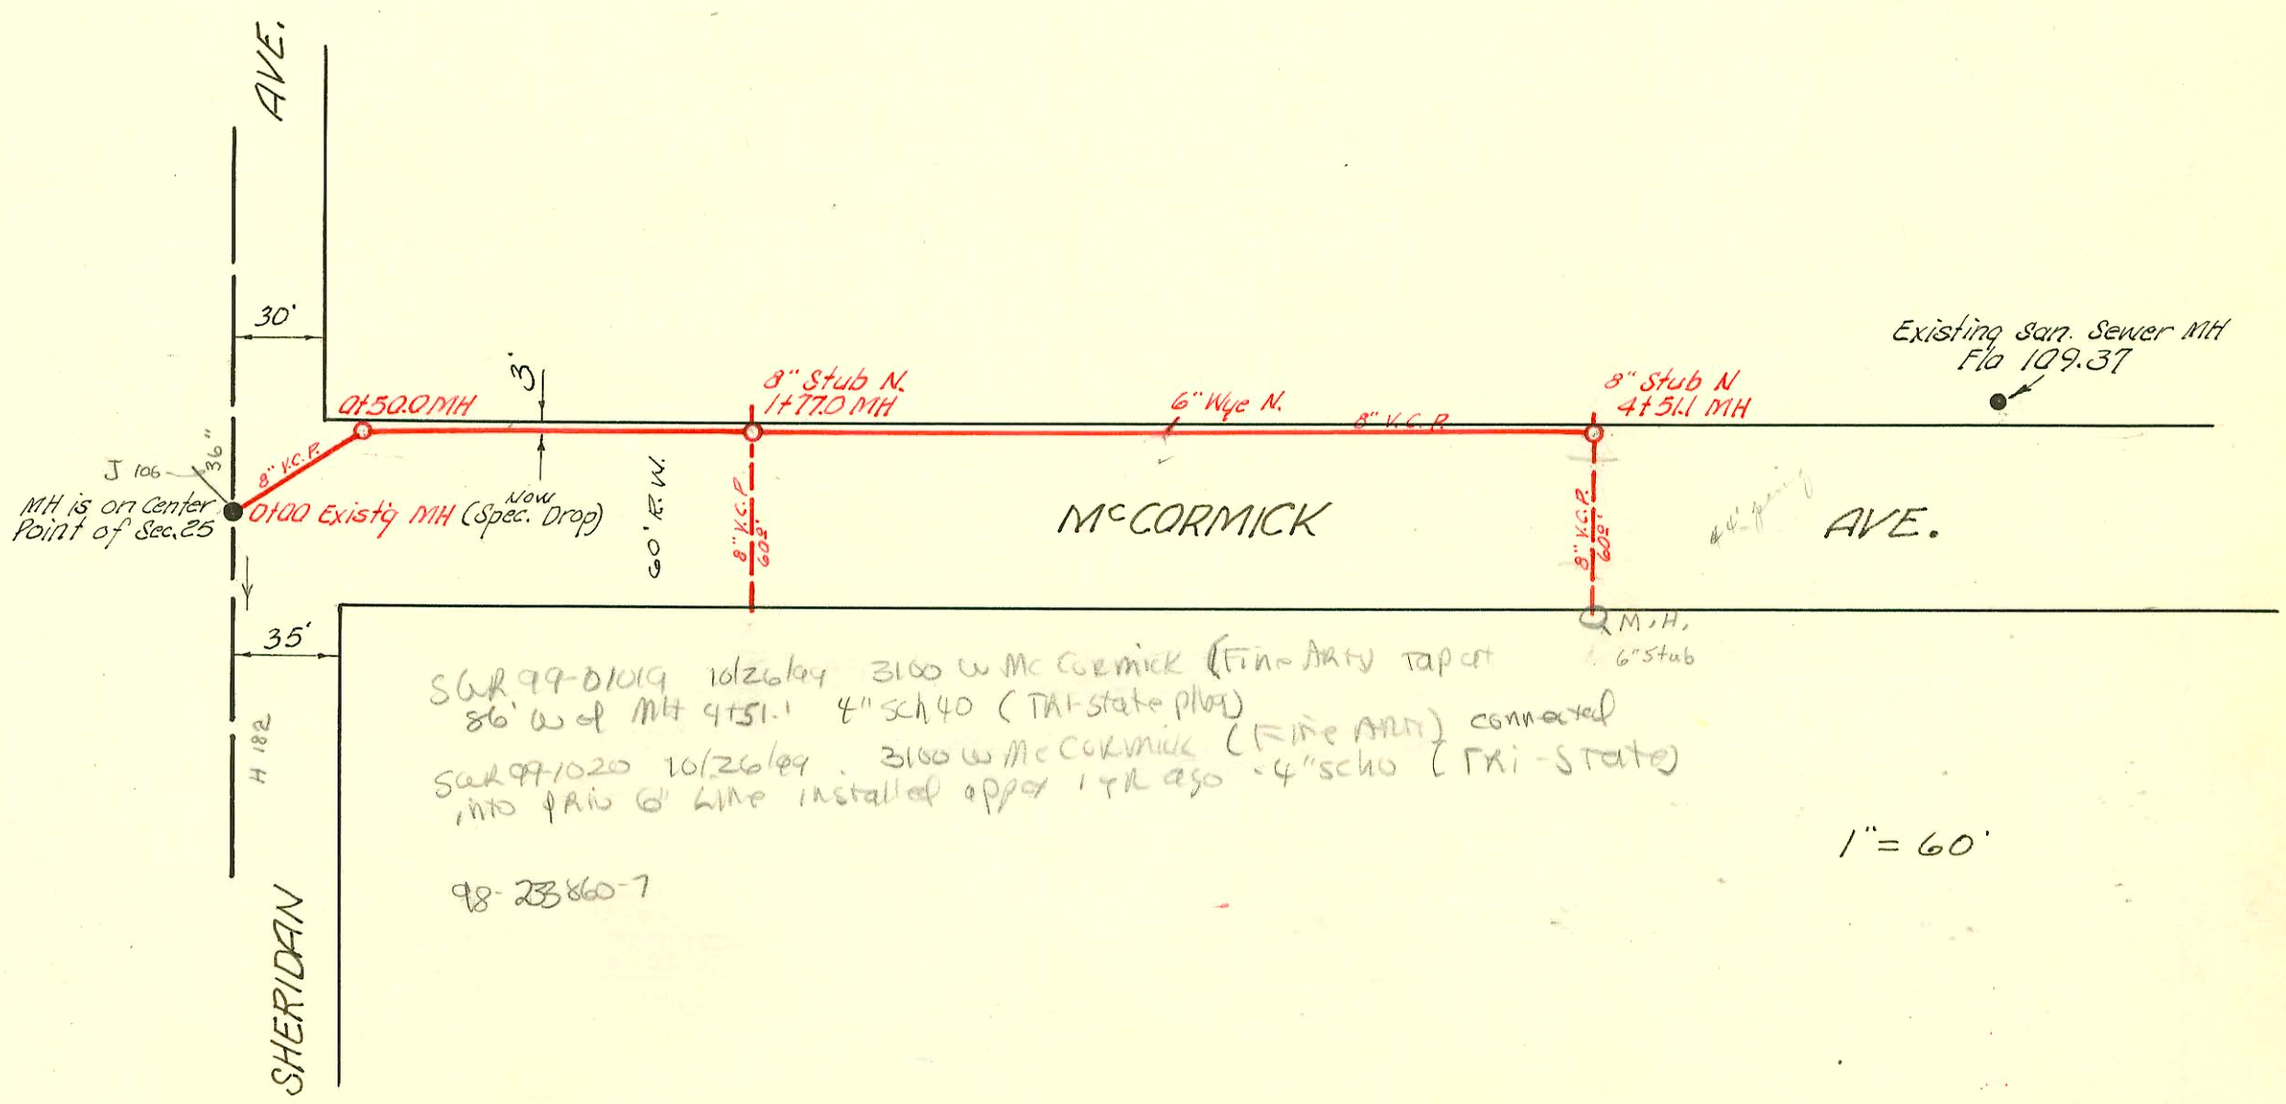

LAT. 20, S. S. 22

NOV. 7, 1955

BK. NO. K-34, PRIVATE CONT.

Utility Contractors

H-33

Form 41-(54) 8-58

	CONSTRUCTION RECORD							SERVICE RECORD					
	STATION	ELEVATION Ground	ELEVATION Grade	Depth	MANHOLE	4-INCH "Y" BRANCHES North ~~West~~	4-INCH "Y" BRANCHES South ~~East~~	No. of Permit North West	No. of Permit South East	House Number North West	House Number South East	DATE OF PERMITS North West	DATE OF PERMITS South East
Line #1	0-23.5	101.5	97.40	4.1	0-23.5 Exist'g MH								
	0+00	101.2	97.45 out / 97.55 in	3.8 / 3.6	0+00								
	1+0	101.5	97.75	3.7									
	2+0	100.8	97.95	2.9									
		100.9	98.00 out / 98.10 in	2.9 / 2.8	2+24.5								
	3+0	101.1	98.17	2.9									
		101.2	98.22 out / 98.32 in	3.0 / 2.9	3+49.3								
	4+0	101.3	98.37	2.9		4+14.5 / 4+21.0 End 6" V.C.P 50' N.		Sep #C1535 #6642		1728 Seneca ct		1-12-67 / 10-10-55	
							4+27.0		C 39822 #6646		1788 Seneca ct		7-2-73 / 10-10-55
							4+78.5		C 39823 #6643		1784 Seneca ct		10-2-73 / 10-10-55
		101.0	98.46 out / 98.56 in	2.5 / 2.4	4+93.0								
							4+98.0						
	5+0												
							5+58.5						
		101.6	98.66 out / 98.76 in	2.9 / 2.8	5+93.5								
	6+0						EAST 6+00.0						
							6+41.0		#6644		1768 Seneca ct		10-10-55
		102.4	98.82 out / 98.92 in	3.6 / 3.5	6+55.5								
							6+74.0		#7227		1764 Seneca ct		1-11-56
	7+0	102.3	98.97	3.3									
							7+22.0		#7226		1760 Seneca ct		1-11-56
	8+0	102.0	99.07	2.9									
		102.7	99.11	3.6	8+41.2	(6" V.C.P. 20' E to lot 11) / (4" Stub N. for lot 10) / (6" Stub W. 30° for lot 9)		#7225 / 92-27977 / #6643 / 90-87147 / #7224			1756 Seneca ct / 1756 R Seneca ct / 1748 R Seneca ct		1-11-56 / 2-28-92 / 10-10-55 / 6-16-92 / 1-11-56
Line #2						WEST	EAST						
	0+0	101.0	98.56	2.4	0+00 = 4+93 in Line #1								
							0+84.5		6641		1736 R Seneca		10-10-55
	1+0	101.7	98.66	3.0									
						1+09.0		Seal off #84707 #6638		1733 Seneca ct.		12-3-65 / 10-10-55	
							1+61.0	#B6179	#6640	1732 Seneca ct.	1740 Seneca ct	8-15-66	10-10-55
	2+0	102.2	98.76	3.4									
						2+01.0		#6637		1724 Seneca		10-10-55	
						Seal off 2+49.0	2+52.0	2001-01347 7327 #6636	96-16177 #6639	1720 S. S/O Seneca ct / 1716 S. Seneca	1744 R Seneca ct	4-30-01 / 11-12-83 / 10-10-55	9-30-91 / 10-10-55
						2+98.0		#6635				10-10-55	
	3+0	102.0	98.86	3.1									
		102.0	98.87	3.1	3+09.6 = 0+00 Rubottom Addn								
	Rubottom Addn. S.S. (PRIVATE)												
		102.0	98.86	3.1	0+00 Exist = 3+09.6 Line 2.								
		100.7	98.94	1.8	0+37.6	top 0+33.9 w/4" Stub N.W.		C 50992 / C 32279		1702 S. Seneca / 1702 S. Seneca		8-25-75 / 5-16-72	
						NORTH	SOUTH						
LAT. 20, S.S. 22	0+0	113.1	103.00	10.1	0+00 Exist'g MH								
		113.6	103.10	10.5	0+50.0								
	1+0	114.8	103.20	11.6									
							Connected to 1+63.0		93-17628-7 ?		3116 S McCormick		7-2-93 ?
		115.8	103.30 out / 103.85 in (103.50 N & S)	12.5 / 12.4	1+77.0	60' of 8" V.C.P. South across St. / 8" Stub N.			#7045		3100 McCormick		12-13-55
	2+0	115.0	103.40	11.6		4" SCH 40 3+65.1		99-01019		3100 McCormick *	Library West Swr	10-26-99	
	3+0	113.0	103.60	9.4		6" Wye N. 3+13.0		99-11163-7 #7046		3100 S McCormick		6-1-99 / 12-13-55	
	4+0	112.3	103.80	8.5		8" Stub N.		99-11164-7 #7047		3100 S McCormick		6-1-99 / 12-13-55	
		111.8	103.90 (104.00 N & S.)	7.9	4+51.1	60' of 8" V.C.P. South across St.							
					0+60		6" Stub S.E.	99-01020	#C21035	3100 McCormick *	3100 W. McCormick (Library - East Swr.	10-26-99	9-17-70

Top - C 24519 / 42593 - 1786 Seneca Ct. - 12-2789 / 12-5-73 - Aquaseding (MH 4+93) 3+62.6

top - #7228 - 1772 Seneca ct - 1-12-56 - Kennedy poly
top #7229 - 1776 Seneca ct - 1-12-56 - Kennedy poly
top 0+48 4" SCH 40 Replenture Line 10/96
top #7230 - 1780 Seneca ct - 1-12-56 - Kennedy poly

Wye 5+78.6

98-23386-7 12-8-98 3100 W McCormick (Sports Complex)

86' W of MH 4+51.1 - West Sewer
99-01019 / 99-01020 } 3100 W McCormick - Fine Arts Bldg - East Sewer
(N/C - connected into existing 6" PVC private line that was installed approx 1yr ago.)

2000-00489 - 2/23/00 Grease Interceptor - Dining Facility for Mabee Ctr