


20'	1	100'	100'	60	20'
	2		12+91.0 MH.	59'	
	3			58	
	4			57	
	5			56	
	6		12+00.4 MH.	55	
	7			54	
	8			53	
	9			52	
	10			51	
	11			50	
	12			49	
	13			48	
	14			47	
	15			46	
	16			45	
	17			44	
	18			43	
	19			42	
	20			41	
	21		8+99.7 MH.	40	
	22			39	
	23			38	
	24			37	
	25			36	
	26			35	
	27			34	
	28			33	
	29			32	
20'	30	100'	100'	31	20'

ORIENTA BLVD.

20'	1	100'	100'	60	20'
	2			59	
	3		6+01.0 MH.	58	
	4			57	
	5			56	
	6			55	
	7			54	
	8			53	
	9			52	
	10			51	
	11			50	
	12			49	
	13			48	
	14			47	
	15			46	
	16			45	
	17			44	
	18		2+99.2 MH.	43	
	19			42	
	20			41	
	21			40	
	22			39	
	23			38	
	24			37	
	25			36	
	26			35	
	27			34	
	28			33	
	29			32	
20'	30	100'	100'	31	20'

BENNETT AVE.

0+00
Existg MH

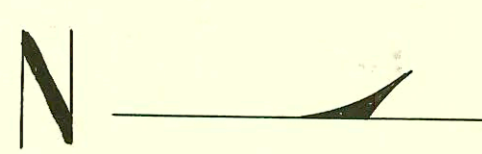

1" = 80'

PLUGGED

LAT. 4 , SUB. 3 , S. S. 22
 W. B. CARTER CONST. CO. INC. , MAY 9, 1955
 BK. NO. K-25 PROJ. NO. C25-12

CONSTRUCTION RECORD						SERVICE RECORD						
STATION	ELEVATION		Depth	MANHOLE	4-INCH "Y" BRANCHES		No. of Permit		House Number		DATE OF PERMITS	
	Ground	Grade			North West	South East	North West	South East	North West	South East	North West	South East
0+0	99.1	91.95	7.2	0+00 Existing MH.	0+51.8	0+54.8						
1+0	98.4	92.20	6.2		0+93.0	0+96.0	4985		2702 Anita		8-9-57	
2+0	98.1	92.45	5.7		1+37.0	1+40.0						
					1+75.9	1+78.9						
3+0	98.3	92.70	5.6	2+99.2	2+17.4	2+20.4						
					2+56.4	2+59.4			2043 Anita		7-1-55	
					2+98.0		#5422					
4+0	98.4	92.90	5.5		3+40.0	3+43.0						
					3+81.0	3+84.0						
5+0	98.4	93.10	5.3		4+19.5	4+22.5						
					4+61.3	4+64.3						
6+0	98.5	93.30	5.2	6+01.0	5+03.3	5+06.3						
					5+40.3	5+43.3	#6286		2015 Anita		9-8-55	
					5+80.0	5+83.0						
7+0	98.4	93.50	4.9		6+22.0	6+25.0						
					7+16.0	7+19.0						
					7+56.6	7+59.6						
8+0	98.5	93.70	4.8		7+98.0							
					8+39.8	8+42.8						
					8+84.5	8+87.5						
9+0	98.4	93.90	4.5	8+99.7	9+19.0	9+22.0						
					9+60.0	9+63.0						
10+0	98.3	94.10	4.2		10+02.0	10+05.0						
					10+45.0	10+48.0						
					10+82.0	10+85.0						
11+0	98.2	94.30	3.9		11+19.8	11+22.8	11846		1931 Anita		11-12-59	
					11+64.4	11+67.4						
12+0	98.3	94.50	3.8	12+00.4	12+07.4	12+10.4						
					12+45.3	12+48.3	6796 #718		2733 Anita, 1906 Canada		5-1-58	5/8/56
	98.4	94.68	3.7	12+91.0								

6024 Top 1935 Anita Dr Mc Donald 1-8-58
 7420 Top 1936 Canada Co Buffalo 7-18-56
 10553 Top 2032 Canada Bradford 6-5-59 3122.2