H 69 A

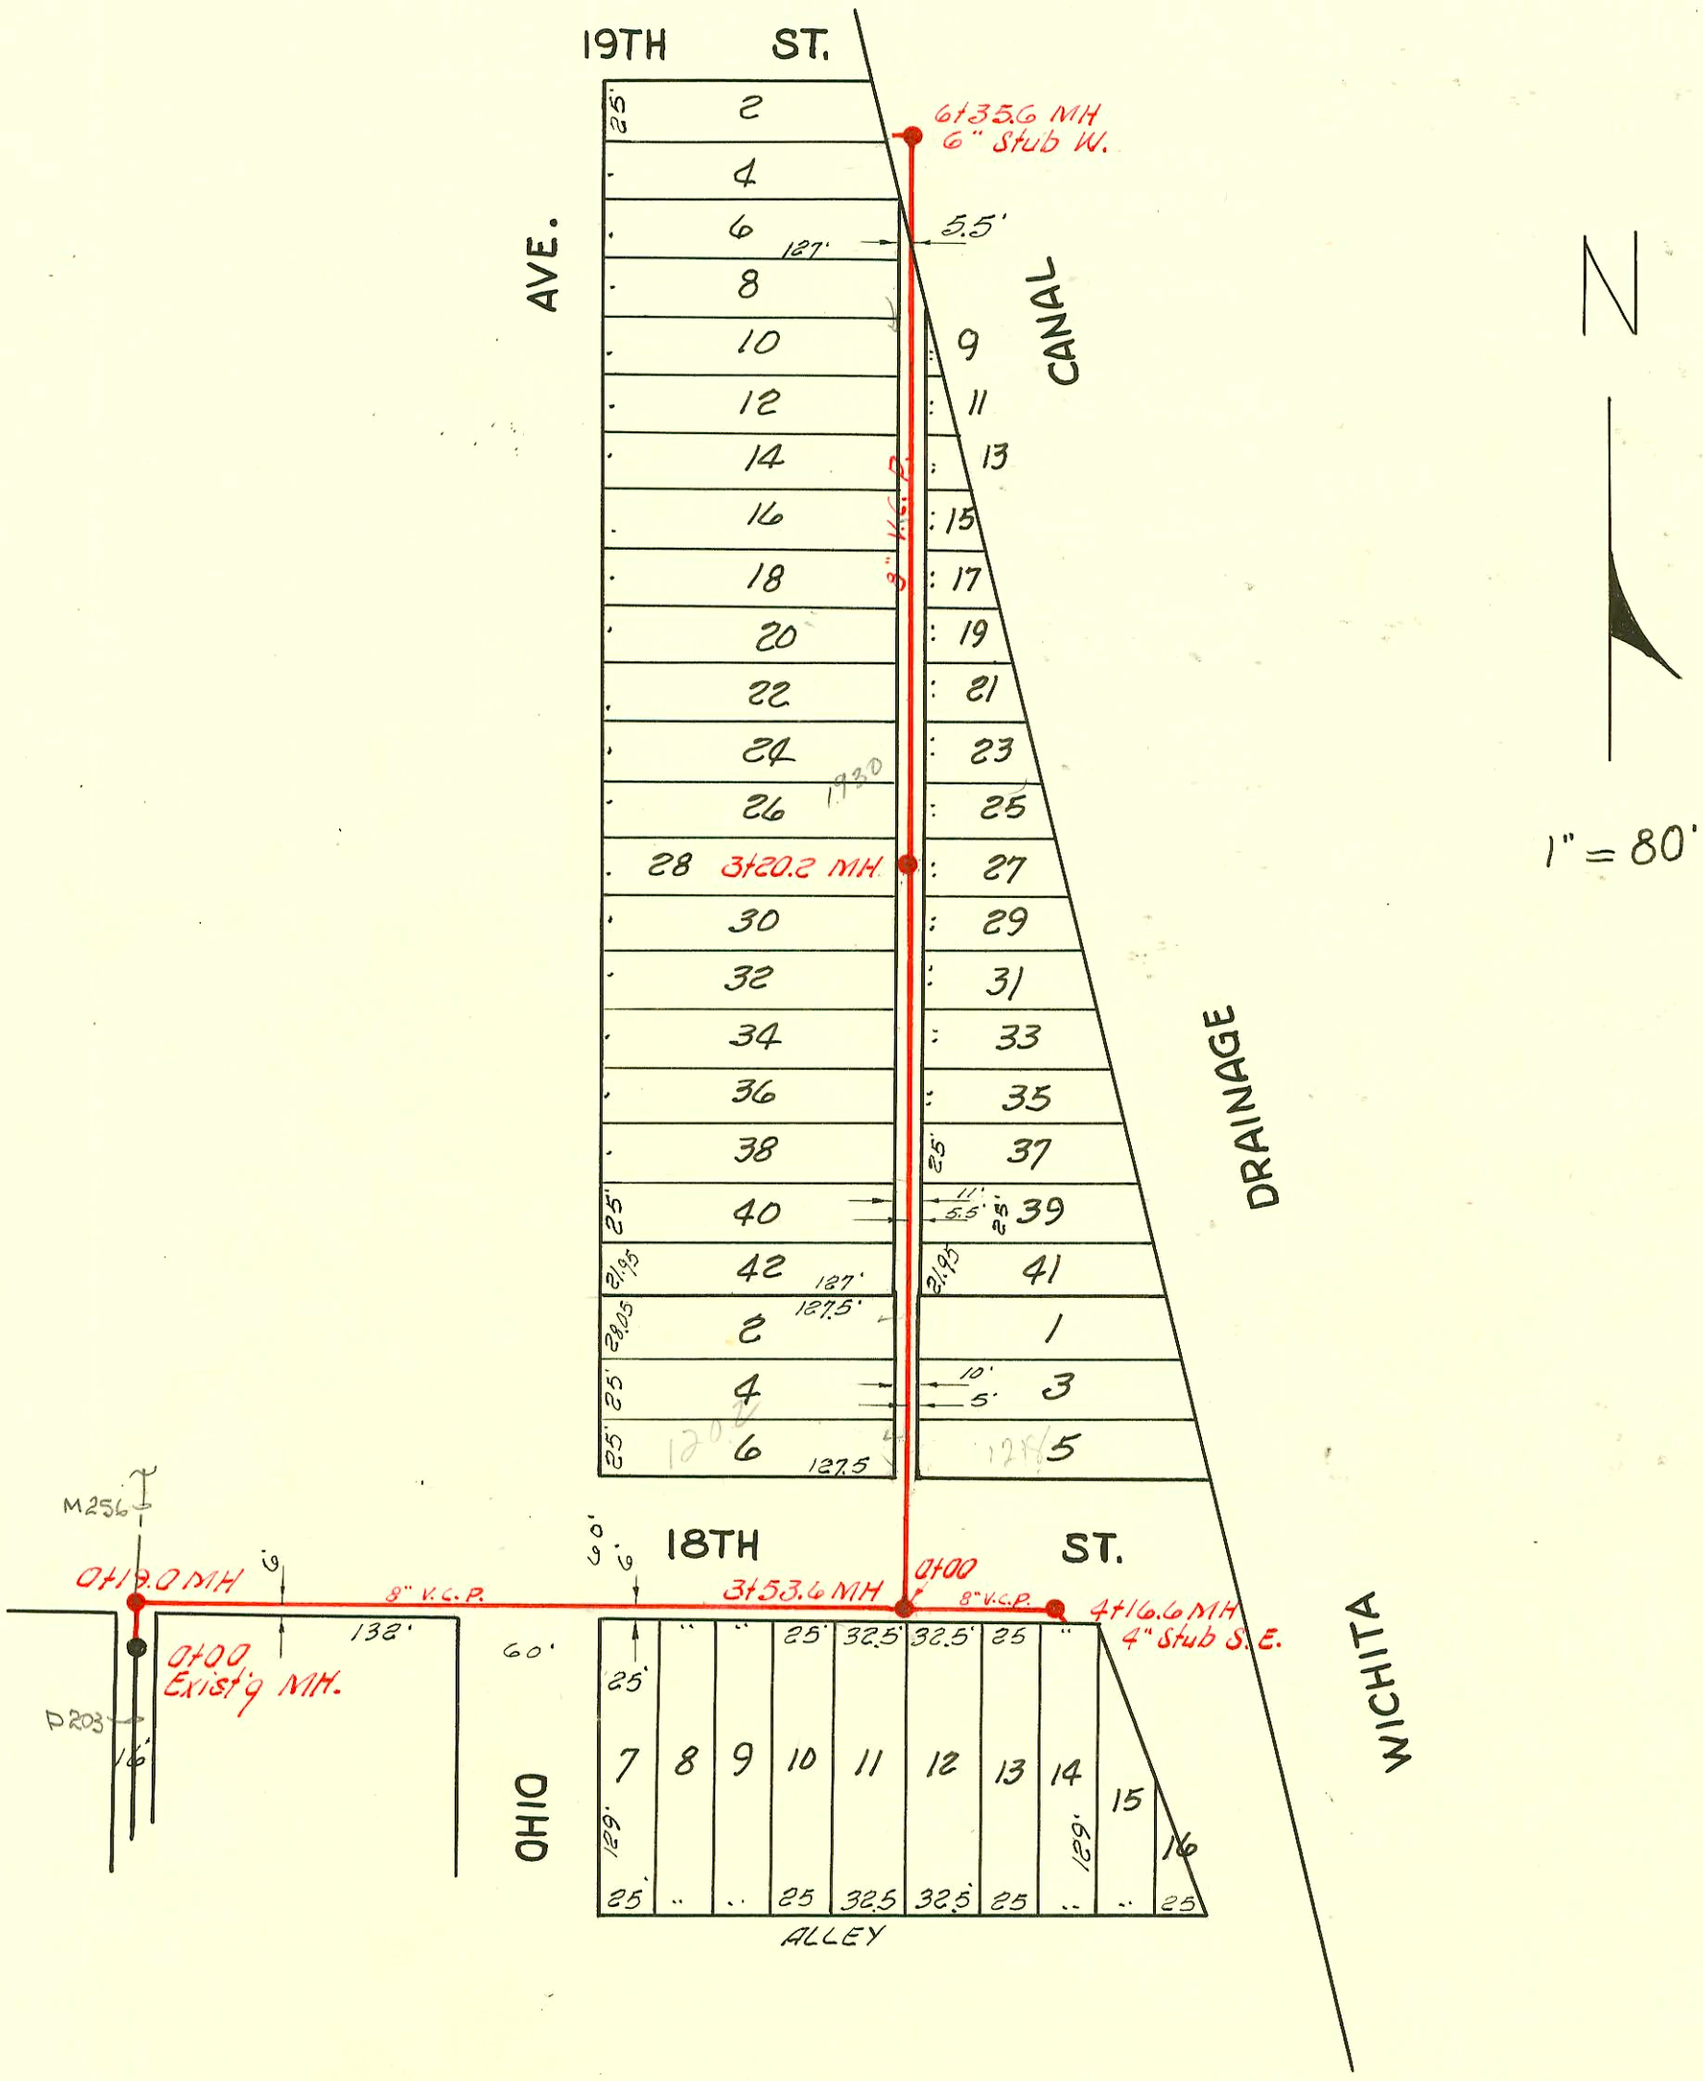

LAT. 42, S. S. NO. 20

W. B. CARTER CONST. CO. INC., 3-28-56

BK. NO. K-35, PROJ. NO. C 26-3

Form 41-(54) 8-58

	CONSTRUCTION RECORD							SERVICE RECORD					
	STATION	ELEVATION Ground	ELEVATION Grade	Depth	MANHOLE	4-INCH "Y" BRANCHES ~~North~~ West	4-INCH "Y" BRANCHES ~~South~~ East	No. of Permit North West	No. of Permit South East	House Number North West	House Number South East	DATE OF PERMITS North West	DATE OF PERMITS South East
	27+0	103.0	97.50	5.5	27+003					20083 ? wrong add			
						27+38.5		4656		Dave		5-27-57	
						27+84	27+52.0	#1197	6716	20083 to Dave	1641 Mary	6-20-52	10-11-82
	28+0	103.4	97.70	5.7									
						28+44	28+54.3	6857 #5275	6714	20083 to Dave	1639 Mary	10-27-82 7-14-51	10-11-82
		103.3	97.84	5.5	28+70.3								
						4" Wyes							
							"Y" SOUTH						
Line #1	0+0	119.6	111.04	8.6	0+00 Exist'g MH.								
		119.3	111.08 Out 111.18 in	8.2 8.1	0+19.0								
							0+99.0						
LAT. 42, S. S. No. 20	1+0	119.4	111.34	8.1									
	2+0	119.3	111.54	7.8									
							2+37.5						
							2+88.5						
	3+0	118.6	111.74	6.9									
							3+36.5						
		118.6	111.85	6.8	3+53.6								
							3+82.0						
	4+0	119.1	111.94	7.2									
		119.2	112.02	7.2	4+16.6	(4" Stub	SE)						
Line #2	0+0	118.9	111.95	7.0	0+00 = 3+53.6 in Line #1	"Y" WEST	"Y" EAST						
						0+74.5	0+71.5	B311		1202 E. 18th St.		10-23-63	
	1+0	119.0	112.15	6.9									
						1+21.8	1+18.8						10-28-58
						1+71.2	1+69.2	C34107 #1477	8516	1910 Ohio	1918 E. 18th St.	8-7-72 7-17-56	
						1+92.5		C34106		1912 Ohio		8-7-72 7-17-56	
	2+0	118.5	112.35	6.1									
						2+17.5	2+15.5	C31317 #1101		1911 Ohio		4-3-72 6-13-56	
						2+82.5							
	3+0	118.7	112.55	6.1		tap 3+04.0 ~~3+11.8~~		1999-00341 C38336		1912 Ohio		8-549 4-18-73	
		118.0	112.59	5.4	3+20.2			C36829 #1686		1930 Ohio		1-22-73 7-26-56	
						3+68.4							
	4+0	119.1	112.75	6.4				C36830 #1687		1934 Ohio		1-22-73 7-26-56	
						4+27.8							
						4+66.8		C34105 #6701		1936 Ohio		8-2-72 2-25-63	
	5+0	118.9	112.95	6.0		tap 5+00.2		C45226		1930 N Ohio		6-10-74	
						5+20.4							
						5+57.0	(6" wye)	#451		1948 Ohio		4-9-56	
	6+0	119.4	113.15	6.3									
		119.5	113.22	6.3	6+35.6	(6" stub W)							

7/8 #1370 - 1950 Ohio - Jake Kirkland - 7-5-84 - 6+35.6 S, 122.0' S - (5+13.6)

#452 - private line connection - 1948 Ohio - R. LaFoy - 4-9-56 3934 - Sep - 1218 E. 18th St. - La Fay, In. - 3-1-57

#453 - " " " " " " "

923 trailer 1948 Ohio LaFoy Rlty 5/22/56

925 trailer - 1948 Ohio LaFoy Rlty 5/6/57

926 trailer 1948 Ohio LaFoy Rlty 5/2/56

7083 trailer 1920 Ohio Joe McDonald 6-11-58 Lebanon wrg