
70A

If Cris Sewer Service Line has TRAP - Must keep Line with a TRAP

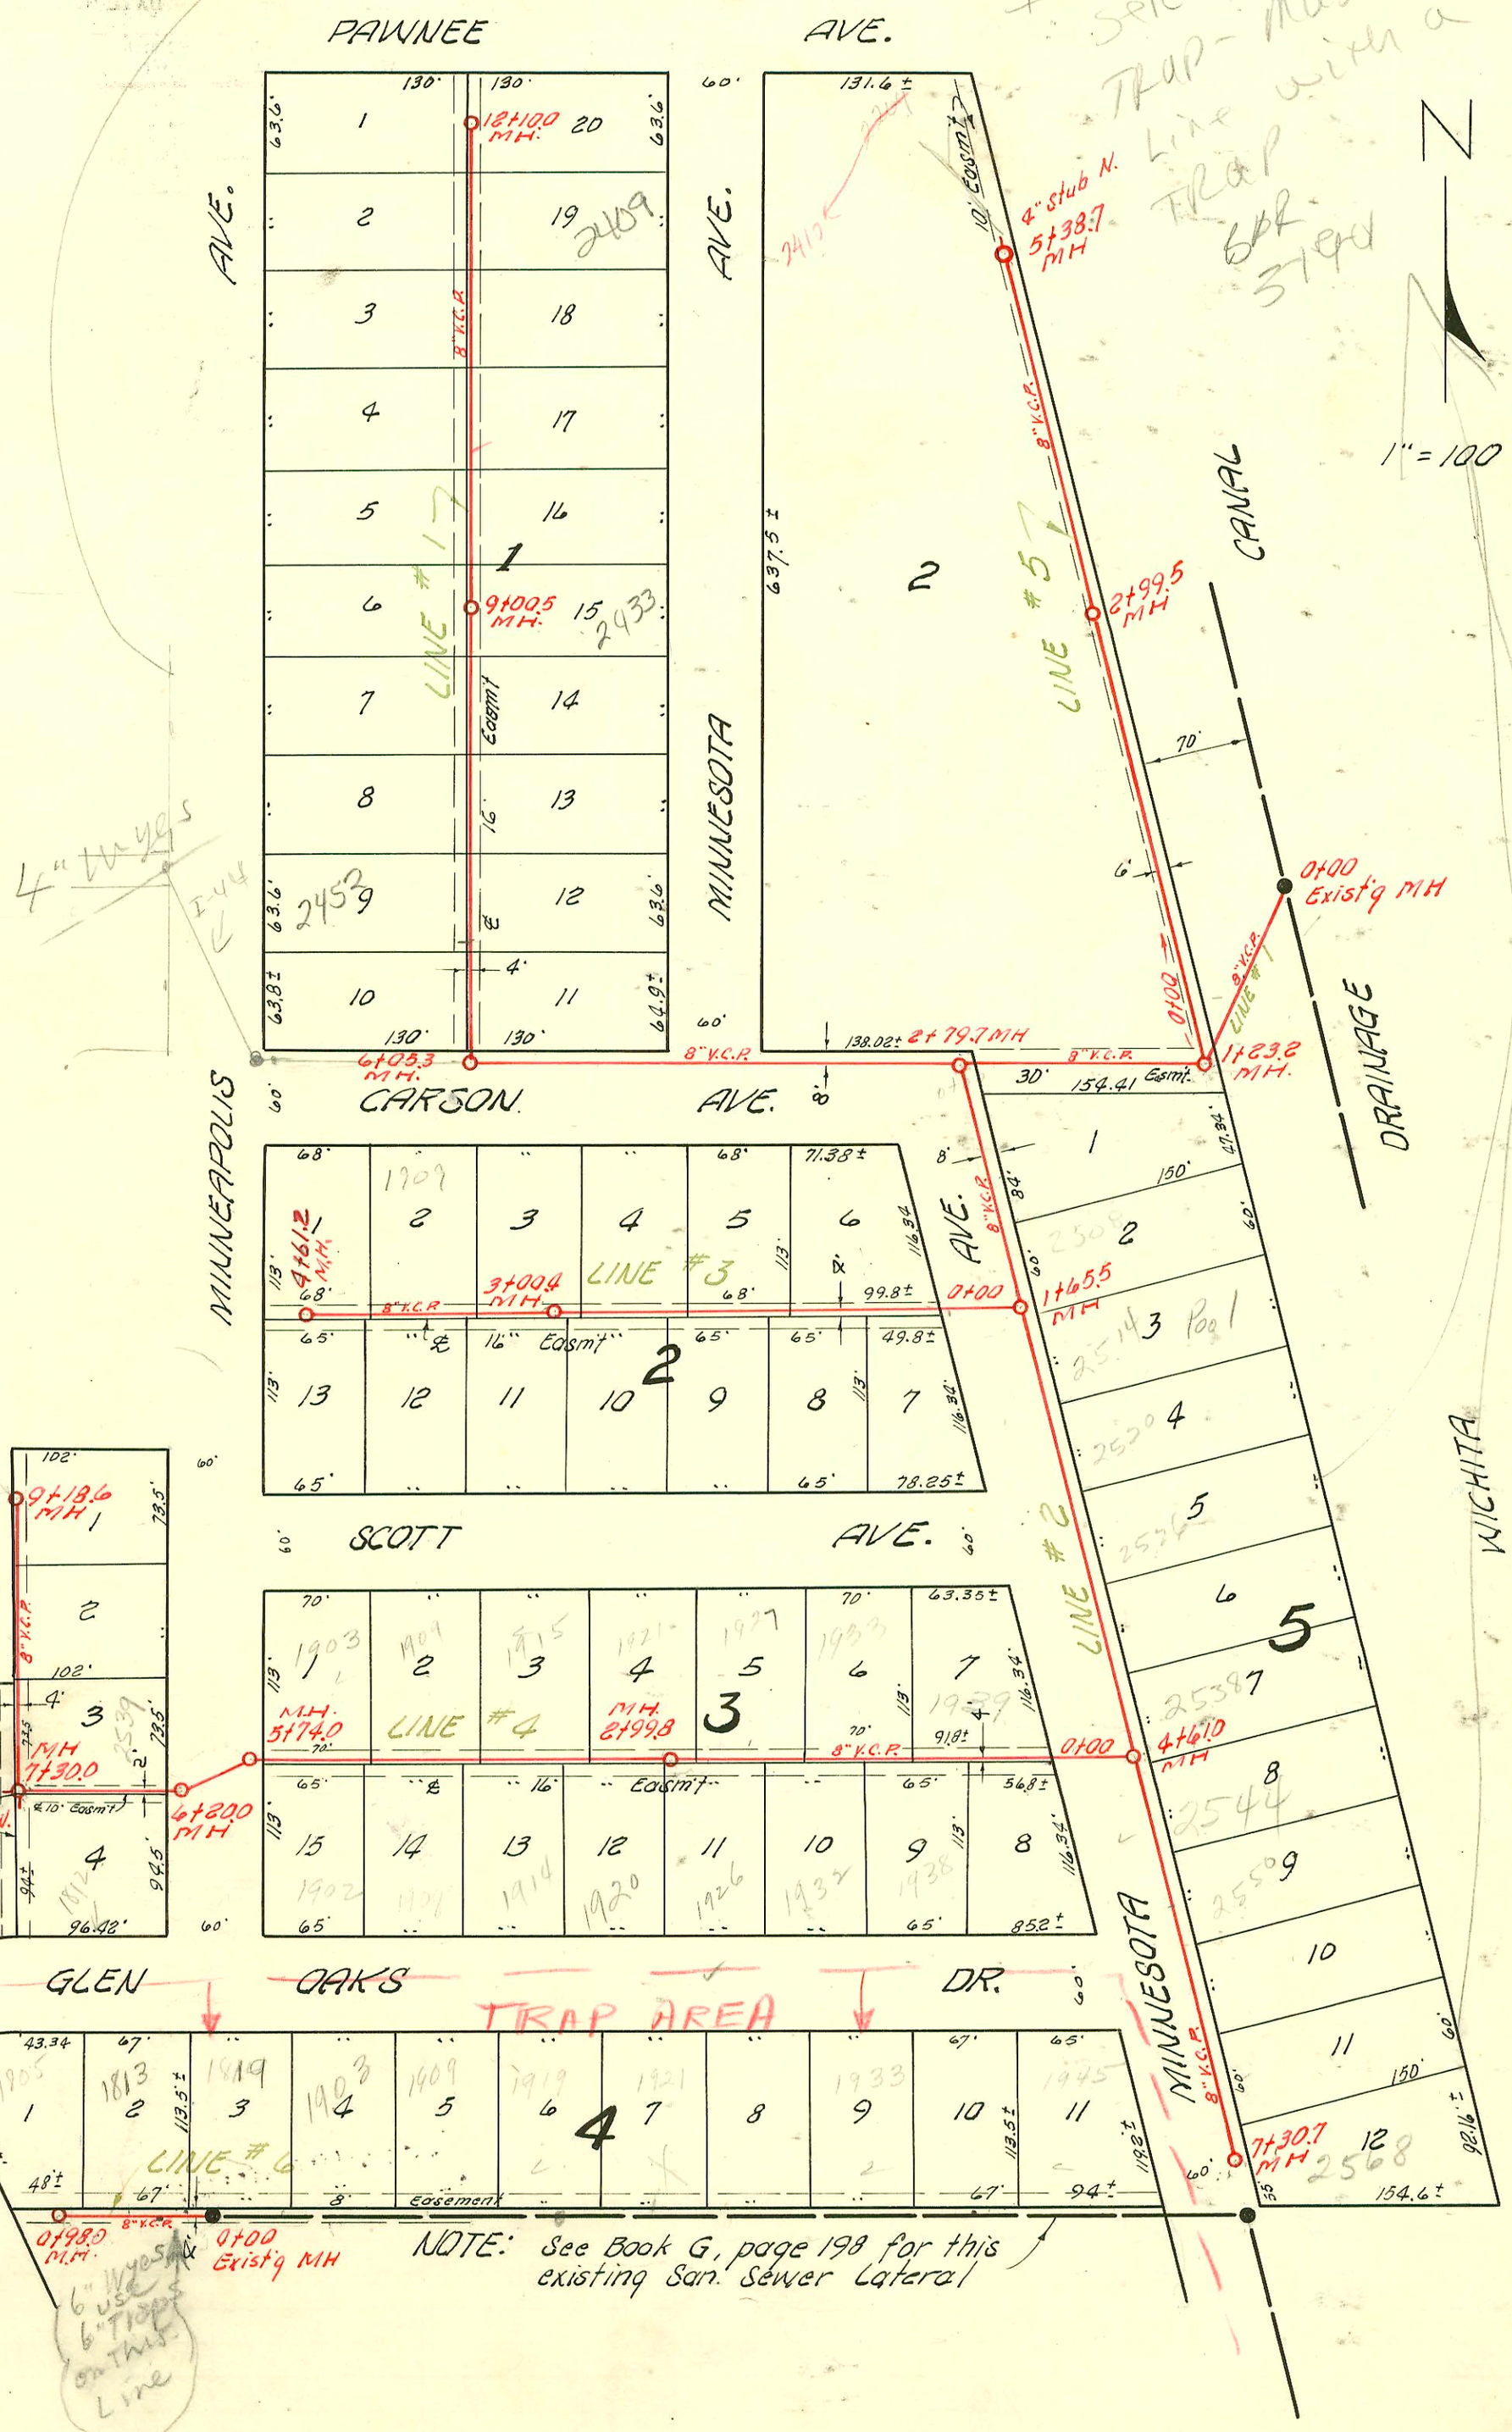

7623 Tap 2508 S. Minneola Jt Pilly 8-4-58
7626 Tap 2562 S Minneola Jt Pilly 8-4-58
7625 Tap 2556 S Minneola Jt Pilly 8-4-58
7624 Tap 2532 S Minneola Jt Pilly 8-4-58
2410 So. Minn. 28-Tap ~~2209 S Pawnee~~ Cudsmore 10-22-58 4+97, line 5
9392 Tap 2538 S Minneola Kenning 2-26-59 4+51.5
10709 Tap 2539 S Minneapolis Phipps 6-23-59 7+49
10596 Tap 1926 Glen Oaks Kenning 6-12-59 2+50.8
15242 - Tap - 2044 S. Minneola - 3-6-62 - Wells Trenching Service - 4+09.0

LAT. 1, S. S. 23

UTILITIES CONT. INC., JUNE 23, 1955

BK. NO. K-27, PROJ. NO. C25-29

Form 41-(54) 8-53

	CONSTRUCTION RECORD							SERVICE RECORD					
	STATION	ELEVATION		Depth	MANHOLE	4-INCH "Y" BRANCHES		No. of Permit		House Number		DATE OF PERMITS	
		Ground	Grade			~~North~~ West	~~South~~ East	North West	South East	North West	South East	North West	South East
Line #1	0+0	98.3	83.60	14.7	Exist'g MH 0+00								
	1+0	94.8	84.00	10.8									
		94.4	84.10 Out 84.20 in	10.3 10.2	1+23.2								
	2+0	94.5	84.50	10.0									
		94.5	84.83 out 85.03 in	9.7 9.5	2+79.7								
	3+0	94.2	85.09	9.1									
	4+0	94.2	85.39	8.8									
	5+0	94.0	85.69	8.3									
	6+0												
		93.9	86.01 Out 86.11 in	7.9 7.8	6+05.3								
						6+34.5	6+31.5	#1666	#5462	2454 S Minneapolis	2457 So. Minnesota	1-30-56	7-6-55
						6+83.0	6+80.0	3559		2452 S Minneapolis		1-9-57	
	7+0	93.9	86.39	7.5									
						7+48.0	7+45.0	3558	#5464	2446 S Minneapolis	2445 S Minnesota	1-9-57	7-6-55
	8+0	94.5	86.69	7.8									
						8+11.0	8+08.0	3557	#5465	2440 S Minneapolis	2439 S Minnesota	1-9-57	7-6-55
						8+74.0	8+71.0	3556	#5466	2434 S Minneapolis	2433 S Minnesota	1-9-57	7-6-55
	9+0												
		95.0	86.99	8.0	9+00.5								
						9+43.0	9+40.0	3555	#5467	2428 S Minneapolis	2427 S Minnesota	1-9-57	7-6-55
	10+0	95.4	87.29	8.1									
						10+04.0	10+01.0	3554		2422 S Minneapolis		1-9-57	
						10+66.5	10+63.5	4042	#5469	2416 S Minneapolis	2415 S Minnesota	3-11-57	7-6-55
	11+0	95.9	87.59	8.3									
						11+29.5	11+26.5	4043	#5470	2410 S Minneapolis	2409 S Minnesota	3-11-57	7-6-55
						11+93.5	11+90.5	4044		2404 S Minneapolis		3-11-57	
	12+0	97.0	87.89	9.1									
		97.0	87.92	9.1	12+10.0								
Line #2	0+0	94.5	85.00	9.5	0+00 = 2+79.7 in Line #1								
							0+48.0						
	1+0	93.9	85.20	8.7									
							1+21.0						
		93.7	85.33	8.4	1+65.5								
							1+80.0 ✓						
	2+0	93.4	85.40	8.0									
							2+40.0		2004-00501 6973		2520 R CO Minnesota		2-26-04 5-19-58
	3+0	93.1	85.60	7.5									
							3+01.0						
							3+60.0						
	4+0	90.5	85.80	4.7									
							4+20.5						
		87.0	85.92	1.1	4+61.0								
							4+81.5						
	5+0	88.2	86.00	2.2									
							5+40.5						
	6+0	94.8	86.20	8.6			4" SCH40 Tap 5+61 Donut		2001-00658 6975		2550 R Minnesota	ITWIN CO, IV22 Fernco to CI @ house	3-26-01 5-19-58
							6+01.0						
							6+61.0						
	7+0	92.8	86.40	6.4									
							7+01.0						
		93.6	86.46	7.1	7+30.7								
						NORTH	SOUTH						
Line #3	0+0	93.7	85.50	8.2	0+00 = 1+65.5 in Line #2								
							0+55.7		#37		1938 Scott		2-28-56
						0+94.3		#7426		1933 Carson		2-20-56	
	1+0	93.9	85.90	8.0									
							1+18.5		#38		1932 Scott		2-28-56
						1+63.0		#7425		1929 Carson		2-20-56	
							1+81.0		#39		1926 Scott		2-28-56
	2+0	93.6	86.30	7.3									
						2+31.3							
							2+46.0						
	3+0	93.3	86.70	6.6									
		93.3	86.70	6.6	3+00.4								
						3+09.0	3+12.0						
						3+66.7							
							3+75.5						
	4+0	93.4	87.10	6.3		4+34.7							
							4+40.7						
		94.0	87.34	6.7	4+61.2								

5471 - tap - 2403 So. Minnesota - Farrell Plbg. 8-12-55
5468 - tap - 2421 So. Minnesota - Farrell Plbg. 8-12-55
5463 - tap - 2451 So. Minnesota - Farrell Plbg. 8-12-55
#33 - tap - 1902 Scott Riggs Plbg 8-28-56
#34 - tap 1908 Scott Riggs Plbg 8-28-56
#35 - tap 1914 Scott Riggs Plbg 8-28-56
#36 - tap 1920 Scott Riggs Plbg 8-28-56
6975 tap 2550 S [illegible] 5-19-58

#839 - to be tapped - Reynolds Plbg - 2410 Minnesota - 5-18-56
#7421 - tap - 1903 Carson - Harley Riggs Plbg.
#7422 - " 1909 Carson - " "
#7423 - " 1915 Carson - " "
#7424 - " 1921 Carson - " "
#5123 tap - 2502 S. Minnesota Martin Plbg Co. 8-20-51
5859 tap 2514 S. Minnesota [illegible] 12-13-57 1+92
6973 tap 2520 S Minnesota Henning 5-19-58
6974 tap 2526 S Minnesota Henning 5-19-58