72 A

SUBMAIN 4, S. S. № 22

W. B. CARTER CONST CO. JULY 11, 1955

BK. NO. K-28, PROJ. NO. C24-39

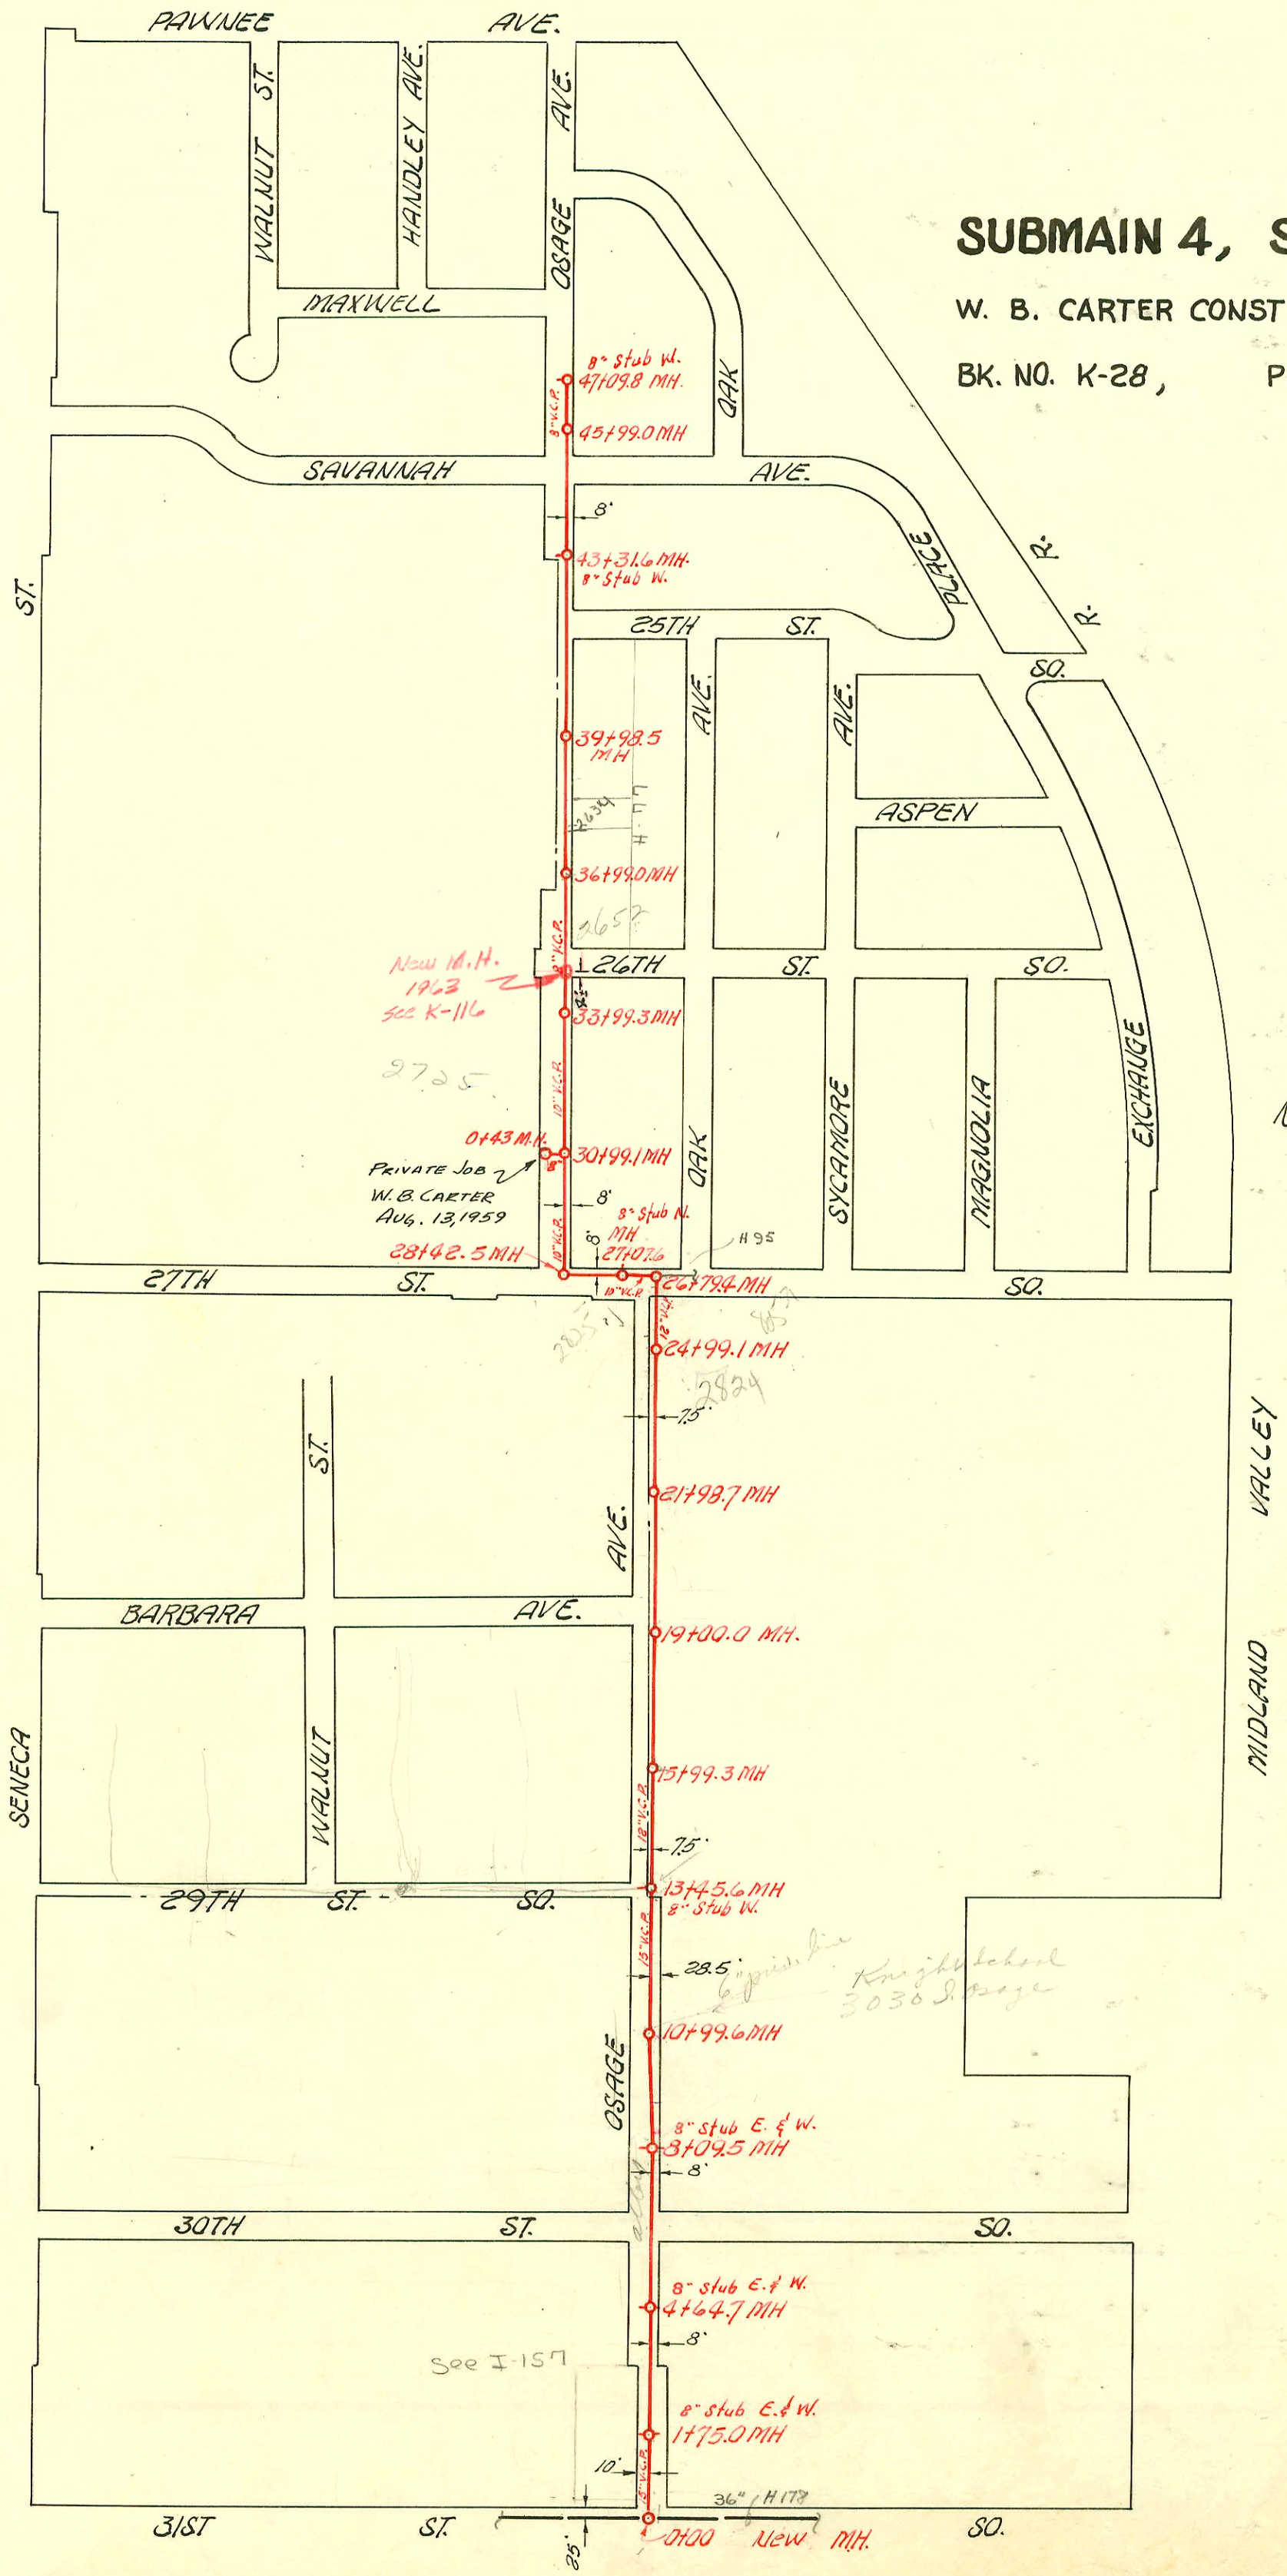

NOTE:
The area shown is the benefit district.

Form 41-(54) 8-53

CONSTRUCTION RECORD							SERVICE RECORD					
STATION	ELEVATION		Depth	MANHOLE	4-INCH "Y" BRANCHES		No. of Permit		House Number		DATE OF PERMITS	
	Ground	Grade			North West	~~South~~ East	North West	South East	North West	South East	North West	South East
				0+00								
0+0	95.2	87.65	7.6	New MH.								
1+0	94.6	87.73	6.9									
	94.6	87.79	6.8	1+75.0	8" Stub E & W.							
2+0	94.8	87.81	7.0									
3+0	95.0	87.89	7.1									
4+0	95.9	87.97	7.9									
	95.9	88.02	7.9	4+64.7	8" Stub	E & W.						
5+0	96.0	88.05	7.9									
6+0	96.9	88.13	8.8									
7+0	97.4	88.21	9.2									
8+0												
	96.9	88.30	8.6	8+09.5	8" Stub	E. & W.						
9+0	96.3	88.37	7.9									
10+0	96.8	88.45	8.4									
	97.2	88.53	8.7	10+99.6								
11+0												
12+0	97.7	88.61	9.1									
13+0	98.0	88.69	9.3									
	98.8	88.73 out 88.98 in	10.1 9.0	13+45.6	8" Stub W.							
14+0	99.2	89.04	10.2									
15+0	99.8	89.16	10.6									
	99.9	89.28	10.6	15+99.3								
16+0												
17+0	99.8	89.40	10.4									
18+0	98.8	89.52	10.3									
19+0												
	99.1	89.64	9.5	19+00.0								
20+0	99.5	89.76	9.7									
21+0	99.9	89.88	10.0									
	99.9	90.00	9.9	21+98.7								
22+0												
23+0	100.3	90.12	10.2									
24+0	101.0	90.24	10.8									
						24+27.3						
	99.4	90.36	9.0	24+99.1								
25+0												
						25+66.5	Sealed Off in Book J-4 #2988		805 lin. 27 Sq.		11-7-56	
26+0	98.9	90.48	8.4									
	100.1	90.58 out 90.74 in	9.5 9.4	26+79.4								
27+0	100.1	90.78	9.3									
	100.2	90.79	9.4	27+07.6	8" Stub N.							
28+0	100.2	90.93	9.3									
	100.7	91.00 out 91.10 in	9.7 9.6	28+42.5								
29+0	100.0	91.18	8.8									
30+0	100.0	91.33	8.7									
	99.6	91.48	8.1	30+99.1 =								
31+0				0+0 Prior								
32+0	99.9	91.63	8.3	0+43 ~~Line~~ MN top			13911 C30053		820 W R 27 Sq. 8		5-31-85 1-19-72	
33+0	100.0	91.78	8.2									
	99.7	91.93 out 92.10 in	7.8 7.6	33+99.3								
34+0												
35+0	99.7	92.30	7.4									
36+0	99.4	92.50	6.9									
	99.7	92.70	7.0	36+99.0								
37+0												
38+0	99.6	92.90	6.7									
39+0	99.9	93.40	6.5									
	99.4	93.30	6.1	39+98.5				C71470		2622 Sq. R 0 Sage		4-27-79
40+0												
41+0	99.4	93.50	5.9									
42+0	99.2	93.70	5.5									
43+0	99.1	93.90	5.2									
	98.9	93.96	4.9	43+31.6	8" Stub W.							
44+0	99.2	94.10	5.1									
45+0	99.0	94.30	4.7									
	99.2	94.50	4.7	45+99.0								
46+0												
47+0	99.1	94.70	4.4									
	99.1	94.80	4.3	47+09.8	8" Stub W.							

Tap 8537 2824 S Osage Earl Zurn 11-3-58 26+07.4
Tap 2725 S Osage W B Carter 8-3-59 6" Stub West side of Station 0.43
Tap #14707-723 W. 26th St. - Al Henning - 9-21-61 (35+82.6)
Tap #13337-2634 S Osag - Al Henning - 6-11-62 (37+96.8)
Tap #6133-3030 S. Osage (Knight School) 8-4-66 Richard LaFay, Jr. (9+65.1)