


16+35.5 end
 Lat. 15, S.S. 22.
 Begin Lat. 16, S.S. 22.
 See continuation
 of Sewer on page
 32, Bk. H.

AVE.

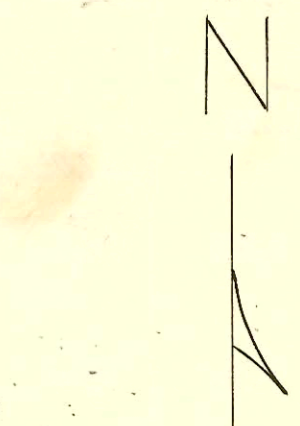

1" = 150'

NOTE:
 Construction record
 for this project record-
 ed on pages 90 to
 94 inclusive.
 All sewer laterals are
 8" V.C.P. except where
 noted.

LAT. 15, S. S. 22

W. B. CARTER CONST. CO. INC., SEPT. 17, 1955

BK NO. K-33

PROJ. NO. C25-48

CONSTRUCTION RECORD

SERVICE RECORD

STATION	ELEVATION		Depth	MANHOLE	4-INCH "Y" BRANCHES		No. of Permit		House Number		DATE OF PERMITS		
	Ground	Grade			North West	South East	North West	South East	North West	South East	North West	South East	
Line #4	0+0	106.1	100.70	5.4	0+00 = 3+74.5 in Line #2	Northwest	Southeast	#822	1911 Catharine	5-17-56			
	1+0	106.2	101.10	5.1							2+07.0	2+59.0	#821
	2+0	106.5	101.50	5.1	2+00.0				3136 Catharine	5-17-56	5-17-56		
	3+0	106.4	101.90	4.5	R.P.L. 4115-08-25				3139 R Catharine	2-24-56	5-17-56	5-17-56	
	4+0	106.1	102.20	3.9	3+77.0	North	South	#825	3116 Catharine	5-17-56	5-17-56		
	4+0	106.2	102.30	3.8								4+03.0	4+55.0
	5+0	106.3	102.80	3.5	5+30.5			#827	1906 Stanidan	5-17-56			
		106.5	103.00	3.5	5+33.5			#828	1918 Stanidan	5-17-56	5-17-56		
		106.5	103.00	3.5	5+51.0								
	Line #5	0+0	105.8	101.30	4.5	0+00 = 12+52.0 in Line #1	West	East	7967 #7321	1930 B St Paul	1943 L Catharine	8-28-54	2-6-56
1+0		106.0	101.70	4.3	0+24.0								
2+0		106.0	102.10	3.9	2+00.0	1+49.0	1+45.0	772 #7325	1922 St Paul	1931 L Catharine	5-11-56	2-6-56	
3+0		105.9	102.50	3.4	2+13.0	2+10.0	2+74.0	2+71.0	771 C75531 2005-08-11	1918 St Paul	1925 L Catharine	5-11-56	11-29-79 2-6-56 4-22-05 2-6-56
4+0		106.2	102.90	3.3	3+37.0	3+34.0	3+98.0	3+95.0	770 #7322	1915 St Paul	1932 Catharine	2-6-56	2-6-56
		107.1	103.18	3.9	4+61.0	4+58.0	4+69.5	4+58.0	771 #7319	1918 St Paul	1932 Catharine	2-6-56	2-6-56
		107.1	103.18	3.9	4+69.5				3017 # St Paul	3005 St Paul	2-6-56	2-6-56	
Line #6		0+0	105.8	98.80	7.0	0+00 = 12+52.0 in Line #1	Northeast	Southwest	#7328	1947 Catharine	1934 L St Paul	8-28-54	2-6-56
		1+0	105.2	99.20	6.0								
		2+0	104.9	99.55 out 99.65 in	5.3	1+87.0	1+52.0	1+55.0	1+55.0	2237 #7329 966507 7971	1951 R St Paul	1942 R St Paul	1-11-59 2-6-56
	3+0	104.6	100.10	4.5	2+51.0	2+08.0	2+48.0	2+48.0	7972 #7332	1946 St Paul	1913 Catharine	8-28-54	2-6-56
	4+0	104.6	100.50	4.1	3+53.5	3+11.0	3+72.5	3+72.5	9648 #7333 7973	1950 R St Paul	1917 Catharine	4-8-56	2-6-56
	5+0	104.5	100.94	3.4	5+09.5	4+36.0	4+33.0	4+33.0	7974 #7335	1954 R St Paul	1925 Catharine	8-28-54	2-6-56
		104.5	100.94	3.4	5+09.5	4+99.5	4+96.5	4+96.5	20575	1958 So St Paul	1929 S Catharine	8-14-70	2-20-79
	Line #7	0+0	106.9	99.40	7.5	0+00 = 17+89.0 in Line #1	West	East	#7134	1908 Catharine	1902 Catharine	12-30-55	12-30-55
		1+0	107.1	99.82	7.3								
		2+0	106.1	100.20	5.9	2+05.0	1+47.0	2+69.0	2+69.0	7132	1826 Catharine	12-30-55	12-30-55
3+0		107.2	100.60	6.6	3+33.0	2+05.0	2+69.0	2+69.0	2005-0317 7131	1820 B Catharine	12-30-55	12-30-55	
4+0		107.8	100.68	7.1	3+22.0	3+33.0	3+97.0	3+97.0	7130 15545	1814 Catharine	12-30-55	12-30-55	
5+0		107.8	100.68	7.1	3+22.0	3+33.0	3+97.0	3+97.0	7129	1408 Catharine	12-30-55	12-30-55	
		109.5	101.00	8.5	5+15.0	5+79.3	5+79.3	5+79.3	7128	1802 Catharine	12-30-55	12-30-55	
		107.6	101.40	6.2	5+79.3				018741	1934 Catharine	4-9-70		

NOTE:

Line # 7 Continues on page 93.

