

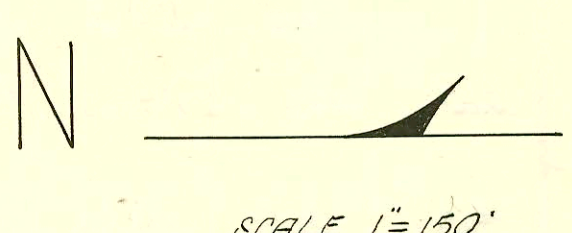


3022  
3030  
3031  
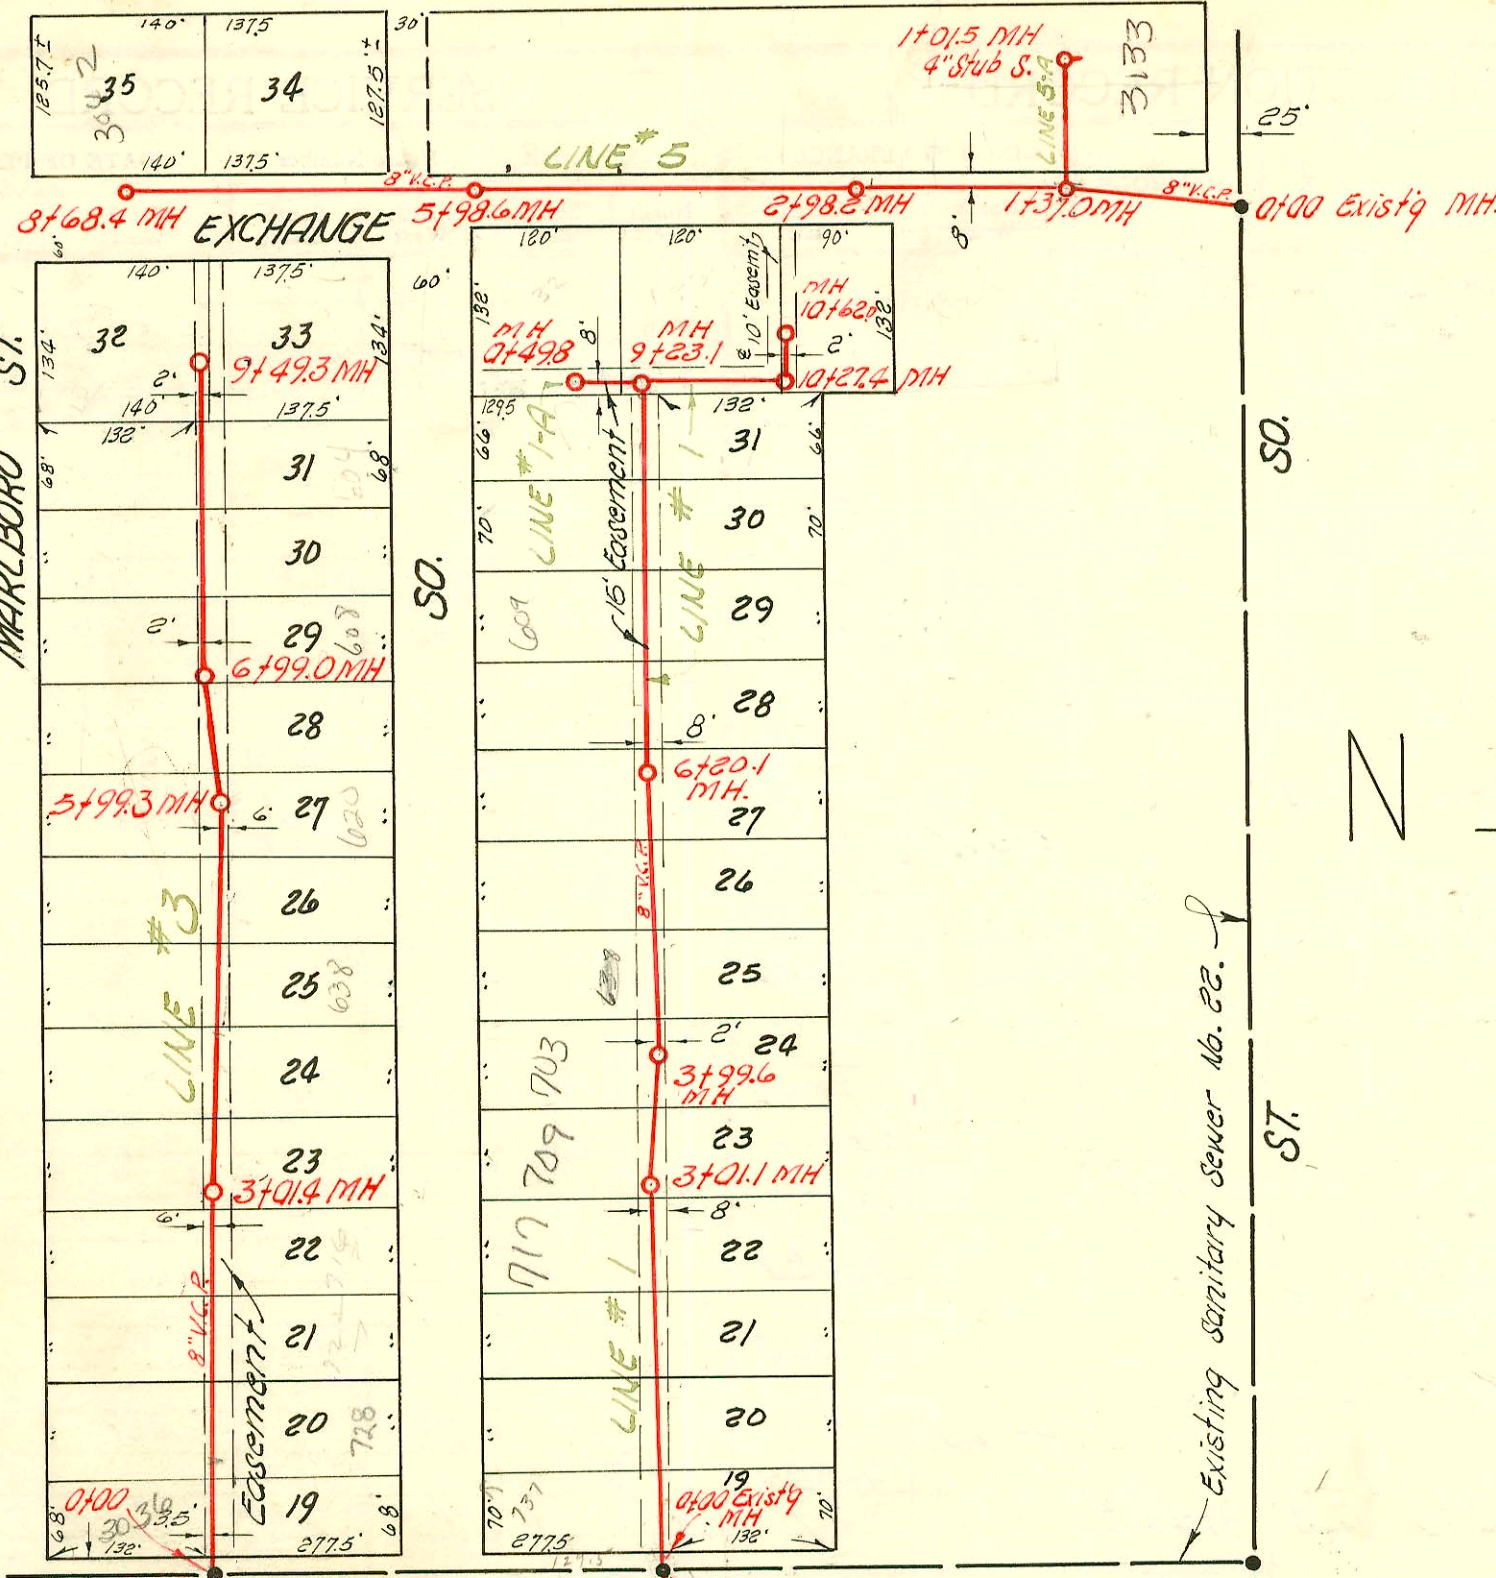

NOTE:  
Construction Record booked on  
pages 108, 109 and 110.

NOTE:  
see page 109  
for extension

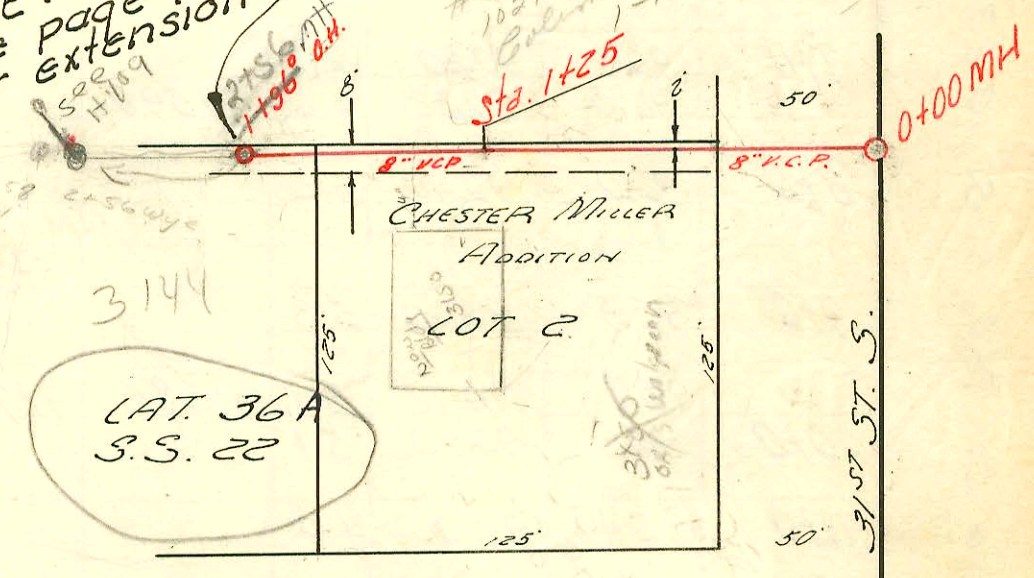

2000-01816  
97-0559-20701 9-11-97 3150 S. Seneca  
Walgreen-City Tap 102' S. of MH-4' sh 40  
slo at ms mt + 3' from Main

2000-00465-3150 S. Seneca - Boardman Ent - 4" PVC 40, New 4" wye  
6' S of MH 1725 (1717) WYE PREV. UNUSED, 1725, 1727

LAT. 5, SUB. 4, S. S. No 22

BUILDERS CONST. INC., JAN. 19, 1956  
BK. NO. K-40, PROJ. NO. C25-61

CONSTRUCTION RECORD

SERVICE RECORD

Line #1

Line #1-A

Line #2

STATION	ELEVATION		Depth	MANHOLE	4-INCH "Y" BRANCHES		No. of Permit		House Number		DATE OF PERMITS	
	Ground	Grade			North West	South East	North West	South East	North West	South East	North West	South East
0+0	95.9	88.54	7.4	0+00 Exist'g MH								
0+03		Begin project			0+27.4		#7486		181W 827W 31st			2-24-56
1+0	96.2	88.74	7.5		0+91.8		#7466					2-23-56
					1+63.5		#7378		723W 30th			2-13-56
2+0	94.6	88.94	5.7		2+42.5		#7375	2552 6016	117W 30th	117 35th		2-13-56
3+0	94.8	89.14	5.7	3+01.1	3+13.6		#7366		707W 30th			2-9-56
					3+79.6		#7367		703W 30th			2-2-56
4+0	95.2	89.34	5.9	3+99.6	4+49.4		#7368		623W 30th			2-10-56
5+0	95.1	89.54	5.6		5+20.0		#7366		627W 30th			1-30-56
					5+85.5		#7306		621W 30th			1-31-56
6+0	95.5	89.74	5.8		6+59.8	6+61.8	#7305		615W 30th			1-21-56
	95.4	89.78	5.6	6+20.1	7+27.6	7+29.6	#7304		613W 30th			1-31-56
7+0	95.8	89.94	5.9		7+95.6	7+98.6	#7295		603W 30th			1-30-56
8+0	95.6	90.14	5.5		8+71.0		#7105		541W 30th			3-2-56
9+0	95.6	90.34	5.3		9+23.1							
	95.6	90.38 out 90.49 in	5.2 5.1			Y East						
10+0	95.7	90.64	5.1		10+27.4							2-14-56
	95.6	90.69 out 90.78 in	4.9 4.8			Y South						
	95.9	90.86	5.0		10+62.0		#7420		3133 4th			2-20-56
Line #1-A 0+0	95.9	90.48	5.4	0+00 = 9+23.1 in line #1		Y East						
	95.9	90.58	5.3		0+49.8		#7399		3123W 30th			2-14-56
Line #2 0+0	96.1	88.42	7.7	0+00 Exist'g MH		North SOUTH						
1+0	95.9	88.62	7.3		0+50.3		#7486		805W 30th			2-24-56
2+0	95.9	88.82	7.1		1+40.5		#7379		813W 30th			2-9-56
					2+03.9		#7481		821W 30th			2-24-56
					2+74.6		#7467		729W 31st			2-23-56
3+0	97.0	89.02	8.0		3+47.4		#7365		825W 30th			2-7-56
4+0	96.6	89.22	7.4		4+20.2		#7364		841W 30th			2-7-56
					4+80.3		#7363		905W 30th			2-9-56
5+0	95.4	89.42	6.0	4+97.9	5+56.5		#7362		911W 30th			2-9-56
6+0	95.2	89.62	5.6		6+28.6		#7361		917W 30th			2-9-56
					6+96.9		#7360		925W 30th			2-9-56
7+0	95.8	89.82	6.0		7+62.5		#7359		731W 30th			2-9-56
8+0	95.4	90.02	5.4	8+00.2	8+48.4		#7358		939W 30th			2-9-56
9+0	95.6	90.22	5.4		9+10.9		#7374		1001W 30th			2-7-56
					9+72.7		#7357		1009W 30th			2-7-56
10+0	95.6	90.42	5.2		10+44.8		#7356		1127W 30th			2-9-56
	95.6	90.62	5.0	11+00.0	11+14.0		#7400		703W 30th			2-14-56
					11+96.1	11+94.1	#7355	1585	3113 30th	3132 S Seneca		2-12-56
12+0	95.3	90.82	4.5		12+01.0		14656		3118 S Seneca			9-12-61

CAT. 36 33. 22  
 0+00 94.7 89.50 in 5.2 0+00  
 1+25 95.2 89.75 4.25 PLUGGED IN  
 2000 00 57+ 90.5 1027-26 W 31st  
 1+96.0 (O.H.)  
 1156 mg #1206-1014 W 31st  
 2000 00 54 #11700-1016-12-20 31st  
 #84886 deal 0-1014 W 31st  
 #84887-1014 W 31st  
 13042 Top 3110 + Exchange  
 13766 Top 3130-322 Seneca  
 97-15592-7 9-11-97 3150 S. Seneca  
 116-59  
 6-29-60 (57076)  
 1-13-61 (11477)  
 Todd Pfluy

see pg 109 for drawing