


GLENN AVE.

ROAD

AVE.

1	135'	100'	60
2		13+00.7	59
3		M.H.	58
4		5'	57
5			56
6			55
7			54
8			53
9			52
10			51
11			50
12			49
13			48
14			47
15			46
16			45
17		10+00.0	44
18		M.H.	43
19			42
20			41
21			40
22			39
23			38
24			37
25			36
26			35
27			34
28		7+52.3	33
29		M.H.	32
30	135'	100'	31

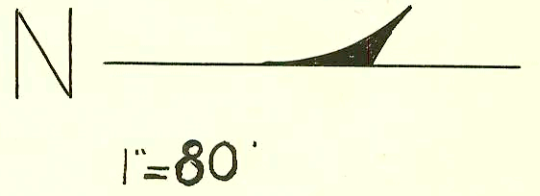

ORIENTA BLVD.

PANWINEE

ATLANTA

1	135'	100'	60
2			59
3			58
4			57
5			56
6			55
7			54
8		5+01.3	53
9		M.H.	52
10			51
11			50
12			49
13			48
14			47
15			46
16			45
17			44
18			43
19			42
20			41
21		2+51.3	40
22		M.H.	39
23			38
24			37
25			36
26			35
27			34
28			33
29			32
30	135'	100'	31

NOTE: LINE PLUGGED

BENNETT AVE.

0+00 Existg M.H. changed -
outside drop & stub in M.H.

LAT. 17, SUB. 3, S.S. 22

BUILDERS CONST. INC., JAN. 23, 1956

BK. NO. K-34, PROJ. NO. C25-72

