


LAT. 2, SUB 9, S.S. #22
DEVELOPMENT INC. CONST. CO. JUNE 28 1956
BK NO. K-22, PROJ. NO. C25-92

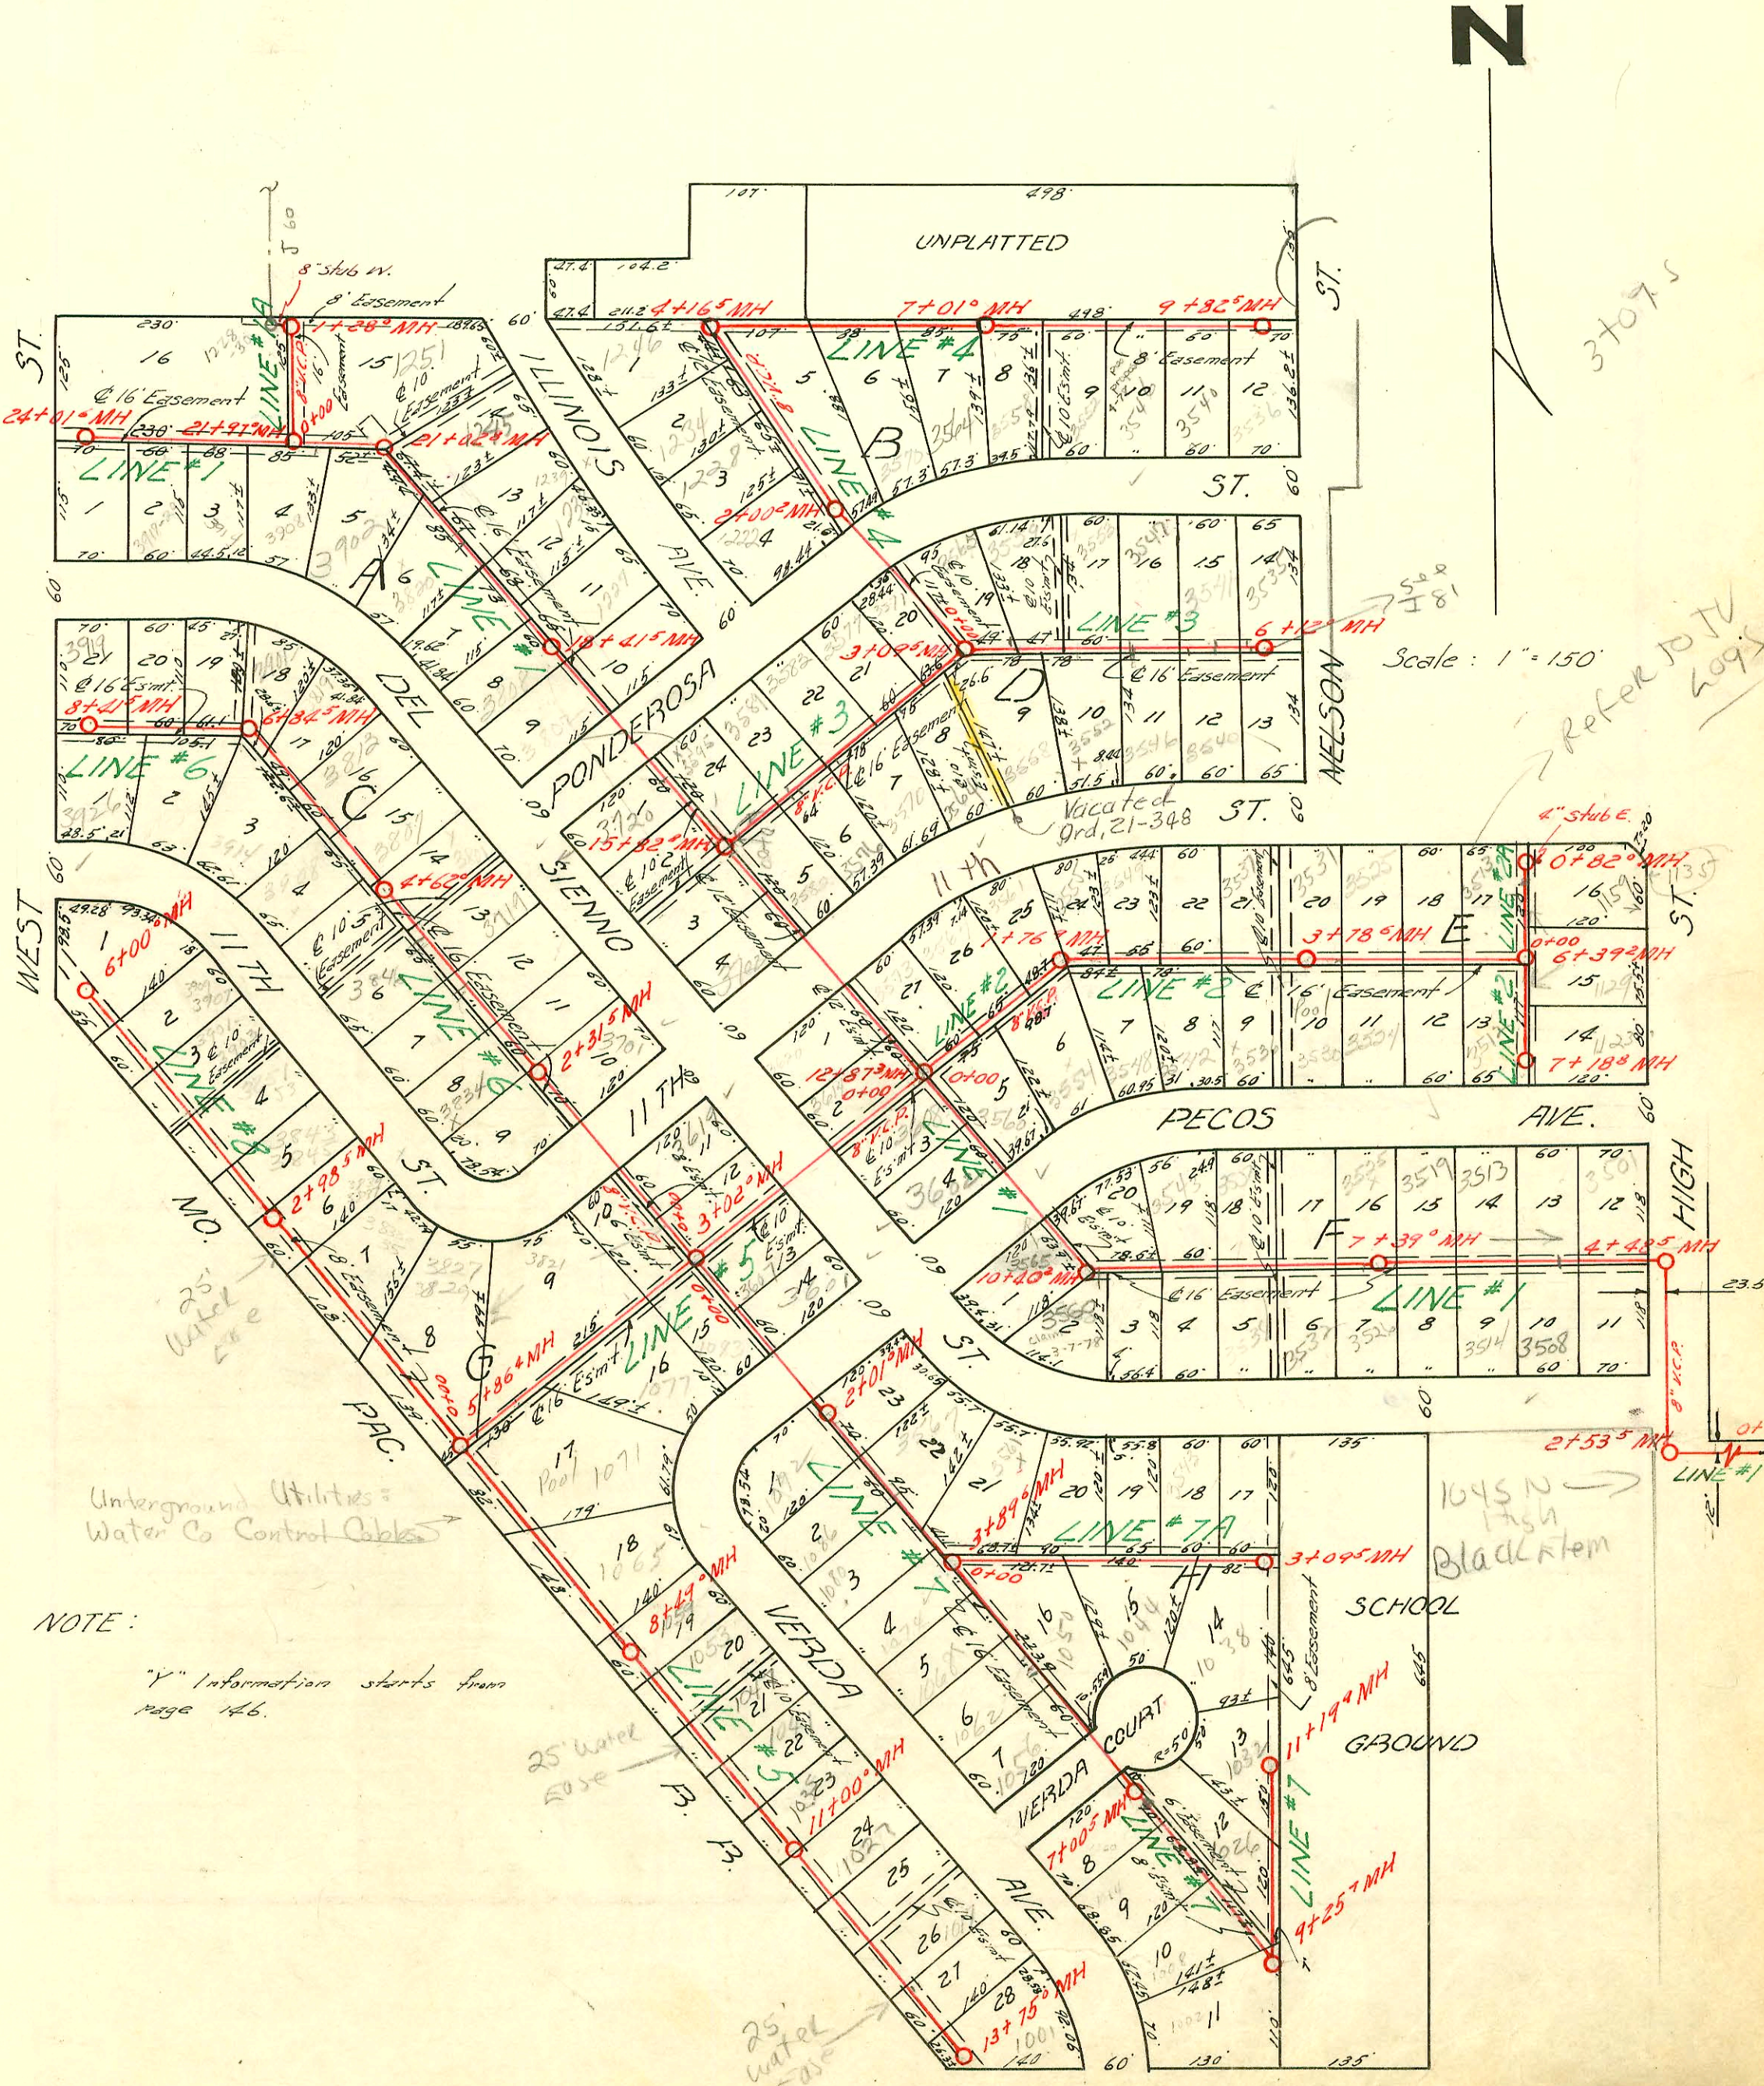

CONSTRUCTION RECORD

SERVICE RECORD

Line #4

Line #5

Line #6

| STATION | ELEVATION | | Depth | MANHOLE | 4-INCH "Y" BRANCHES | | No. of Permit | | House Number | | DATE OF PERMITS | |
|---------|-----------|------------|-------|---------|---------------------|------------|---------------|------------|--------------|------------|-----------------|------------|
| | Ground | Grade | | | North West | South East | North West | South East | North West | South East | North West | South East |
| | | | | | | | | | | | | |
| 7+00 | 125.61 | 117.96 | 7.65 | 7+01° | | | | | | | | |
| | | | | | | +093 | | 7990 | | 8558 | | 8-22-58 |
| | | | | | | +84° | | 7891 | | 8535 | | 8-22-58 |
| 8+00 | 125.00 | 118.16 | 6.84 | | | +51° | | 15151 | | 5546 | | 2-2-62 |
| 9+00 | 124.90 | 119.36 | 6.54 | | | +05° | | | | | | |
| | | | | | | +71° | | | | | | |
| | 125.53 | 118.52 | 7.01 | 9+82° | | | | | | | | |
| 0+00 | | | | | | | | | | | | |
| 1+00 | 123.58 | 115.34 | 8.24 | | | | | | | | | |
| 2+00 | 123.74 | 115.54 | 8.20 | | | | | | | | | |
| 3+00 | 125.57 | 115.74 | 9.83 | 3+02° | +08° | +10° | | B4827 | | 1083 | | 12-23-65 |
| | | | | | +56° | | | | | | | |
| | | | | | | +85° | | B173 | | 1077 | | 9-19-63 |
| 4+00 | 127.32 | 115.94 | 11.38 | | | | | | | | | |
| 5+00 | 126.01 | 116.14 | 9.87 | | "Y" WEST | "Y" EAST | | | | | | |
| | | | | | +13° | | | | | | | |
| | 123.69 | 116.32 | 7.37 | 5+86° | | | | | | 1071 | | |
| 6+00 | 123.43 | 116.44 | 6.99 | | | 6+63.4 | | 813 | | Verda | | 7-24-80 |
| | | | | | | +97° | | | | | | |
| 7+00 | 122.72 | 116.64 | 6.08 | | | 7+67 | | B5131 | | 1065 | | 2-23-66 |
| 8+00 | 123.12 | 116.84 | 6.28 | | | | | | | 1059 | | 12-15-88 |
| | | | | | M.H. | 8+21° | | 22242 | | Verda Ave | | 6/27 '56 |
| | | | | | | +86° | | 25561 | | 1053 | | 5-4-66 |
| 9+00 | 123.19 | 117.04 | 6.15 | | | +41° | | 1268 | | 1047 | | 6/27 '56 |
| 10+00 | 122.66 | 117.24 | 5.42 | | | | | | | Verda Ave | | |
| | | | | | | +07° | | | | | | |
| | | | | | | +62° | | 1267 | | 1035 | | 6/27 '56 |
| 11+00 | 122.50 | 117.44 | 5.06 | 11+00 | | | | | | Verda Ave | | |
| | | | | | | 11+25° | | B5562 | | 1027 | | 5-4-66 |
| | | | | | | 11+83° | | 1266 | | 1023 | | 6/27 '56 |
| 12+00 | 122.06 | 117.64 | 4.42 | | | | | | | Verda | | |
| | | | | | | 12+45° | | 11144 | | 1019 | | 8-3-59 |
| 13+00 | 121.50 | 117.84 | 3.66 | | | | | | | | | |
| | | | | | | +01° | | 1265 | | 1018 | | 6/27 '56 |
| | | | | | | +66° | | 11143 | | 1001 | | 8-3-59 |
| | 121.80 | 117.99 | 3.81 | 13+75° | | | | | | | | |
| 0+00 | | | | 0+00 | | | | | | | | |
| | | | | | | +29° | | #1126 | | | | 7-11-56 |
| | | | | | | +83° | | | | | | |
| 1+00 | 126.70 | 116.04 | 10.66 | | | +05° | | | | | | |
| 2+00 | 125.54 | 116.24 | 9.30 | | | | | | | | | |
| | | | | | | +26° | | #1422 | | 3806 | | 7-11-56 |
| | | | | | | | | | | 10-11-56 | | |
| | 125.83 | 116.30 | 9.53 | 2+31° | | +78° | | 11620 | | 3834 | | 6-24-57 |
| | | | | | | | | | | W.11th | | |
| 3+00 | 124.59 | 116.44 | 8.15 | | | +00° | | #2062 | | 3707 | | 8-16-56 |
| | | | | | | +36° | | #1421 | | 3713 | | 7-11-56 |
| | | | | | | +99° | | #1420 | | 3702 | | 8-14-56 |
| | | | | | | | | #5872 | | 3719 | | 7-11-56 |
| | | | | | | | | 5568 | | 3740 | | 12-18-57 |
| | | | | | | +49° | | 5674 | | 3740 | | 1-11-57 |
| | | | | | | | | | | 3801 | | 12-3-57 |
| | 124.36 | 116.76 | 7.60 | 4+62° | | | | | | Del Sienna | | |
| | | | | | | | | | | | | |
| 5+00 | 124.87 | 116.84 | 8.03 | | | +23° | | #5672 | | 3908 | | 12-3-57 |
| | | | | | | +75° | | 1416 | | 3915 | | 7-10-56 |
| | | | | | | | | | | Del Sienna | | |
| 6+00 | 125.00 | 117.04 | 7.96 | | "Y" NORTH | "Y" SOUTH | | | | | | |
| | | | | | | +32° | | 4347 | | 3819 | | 4-17-56 |
| | | | | | | 6+75° | | 3927 | | Del Sienna | | 2-27-57 |
| | 125.22 | 117.30 IN | 7.92 | | | | | | | | | |
| | 124.98 | 117.20 OUT | 7.72 | 6+84° | | | | | | | | |
| 7+00 | 125.18 | 117.34 | 7.84 | | | | | | | | | |
| | | | | | | +22° | | | | | | |
| | | | | | | | | | | | | |
| | | | | | | +48° | | #1419 | | 3700 | | 7-11-56 |
| | | | | | | | | | | | | |
| 8+00 | | | | | | +87° | | | | | | |
| | | | | | | | | | | | | |
| | | | | | | +14° | | 12814 | | 3926 | | 5-20-60 |

#1416 - Tap - C.R. Leidy Bldg. - 3907 Del Sienna 7-10-56
 #2013 - ✓ ✓ ✓ 3807 ✓ ✓ 8-16-56
 #2014 - ✓ ✓ ✓ 3813 ✓ ✓ ✓
 #2010 - Tap - 3914 W. 11th - C.R. Leidy - 11-30-56
 9075 Tap 3619 Del Sienna Hubert Jost 1-29-59 (3+87 line 6)
 9315 Tap 3540 Ponderosa Judy 2-6-59 (8+94.5 line 4)
 10138 Tap 3536 Ponderosa Judy 4-21-59 (4+69)
 11980 Tap 1071 Verda Ave Leidy 12-10-59 (4+88.7)
 #B5132 - 1041 Verda - Joe's Sewer Service - 2-23-66 - Tap (10+29.8)

