


LAT. 24 S.S. # 22  
 DEVELOPMENT INC. JULY 18, 1956  
 BK. NO. 32 PROJ. NO. C25-101  
 LK-34

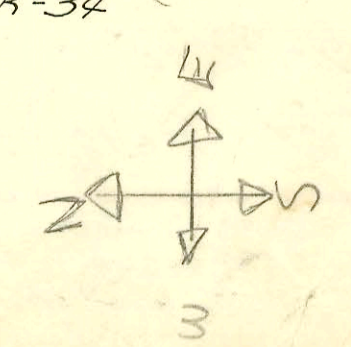

163.

CONSTRUCTION RECORD

SERVICE RECORD

Line # 2 cont.

Line # 2A

Line # 3

Line # 4

Line # 5

STATION	ELEVATION		Depth	MANHOLE	4-INCH "Y" BRANCHES		No. of Permit		House Number		DATE OF PERMITS	
	Ground	Grade			North West	South East	North West	South East	North West	South East	North West	South East
9+00	128.6	119.40	9.20		+40°							
	128.7	119.63 OUT 9.07 119.74 IN 8.96		9+77°	+83°(W)		10495		2544 Bullinger		6-10-59	
10+00	128.9	119.80	9.10		+10+37 4" sch 40 +34°(W)		4457647		2657 R Bullinger		4-18-54 8-15-56	
	129.0	119.95	9.05	10+42°								
0+00	128.6	119.75	8.85		+24°(W)		8114		2542 Bullinger		7-8-58	
	128.2	120.03	8.17	0+82°	+76°(W)		7498		2506 2507 Manhattan		8-15-52	
0+00	127.72	116.26	11.46	8" stub E 0+00	+36°	+38°	#1807	#1302	2503 Manhattan 2504 W 24th		8-3-56	8-3-56
1+00	128.1	116.66	11.44		+18°	+20°	#1808	#1689	2507 Manhattan 2510 W 4th		10-8-56	10-8-56
	128.2	117.06	11.14		+71°	+73°			2511 2512 Manhattan		8-3-56	
2+00	128.2	117.26	10.94	2+49°	+63°	+65°	#1500	#5401	2525 2526 Manhattan W 24th		9-21-56	9-26-57
3+00	128.9	117.46	11.34		+22°	+24°						
4+00	128.9	117.86	11.04			+78°		6438	2604 W 24th			3-31-57
5+00	128.6	118.26	10.34	5+00°					see below			
					+5+19°	+50°	#1924 #1925 #1926	#1664	2509 2611 Manhattan	2610 W 24th	8-15-56 4-20-50 8-16-59	8-11-57
6+00	129.0	118.66	10.34		+24°	+26°	5993	#1965	2619 Manhattan	2618	1-7-58	7-10-52
					+97°	+99°	5621	#1991	2628 Manhattan	2629	11-13-57	8-15-54
7+00	129.2	119.06	10.14		+65°	+67°		12555	2506 Bullinger			5-2-60
	129.6	119.38 OUT 10.22 119.48 IN 10.12		7+81°	+99°(W)							
8+00	128.5	119.56	8.94			+52°		#1993	2601 Manhattan			8-10-56
	128.3	119.76	8.54	8+58°								
0+00	130.21	115.65	14.56	8" stub E 0+00	+33°	+35°		8769	2524 Columbie			11-24-58
1+00	129.8	115.89	13.91		+17°	+19°	#1694	#1688	2511 W 24th	2532 R Columbie	7-21-56	7-21-56
					+54°	+56°		10182	2538 Columbie			4-29-59
2+00	129.4	116.13	13.27		+38°	+40°	#1695	#1689	2533 W 24th	2541 Columbie	7-21-56	7-21-56
					+81°	+83°	8983	7074	2529 W 24th	2539 Columbie	1-2-59	6-4-57
3+00	129.1	116.38	12.72	3+03°	+61°	+63°	#1696	#1670	2537 W 24th	2556 Columbie	7-21-56	7-21-56
4+00	129.1	116.61	12.49		+12°	+14°	#1697	#1691	2603 W 24th	2602 Columbie	7-21-56	7-21-56
5+00	128.8	116.85	11.95		+54°	+56°	#2839	#2857	2607 W 24th	2610 Columbie	10-22-56	10-22-56
6+00	129.2	117.09	10.13		+50°	+52°	#1698	#1692	2617 W 24th	2618 Columbie	7-21-56	7-21-56
	129.1	117.11	11.99	6+09°	+83°	+85°	4826	#2830	2633 W 24th	2626 Columbie	6-25-57	10-28-56
7+00	128.5	117.33	11.17		+85°	+87°	#1687	#1693	2503 Bullinger	2634 Columbie	7-21-56	7-21-56
8+00	128.3	117.57	10.73		+36°	+38°	4433	#1113	2511 Bullinger	2704 Columbie	4-24-57	1-18-57
9+00	128.3	117.81	10.49			+9+08°		6318	2710 Columbie			2-25-58
	127.7	117.85	9.85	9+18°		+65°		#1432				8-13-56
10+00	127.2	118.05	9.15			+47°						
	126.2	118.22	7.98	10+72°								
0+00	127.7	117.95	9.75	0+00 existing	Y WEST +48°	Y EAST +46°						

#1992 - Tap - 2633 Manhattan - Bryant Park - 8-15-56  
 #1824 - tap - 2534 W 24th - 8-3-56  
 #1809 - tap - 2533 Manhattan - 3-27  
 #2623 Tap - 2726 Columbie - 10-1-58  
 #1823 - tap - 2518 W 24th - 10-1-58  
 #1825 - tap - 2503 Manhattan - 5/20/57  
 #1826 - tap - 254 Bullinger - 5/20/57

#1885 Tap - 2414 Hyacinth - Ray - 7-18-57  
 #4884 Tap - 2517 Bullinger - 7-18-57

20050964 4/2/00 Red 2611 W Manhattan - A Good Plumber  
 It was discovered that ORS sewer line was not connected  
 to house - Still on site. Field verified by Calvin Fugitt  
 Super. Sewer Maint Div. Drain layer installed  
 4" sch 40 and connected to eye.

No. 3. A