

812 S/B  
808  
wants  
Double  
line  
10/2


Note  
784 N West St  
assigned an add'l  
address of 790 N West  
on 3/3/2000  
BR

LAT. 31 S.S. #22  
UTILITY CONTRACTORS INC., 25 SEPT 36  
BK. NO. K-43 PROJ # C26-6

#15666 tap 711 on bridge on Bluff St 5-22-62  
#4014 tap 760 N. West St. by S. by 8-25-65

SANITARY SEWER ABANDONMENT  
FOR NBW BUILDING ADDITION  
PROJ. NO. N/A  
BUILT BY BRADFORD CO.  
BOOKED 7-17-97 JKB FROM AS BOICE

Scale 1" = 150'

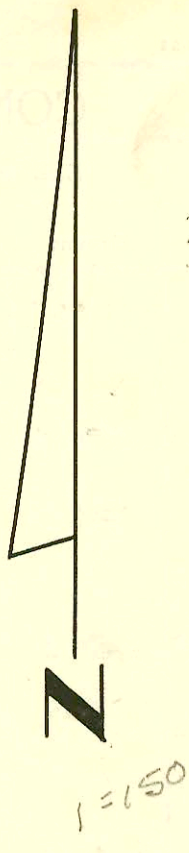

### CONSTRUCTION RECORD

### SERVICE RECORD

Line #/

STATION	ELEVATION		Depth	MANHOLE	4-INCH "Y" BRANCHES		No. of Permit		House Number		DATE OF PERMITS	
	Ground	Grade			North West	South East	North West	South East	North West	South East	North West	South East
0+00	120.6	110.0	10.6	Existing MH								
					+907	+615		C8300	3302 W Central			5-15-68
1+00	119.4	110.1	9.3			+596						
2+00	118.8 119.1	110.2 110.3	8.6 8.8	2+43°								
3+00	119.2	110.4	8.8		3+41.8°	+62°						
4+00	119.5	110.5	9.0		4+55.0°	+62°						
5+00	119.7 120.2	110.6 110.7	9.1 9.5	5+56°								
6+00	121.9	110.7	11.2		+40 +69°	+78°						
7+00	124.9 124.9	110.8 110.9	14.1 14.0	7+155°								
8+00	122.6	111.0	11.6		+758 +955	+103°						
9+00	121.0 121.2	111.1 111.1	9.9 10.1	9+246°		+67°						
10+00	122.1	111.2	10.9			+99°						
	121.0	111.3	9.7	10+674°		+256°						
11+00	121.0	111.3	9.7		+984°	+964°						
12+00	121.3 121.2	111.4 111.5	9.9 9.7	12+217°		+645°						
13+00	121.8	111.6	10.2			+625°						
14+00	121.4 121.3	111.7 111.7	9.7 9.6	14+212°		+123°						
15+00	120.9 121.4	111.8 111.9	9.1 9.5	15+81°		+185°						
16+00	122.4	112.2	10.2	16+192°		+61°						
17+00	122.1	112.2	9.9			+408°						
	120.9	112.3	8.6	17+723°		+39°						
18+00	120.7	112.4	8.3			+65°						
19+00	120.2	112.5	7.7			+205°						
20+00	120.7 120.7	112.6 112.8	8.1 7.9	20+773°								
21+00	120.9	112.8	8.1			+408°						
22+00	121.0 121.2	113.0 113.0	8.0 8.2	22+366°		+39°						
23+00	121.7	113.1	8.6			+65°						
24+00	121.5	113.2	8.3	23+926°		+22°						

121.5  
 121.4  
 2