H268A

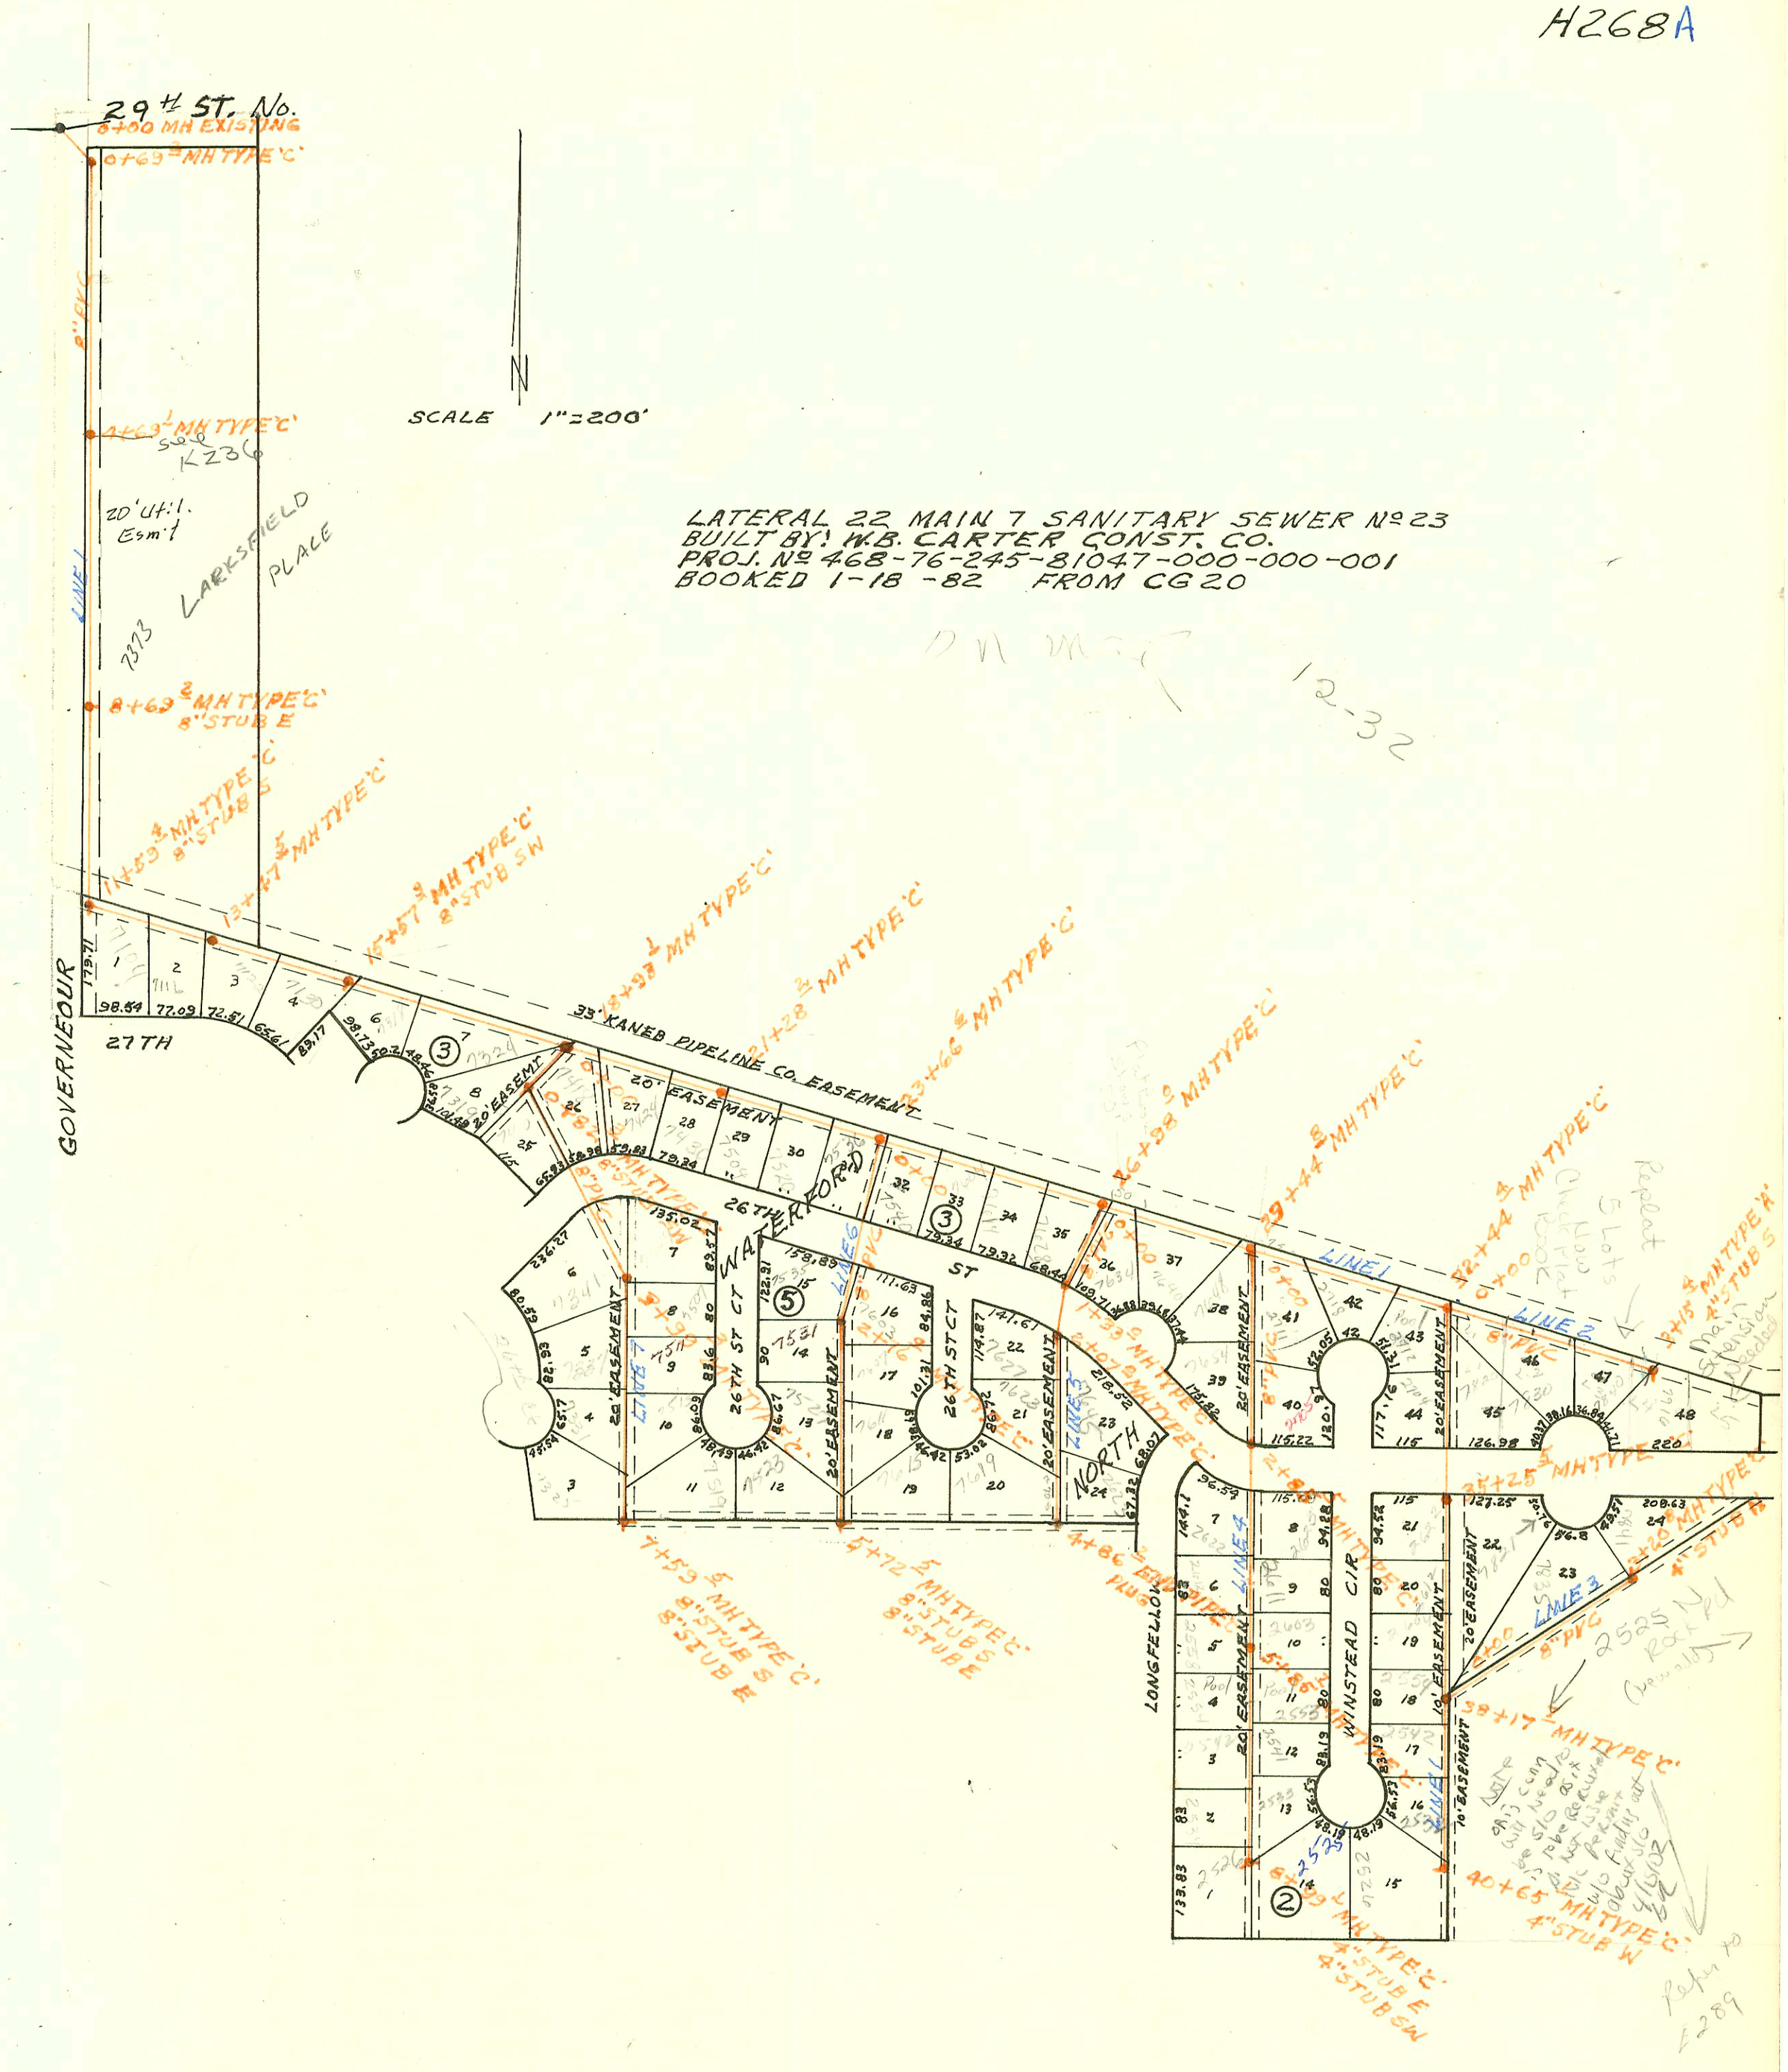
29th ST. No.
0+00 MH EXISTING
0+69 MH TYPE 'C'
8" PVC
4+69 MH TYPE 'C'
see K236
20' Util. Esmt
LARKSFIELD PLACE
7373
LINE 1
8+69 MH TYPE 'C'
8" STUB E
11+59 MH TYPE 'C'
8" STUB S
13+47 MH TYPE 'C'
15+57 MH TYPE 'C'
8" STUB SW
18+98 MH TYPE 'C'
21+28 MH TYPE 'C'
23+66 MH TYPE 'C'
26+98 MH TYPE 'C'
29+44 MH TYPE 'C'
SCALE 1"=200'
N
33' KANEB PIPELINE CO. EASEMENT
GOVERNEOUR
27TH
20' EASEMENT
26TH ST
WATERFORD
26TH ST CT
26TH ST CT
NORTH
LONGFELLOW
WINSTEAD CIR
LINE 2
LINE 3
LINE 4
LINE 5
LINE 6
LINE 7
8" PVC
4" STUB W
40+65 MH TYPE 'C'
4" STUB W
38+17 MH TYPE 'C'
35+25 MH TYPE 'C'
32+20 MH TYPE 'C'
4" STUB E
7+59 MH TYPE 'C'
8" STUB S
8" STUB E
5+72 MH TYPE 'C'
8" STUB S
8" STUB E
4+86 MH TYPE 'C'
2+07 MH TYPE 'C'
0+00 MH TYPE 'C'
4" STUB E
4" STUB W
8+59 MH TYPE 'C'
4" STUB E
4" STUB W
2525

H268

	CONSTRUCTION RECORD							SERVICE RECORD					
	STATION	ELEVATION Ground	ELEVATION Grade	Depth	MANHOLE	4-INCH "Y" BRANCHES North West	4-INCH "Y" BRANCHES South East	No. of Permit North West	No. of Permit South East	House Number North West	House Number South East	DATE OF PERMITS North West	DATE OF PERMITS South East
LAT	22 MAIN 7	SS Nº	23	(CONT'D)									
LINE 3	0+00	220.5	208.58	11.9	0+00=38+17.7 LINE 1								
	1+00	221.3	208.98	12.3					2002 02284		2545 Rockland		8-21-02
	2+00	222.1	209.38	12.7									
	3+00	222.2	209.78	12.4		2+83.8 tap	3+05.8 TAP	8628	2002 02283 18601	7825 E 26th N	2525 N Rockland	7-8-83	8-21-02 6-27-87
		222.2	209.86	12.3	3+20.8	4" STUB N		14162		7841 E 26th N		7-9-85	
LINE 4	0+00	208.4	198.14	10.3	0+00=29+44.8 LINE 1			9994		7648 E 26th N		4-11-84	
	1+00	208.7	199.06	9.6			1+16.4 tap		5323		2711 Winstead		3-9-82
						1+81.5 tap		8809		7654 E 26th N.		7-26-83	
	2+00	209.3	199.98	9.3			2+20.9 tap		6712		2705 Winstead		10-11-82
		209.7	200.77	8.9	2+85.5								
	3+00	209.8	200.90	8.9									
	4+00	210.8	201.82	9.0		4+37.7 tap	4+00.5 tap	6100	6131	2622 Longfellow	2605 Winstead	7-6-82	
							4+69.7 tap		7310		2611 Winstead		1-5-83
	5+00	212.2	202.74	9.5		5+12.7 tap		8661		2612 Longfellow		7-8-83	
		213.5	203.53	10.0	5+85.7			10006		2558 Longfellow		1-12-84	
							5+94.2 tap		6879		2603 N. Winstead		11-1-82
	6+00	213.7	203.66	10.0									
						6+68.7 tap	6+61.7 tap	8662	6878	2554 N Longfellow	2553 Winstead	7-8-83	11-1-82
	7+00	215.4	204.58	10.8		7+48.7 tap	7+34.1 tap	8942	6287	2542 N. Longfellow	2541 Winstead	8-9-83	8-4-83
	8+00	216.4	205.50	10.9		8+52.6 tap	8+18.1 tap	10061	8051	2534 Longfellow	2533 Winstead	1-26-84	5-5-83
		218.6	206.41	12.2	8+99.1	4" STUB SW	4" STUB E	13501	5242	2526 Longfellow	2525 Winstead	4-17-85	2-24-82
LINE 5	0+00	203.6	193.22	10.4	0+00=26+98.0 LINE 1								
									7556		7634 E 26th N		2-28-83
	1+00	203.3	193.62	9.7									
		202.7	193.75	9.0	1+33.0								
	2+00	203.1	194.02	9.1									
		203.2	194.05	9.2	2+07.0	2+22.5 tap		7180		7627 E 26th Ct N		12-15-82	
	3+00	204.2	194.42	9.8		3+10.0 tap		6098		7623 E 26th Ct		7-6-82	
							3+57.0 tap		7169		7645 E. 26th N.		12-15-82
	4+00	204.7	194.82	9.9			4+47.0 tap		7390		2623 N. Longfellow		1-20-83
	4+86.2	205.9	195.16	10.7	PLUG	4+55.8 tap		7248		7619 E Ct 26th N		12-27-82	
LINE 6	0+00	197.3	186.61	10.7	0+00=23+66.6 LINE 1								
	1+00	197.3	187.81	9.5									
	2+00	198.7	189.01	9.7		2+37.2 tap		8052		7535 E. 26th Ct N		5-5-83	
		200.8	189.92	10.9	2+76.0		2+56.0 tap		7170		7603 E 26th N		12-15-82
	3+00	200.8	190.21	10.6		3+07.0 tap	3+43.5 tap	7097	8406	7531 E 26th Ct N	7607 E. 26th Ct	12-01-82	6-20-83
							3+74.0 tap		8053		7611 E 26th Ct N		5-5-83
	4+00	202.2	191.41	10.8		4+26.0 tap		6099		7527 E. 26th Ct		7-6-82	
	5+00	203.5	192.61	10.9									
		204.8	193.48	11.3	5+72.5		8" STUB E 8" STUB S						
LINE 7	0+00	194.3	184.33	10.0	0+00=18+93.1 LINE 1								
		195.3	184.73 184.83	10.6 10.5	0+82.3	0+70.0 tap	0+66.0	13714	14151	7319 Longfellow	7418 E. 26th N	5-7-85	7-3-85
	1+00	195.7	184.91	10.8									
	2+00	196.5	185.39	11.1									
	3+00	197.3	185.87	11.4		3+59.3 tap		11687		7341 E 26th Ct N		8-3-84	
		197.7	186.35 186.45	11.4 11.3	3+99.3		3+93.3 tap		7049		7429 E 26th		11-23-82
	4+00	197.7	186.46	11.2									
							4+67.3 tap		7707		7507 E 26th		7-18-83
	5+00	199.7	187.66	12.0		5+01.8 tap	5+46.0 tap	11830	6904	7531 E 26th Ct	7511 E 26th Ct	8-21-84	11-3-82

Form #192-020 (July, 1981)

CONT'D NEXT PAGE