I 17A

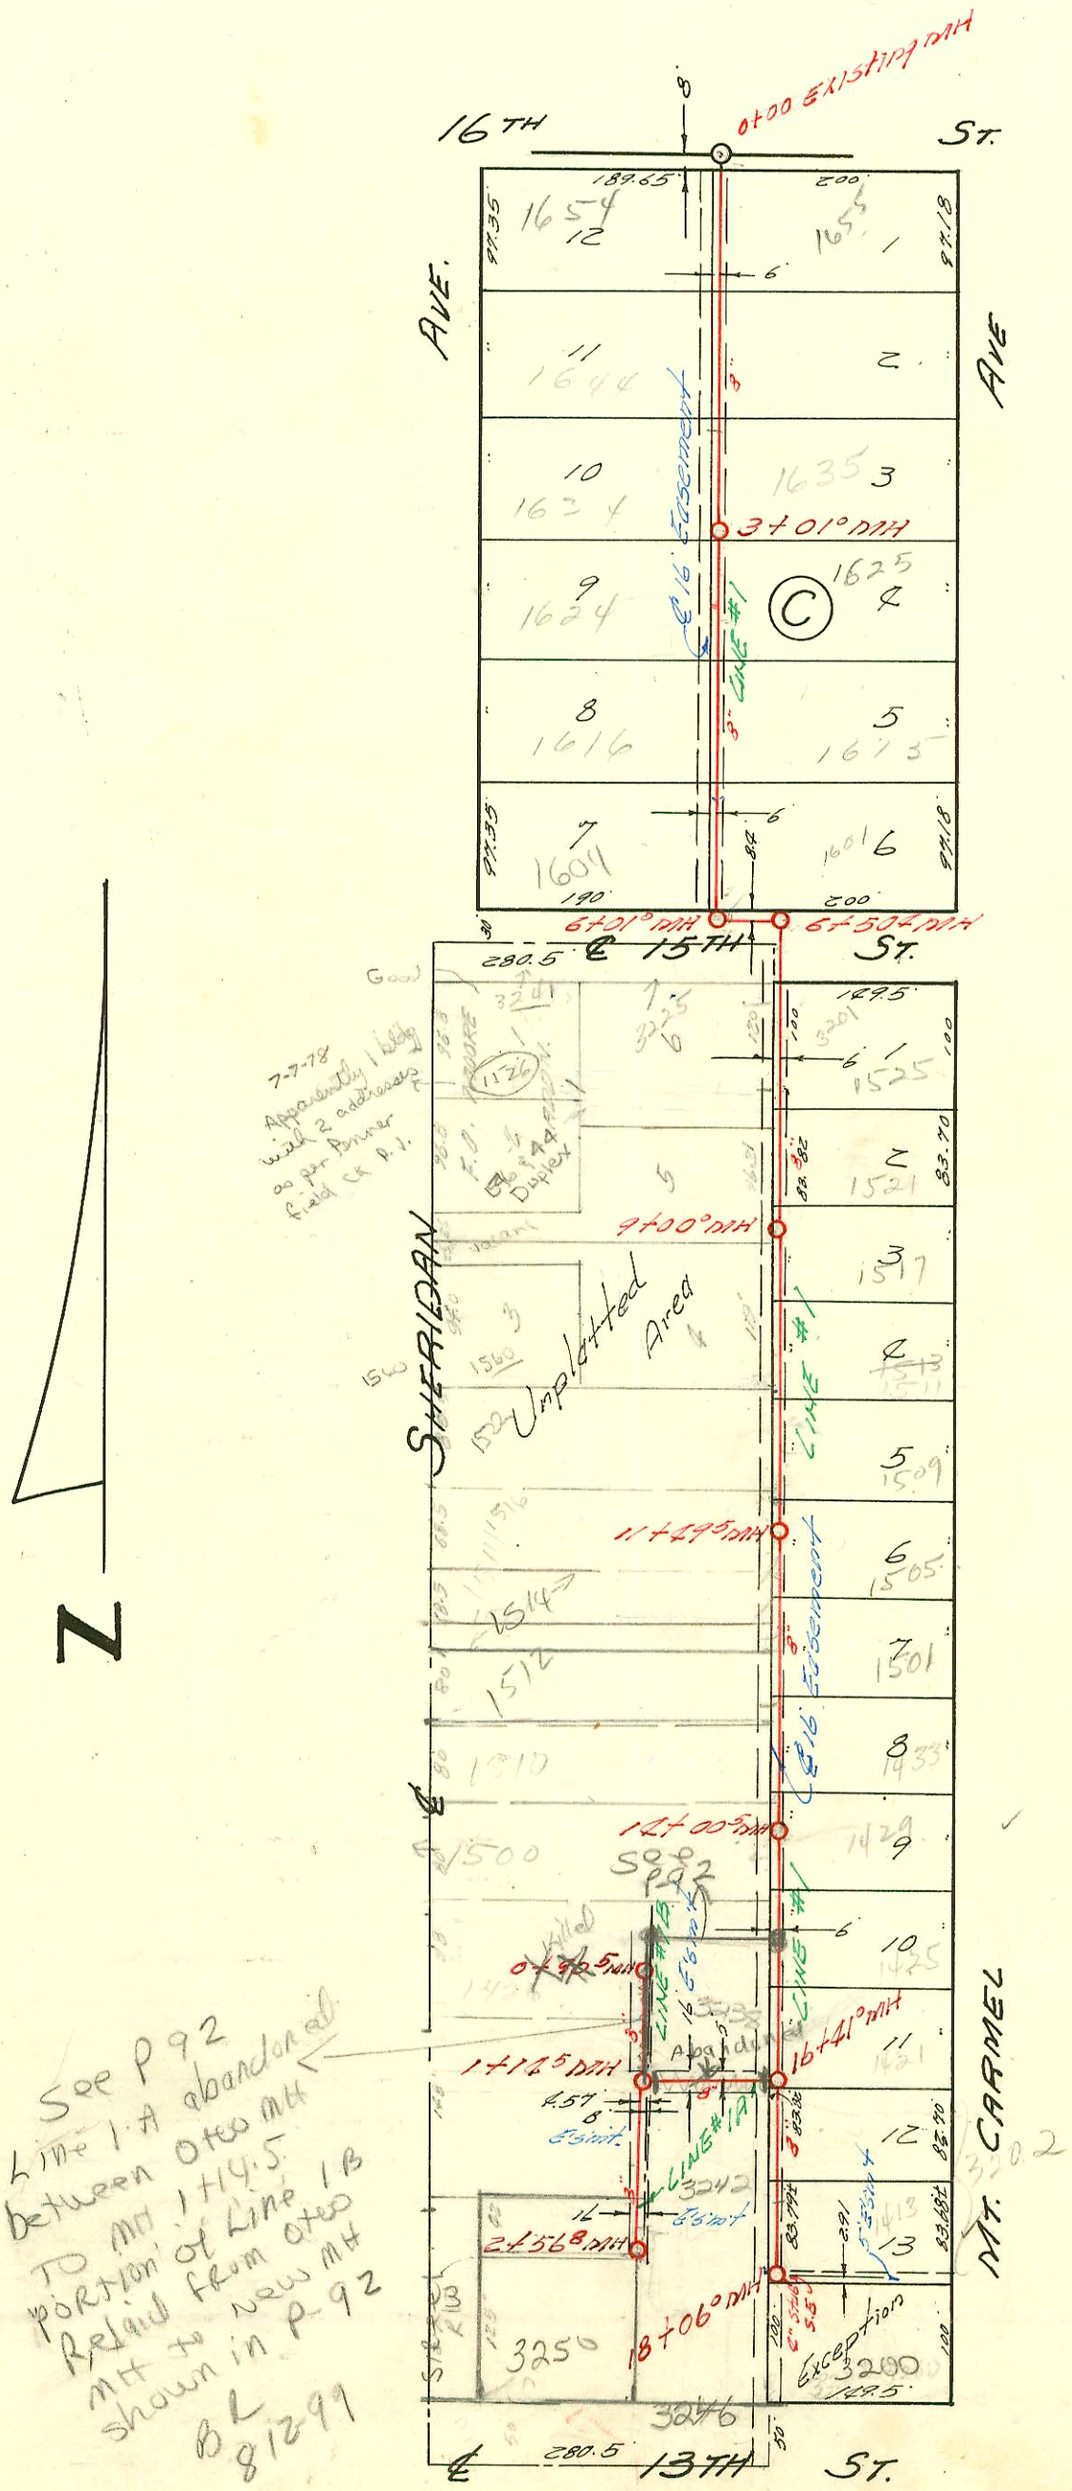

LAT. 8 SUB. 10 S.S. 22
UTILITY CONTRACTORS INC. OCT. 22 '56
BK NO. K-35 PROJECT # C26-57

Form 41-(54) 6-56

	CONSTRUCTION RECORD						SERVICE RECORD					
	STATION	ELEVATION Ground	ELEVATION Grade	Depth	MANHOLE	4-INCH "Y" BRANCHES North ~~West~~	4-INCH "Y" BRANCHES South ~~East~~	No. of Permit North West	No. of Permit South East	House Number North West	House Number South East	DATE OF PERMITS North West	DATE OF PERMITS South East
Line #9	0+00				Existing MH								
	1+00	132.0	122.4	9.6									
	2+00	131.6	122.8	8.8									
						+08°	+10°	7566	7096	3803 Westlawn	3802 W. 19th	7-22-58	6-11-58
		131.6	123.0	8.6	2+49°								
						+68°	+70°	8169	9237	3809 Westlawn	3808 W. 19th	9-25-58	2-20-59
	3+00	131.3	123.2	8.1									
						+79	+99		11639		3814 W. 19th		10-15-59
						+87°	+89°	7567	11713	3821 Westlawn	3820 W. 19th	7-22-58	10-19-59
	4+00	131.1	123.6	7.5									
						+94	+99	8170	9118	3827 Westlawn	3826 W. 19th N.	9-25-58	1-14-59
		131.3	124.0	7.3	4+99°								
	5+00												
						5+08°	+10°	8171	9119	3903 Westlawn	3902 W. 19th N.	9-25-58	1-14-59
						+675	+695	7573	9134	3909 Westlawn	3908 W. 19th N	7-23-58	1-19-59
	6+00	131.4	124.4	7.0									
						6+71	+791	8172	9593	3915 Westlawn	3914 W. 19th	9-25-58	3-12-59
						+776	+796	8286	9592	3921 Westlawn	3920 W. 19th	10-17-58	3-12-59
	7+00	131.8	124.8	7.0									
						+46°	+48°	8008	9227	3927 Westlawn	3926 W. 19th	7-9-58	2-18-59
		131.9	125.0	6.9	7+59°								
	LAT. 8 SUB. 10 S.S. #22												
Line #1	0+00	124.2	115.0	9.2	Existing MH	Y WEST	Y EAST						
						+44	+41	9370		1654 N. Sheridan		2-19-59	
	1+00	124.0	115.3	8.7									
						+44°	+41°	4659		1674 N. Sheridan		5-29-57	
	2+00	124.3	115.6	8.7									
						2+25°	+23°	#2868	#4714	1624 N. Sheridan	1635 N. Mt Carmel	10-24-56	12-7-65
	3+00	126.1	115.9	10.2									
					3+01°								
						3+32°	+30°	20412		1624 N. Sheridan		5-18-56 6-5-59	
						3+66		26079	C70318		1625 N. Mt. Carmel		5-22-79
	4+00	126.3	116.2	10.1									
						4+30°	+28°	20475	4036	1614 N. Sheridan		12-6-90 6-8-59	3-8-57
	5+00	127.4	116.5	10.9									
						5+03							
							+21	#06213 #2908	5351	1604 N. Sheridan		5-1-80 10-26-56	7-23-57
						5+54							
	6+00	127.2	116.8	10.4									
		127.2	116.95 116.83	10.2 10.4	6+01°								
		127.2	117.2 117.1	10.0 10.1	6+50								
	7+00	127.9	117.3	10.6									
							+35°		15672		1525 N. Mt. Carmel		5-24-62
						7+90		#2874		3225 W. 15th		10-24-56	
	8+00	127.5	117.6	9.9									
							+26°		16172		1521 N. Mt. Carmel		9-21-62
	9+00	126.7	117.9	8.8	9+00°								
							+11		1485		1515 Mt Carmel		4-15-64
						9+85°	+83°		#3645		1511 N. Mt. Carmel		1-6-64
	10+00	127.3	118.2	9.1									
						10+36		4517		1500 N. Sheridan		5-10-57	
						10+47°		#3444		1522 N. Sheridan		12-31-56	
							+86°		D1698		1509 N. Mt. Carmel		7-27-64
	11+00	128.6	118.5	10.1									
						+29°		B 3318		1516 N. Sheridan		5-4-65	
		129.2	118.7	10.5	11+49								
						+68°	11 +66°						
							11 +76.5		B4285		1505 N. Mt. Carmel		10-6-65
	12+00	130.5	118.8	11.7									
						12+25		2879		1514 N. Sheridan		10-25-56	
						+27		2880		1514½ N. Sheridan		10-25-56	
							+48		10449		1501 N. Mt. Carmel		6-2-59
						+97		#C31195		1512 N. Sheridan		3-27-72	
	13+00	127.9	119.1	8.8									
							+42		B-1116		1433 N. Mt. Carmel		4-20-64
						+81							
	14+00	126.8	119.4	7.4									
					14+00								
						+18	+16	#B1098	B3372	1510 N. Sheridan	1429 N. Mt. Carmel	3-31-64	5-10-65
	15+00	125.8	119.7	6.1									
						+08 +54	+06						

#2909 - set 6" on 8" wye for swimming pool - Dales - 1607 N. Sheridan 10-26-56
#2517 - 4" [illegible] N of [illegible] 11+49.5, 1560 N. SHERIDAN, 5-10-1957
#6247 - 3238 N. 13th - Dales - 2-17-58 S 10.94' N of MH 2' OFF MAIN - (AE HEARING) 3/9/99
7365 Tap 1413 N Mt Carmel Frederick 6-27-58
8289 tap - 3815 Westlawn - Justice Bldg. 10-17-58 (3+37.6)
10351 Tap 1500 N Sheridan Coleman 5-13-59 14+76.5
B 2369 tap - 1526 N. Sheridan - Bradford Services - 11-23-64 (7+17.8)
B 2370 tap - 1520 N. Sheridan - Bradford Services - 11-23-64 (7+21.3)
B 2668 - tap - 1645 N. Mt Carmel - Van Zehnt Bldg - 1-19-65 (1+85.7)
C67257 - 3241 W. 15th 7-7-78 Severa
99-37711-7