



SHERIDAN AVE.

5TH ST.

AVE.

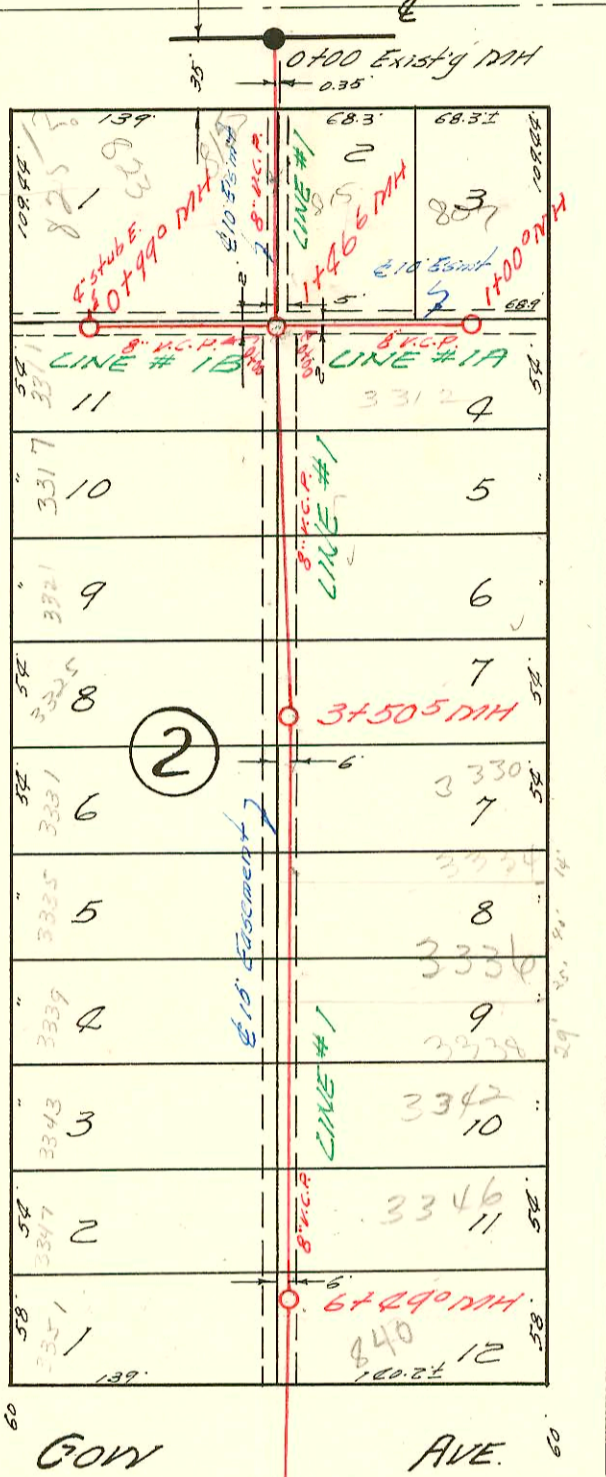

COW AVE.

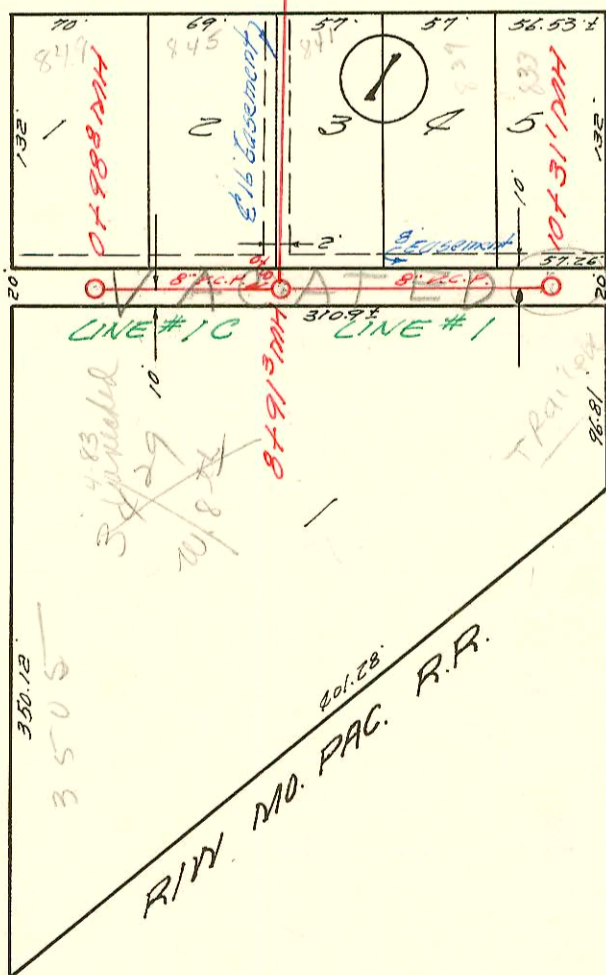

MURDOCK

Illegal MH TAP
 discarded 10/14/89 at trailer
 by Sewer Maint.
 Requested City Inspector
 advise property owner
 that sewer maint will
 seal the TAP and
 repair MH.
 BR
 10/14/89




1"=100'

ORME

NL OF BENEFIT DISTRICT

5TH ST.

MANSFIELD ST.

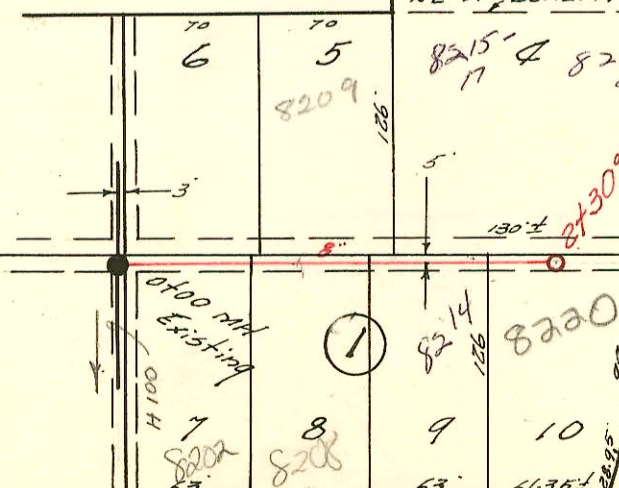

INDIANAPOLIS ST.

RIV. MO. PAC. R.R.

LAT. 12 W.I.S.
 L.C. PEDDICORD CONTR. DEC. 8 '56
 BK. NO. K-39 PROJ. NO. C25-80

LAT. 1 SUB. 9 S.S. 22
 UTILITY CONTRACTORS, INC. NOV. 8 '56
 BK. NO. K-33 PROJ. NO. C25-91

