I-45 A

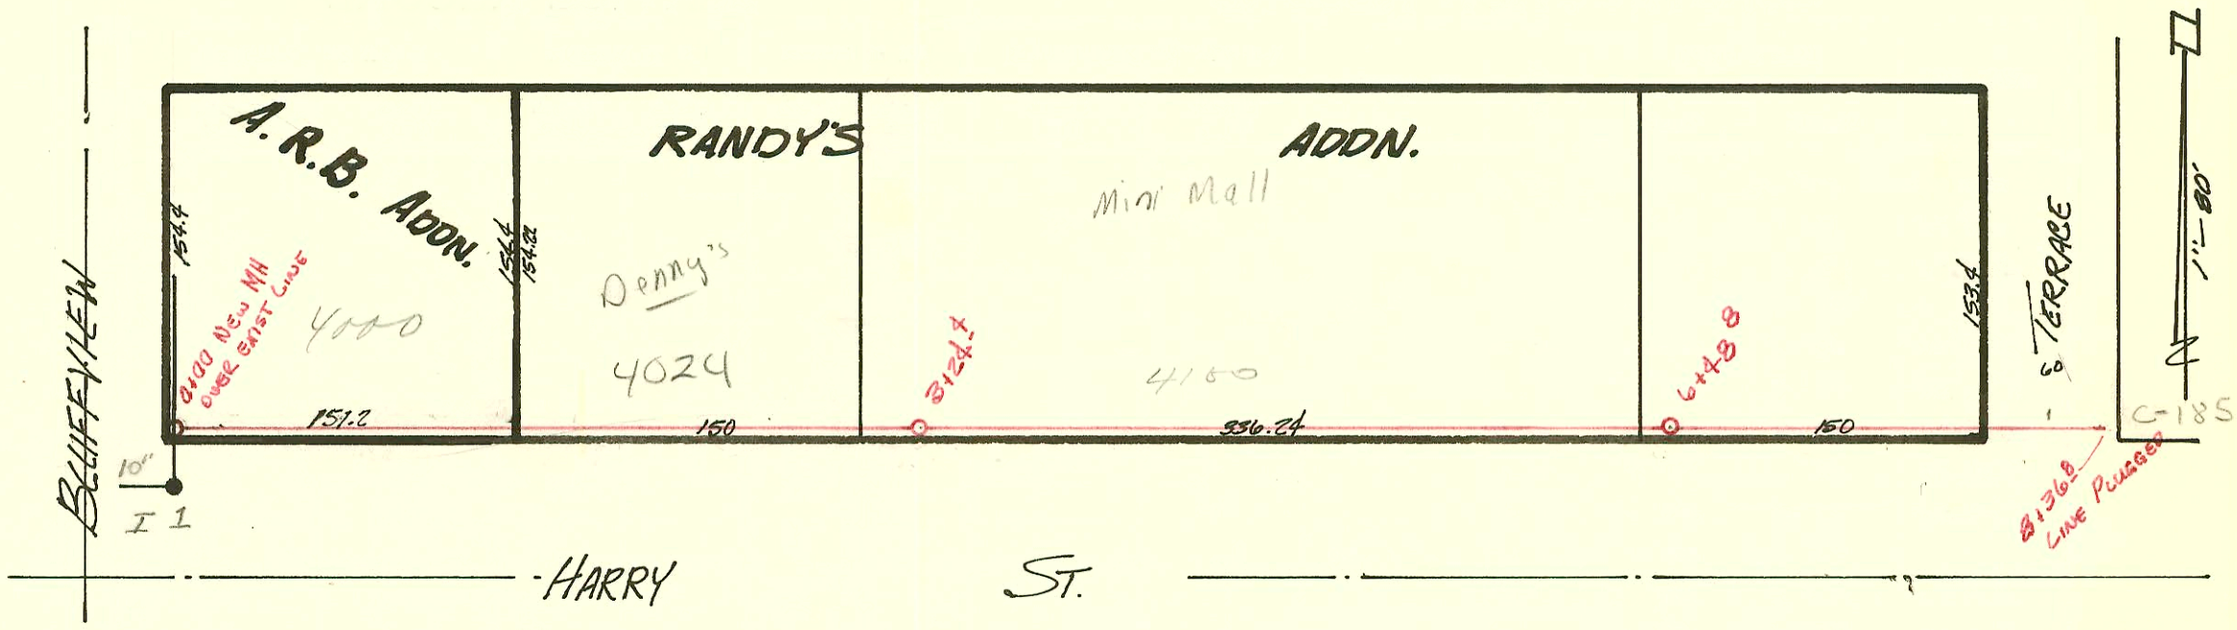

LAT 93. DCS#2. SS#12
BUILT BY MID-STATES CONST CO. INC
BOOKED 29 FEB 72 FROM 266-Y
PROJ NO DBKL 571031

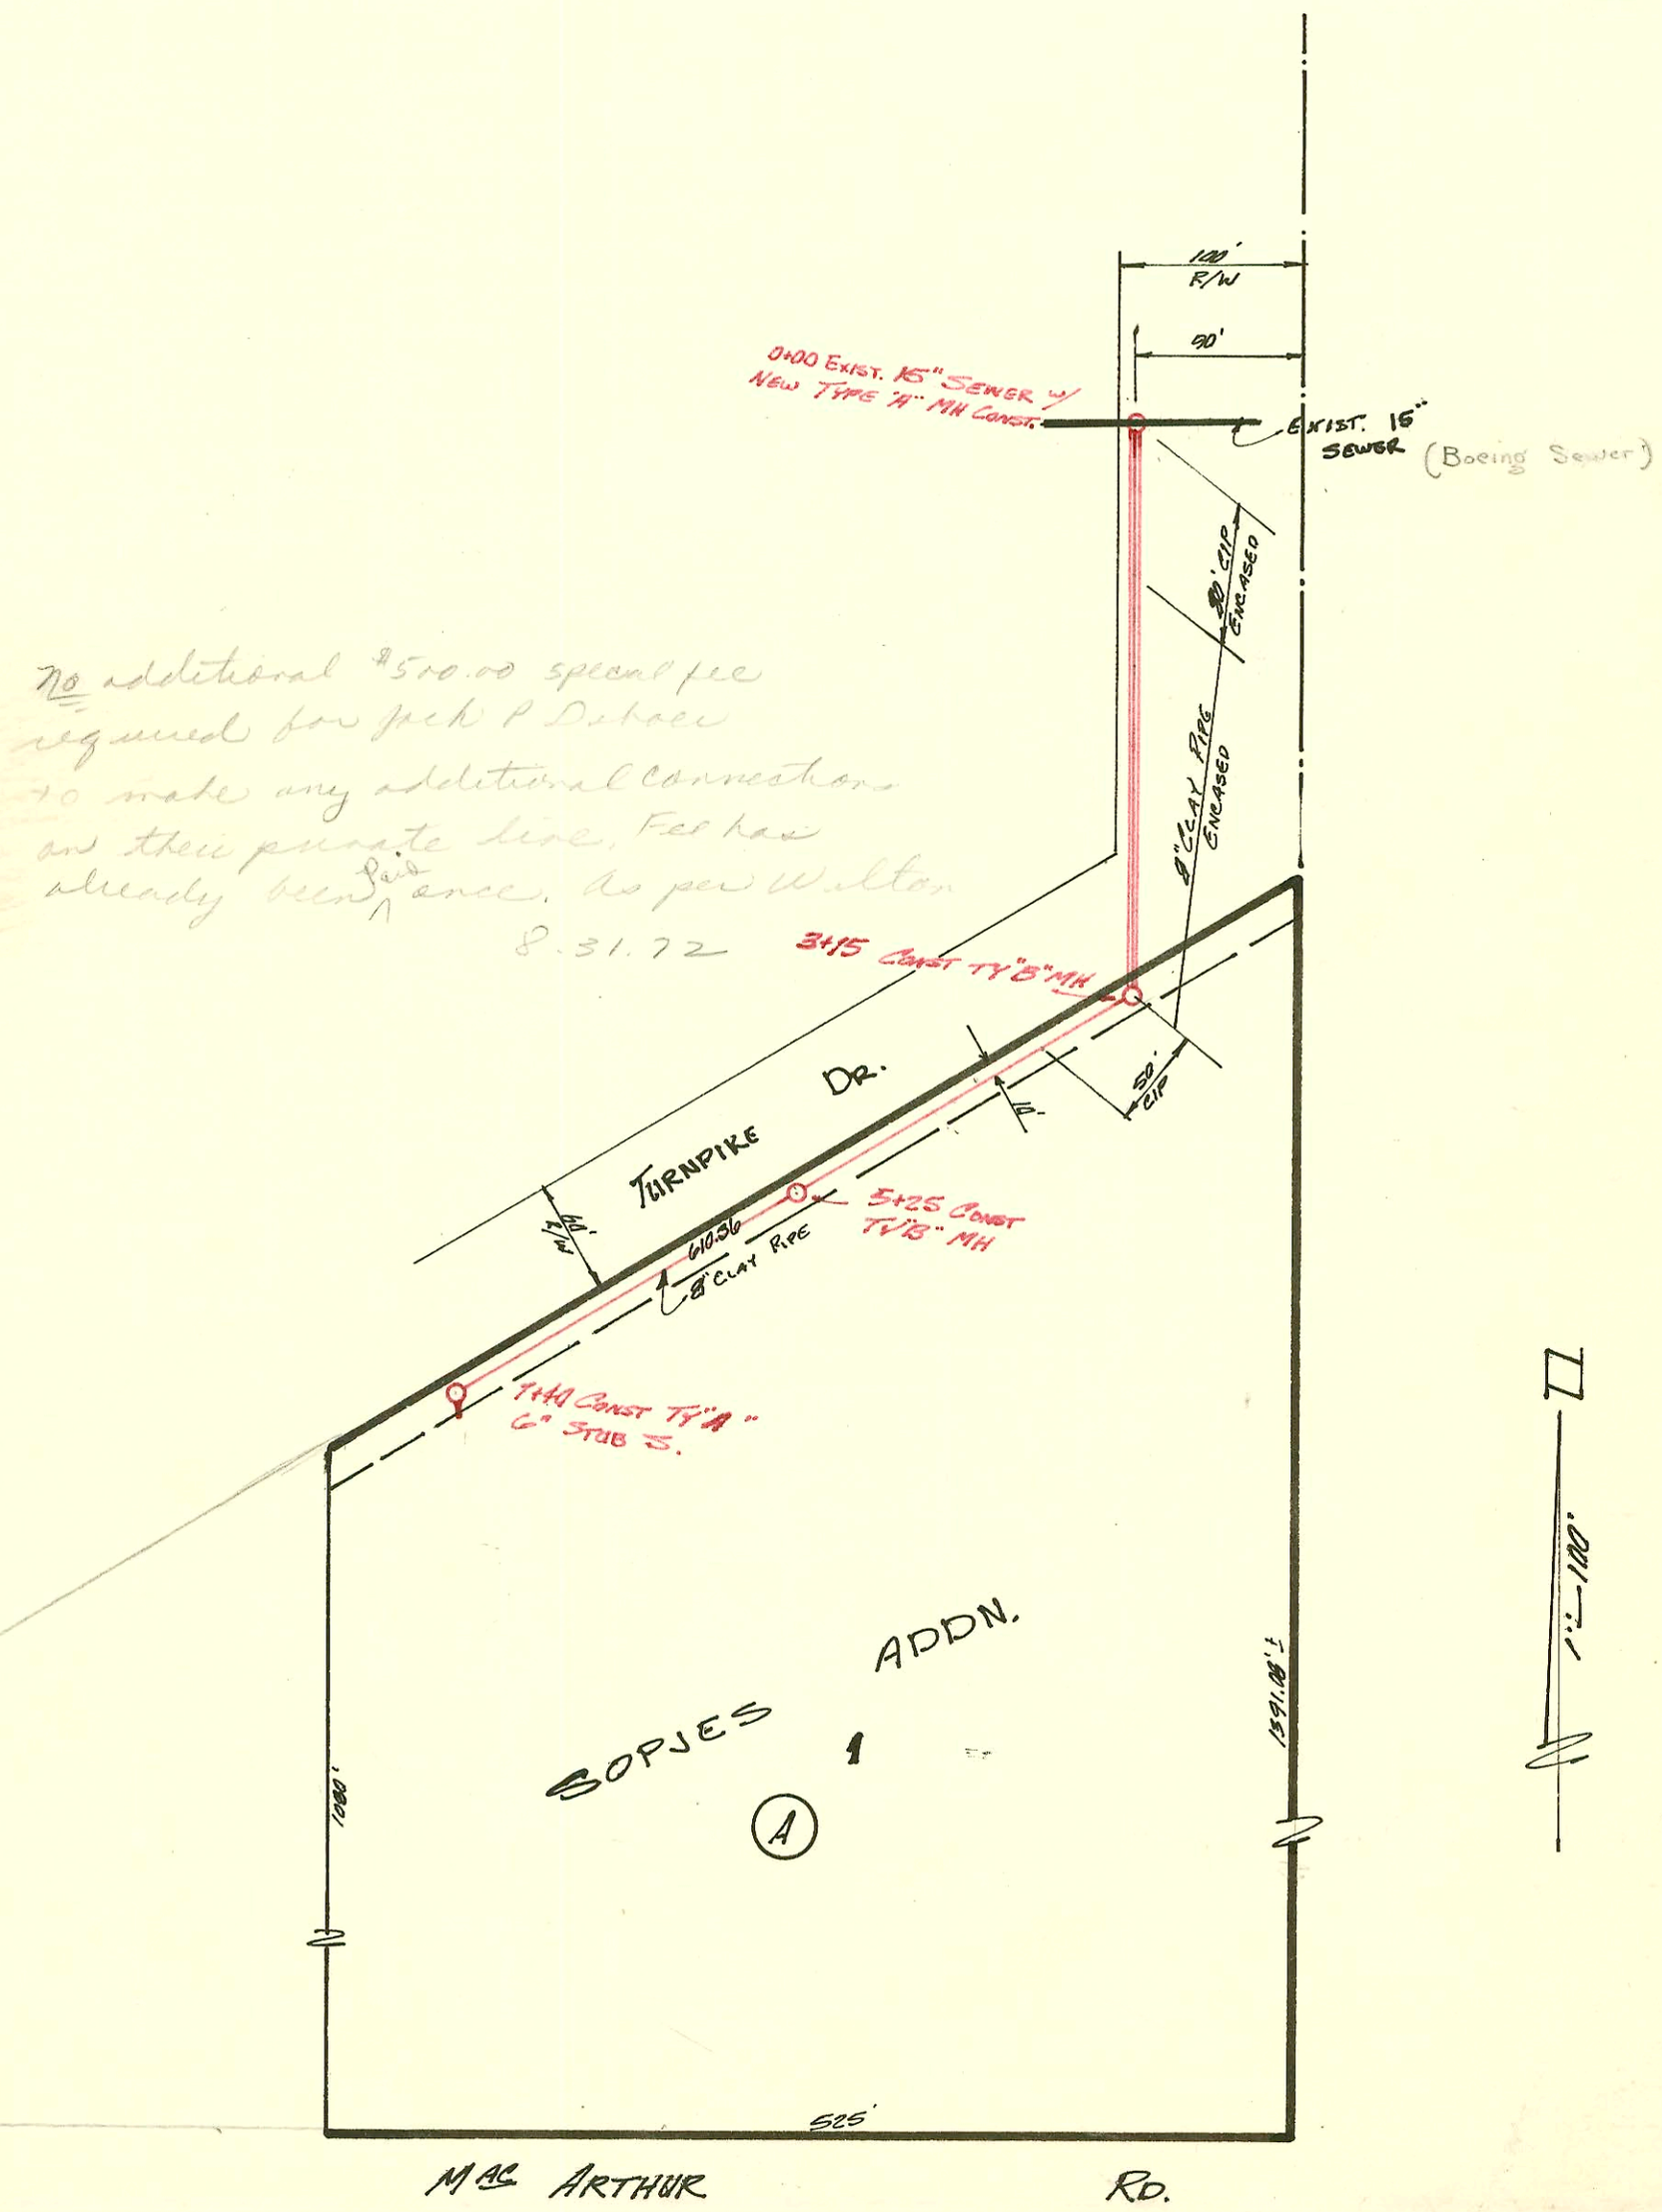

No additional $500.00 special fee required for Jack P. Deboer to make any additional connections on their private line. Fee has already been paid once. As per Walton 8.31.72

PRIVATE S.S FOR DEBOER BUILDING SYSTE.
BUILT BY: ALLIED UTILITIES
BOOKED: 3 MARCH 72 FROM "AS BUILT PLANS"
PRIVATE PROJECT.

I-45

Form 41-(54) 6-56

CONSTRUCTION RECORD							SERVICE RECORD					
STATION	ELEVATION		Depth	MANHOLE	4-INCH "Y" BRANCHES		No. of Permit		House Number		DATE OF PERMITS	
	Ground	Grade			North West	South East	North West	South East	North West	South East	North West	South East
CAT 93, DCS #2, SS #12												
0+00	153.1	141.50	11.6	0+00 NEW MH OVER/EXIST 10" LINE								
				Tap	(0+71.3)		C30762		4000 E Harry		3-1-72	
1+00												
2+00							92-40783-9		4024 E R		11-3-92	
				Tap	2+62.4		C31087		Harry See below		3-21-72	
3+00												
	155.2	142.48	12.7	3+24.4								
				Tap	3+39.4		C34932		4000 E. Harry		9-25-72	
4+00												
5+00												
6+00												
	156.4	143.45		6+48.8								
7+00												
8+00												
8+36.8 LINE PLUGGED @ FLO ELEV. 144.01					New Lower 43.6' W of 8+95.8 New M.H.		C60229		4206 E Harry		3-7-77	
					Refer to C-185							
PRIVATE S.S. FOR DEBOER BUILDING SYSTEMS @ LOT 1 SARIES ADDN.												
0+00	126.9	120.5	6.4	0+00 NEW TY "A" OVER EXIST 15" PIPE (BEG. ENCASEMENT & CIP)								
0+80				END C.I.P. BEG CLAY PIPE								
1+00												
2+00												
3+00												
	135.2	121.76	13.4	3+15 TY "B" (BEG 50' CIP END ENCASEMENT)								
3+65 BEG CLAY PIPE												
4+00												
5+00												
	137.6	122.7	14.9	5+25 TYPB	M.H. TAP		C38951		3900 E MacArthur		5-11-73	
							$500 Spec Fee Pd Rec# 1063916 10/20/71 Jack B. DeBoer Bldg System (fee for Outside City Limits)					
6+00												
7+00												
	132.5	123.56	8.9	7+40 TYA 4/6" STUB S			C31875		4-154 McCullen		4-27-72	
C75495 - 3426 E. MacArthur - 11-27-79 Jack Brannon (4" ABS 4" Stub into New MH.)												

C 34932 - 4100 E. Harry - Joe Spaulding - 9-18-72

93-40783-9 11-3-93 4024 E Harry - McCullough R-P (4" ABS install Mud & sand TRAP in parking lot. Repl line to just past Oil & sand TRAP appox 20' out to S. of Bldg)