



LAT. 48 D.C.S. #2 S.S. 12
 UTILITY CONTRACTORS, INC. MAY 1, 1957
 BK NO. K-44 PROJ. NO. C 26-76
 FILE NO. 6-1-24

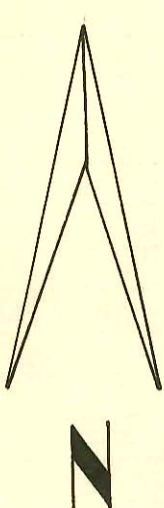


SCALE 1" = 100'

St. Louis Ave.

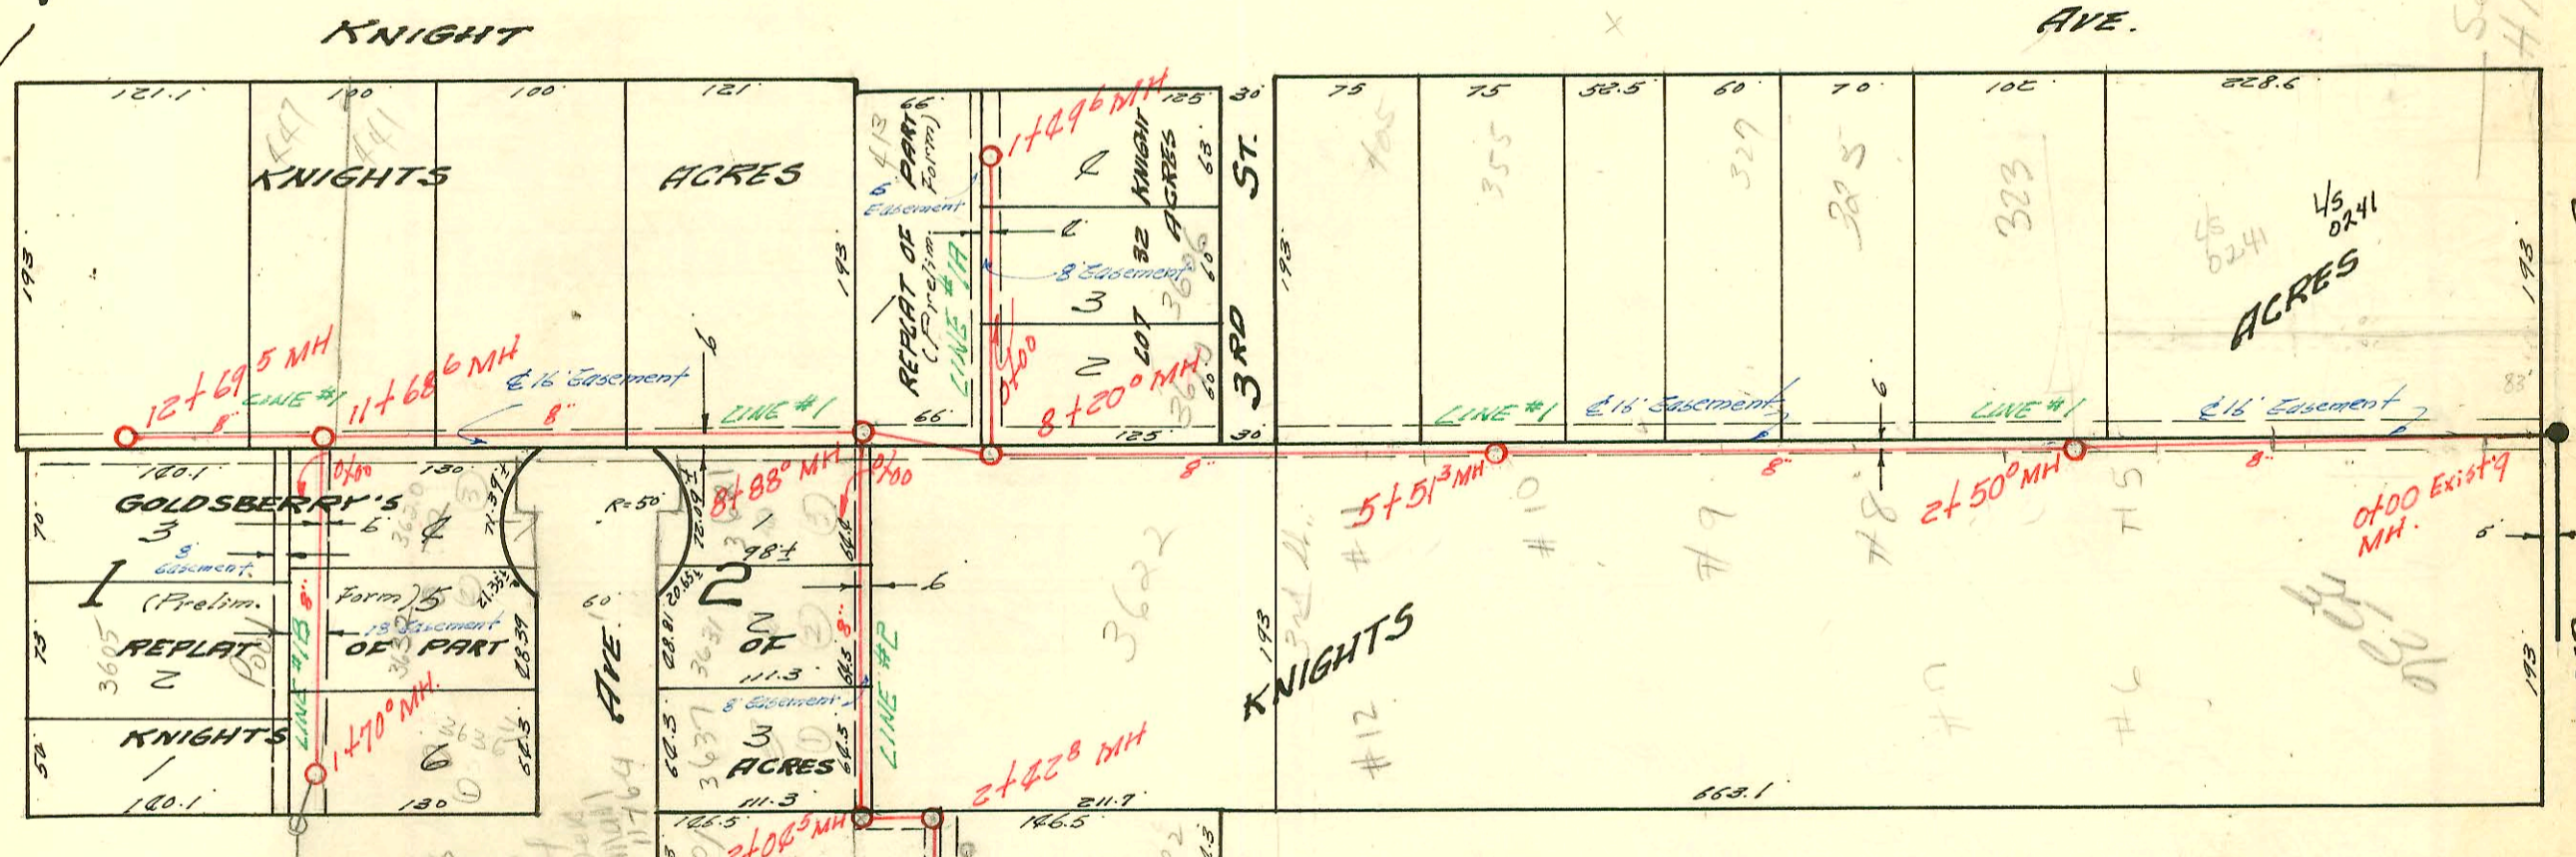

LAT. 5 SUB. 7. S.S. 22
 UTILITY CONTRACTORS INC. MAY 2 1957
 BK. NO. K-38 PROJ. NO. C25-84
 FILE 6-1-2-5

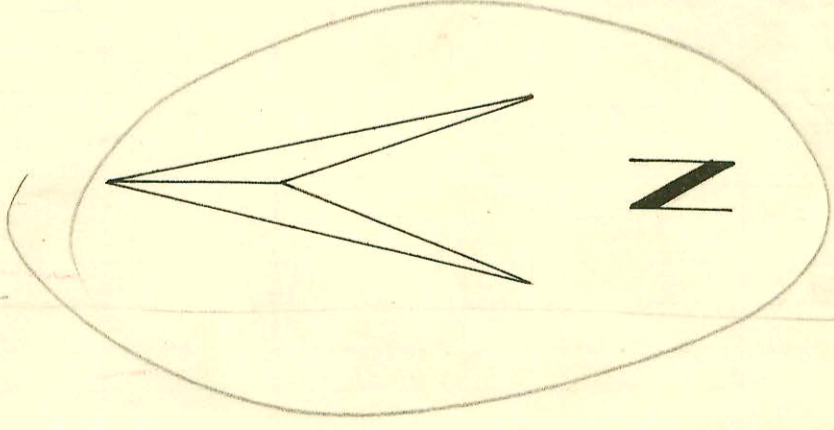

PRIVATE CONTRACT S. S.
 MID-STATES CONST. CO.
 1-5-66 Bk NO. K-84
 Booked on page 84.
 For 3 1/2 lot 36 Knight Acres.

11+97.5 MH.
 4" stub w.
 113.69 FIB
 6.3 deep
 439' 5.3' deep
 442 N
 (on septic)
 see a H
 15' mails
 812309

