

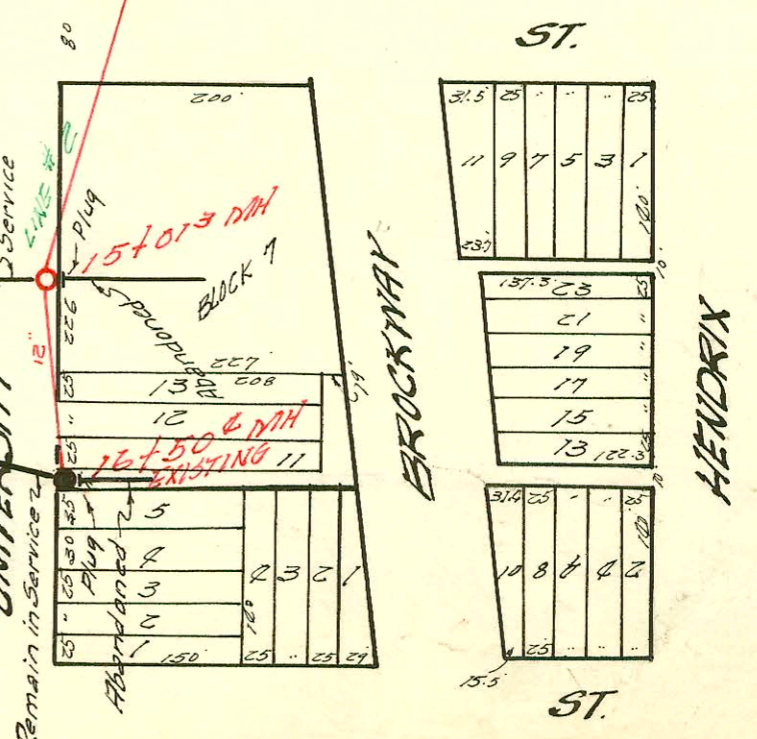
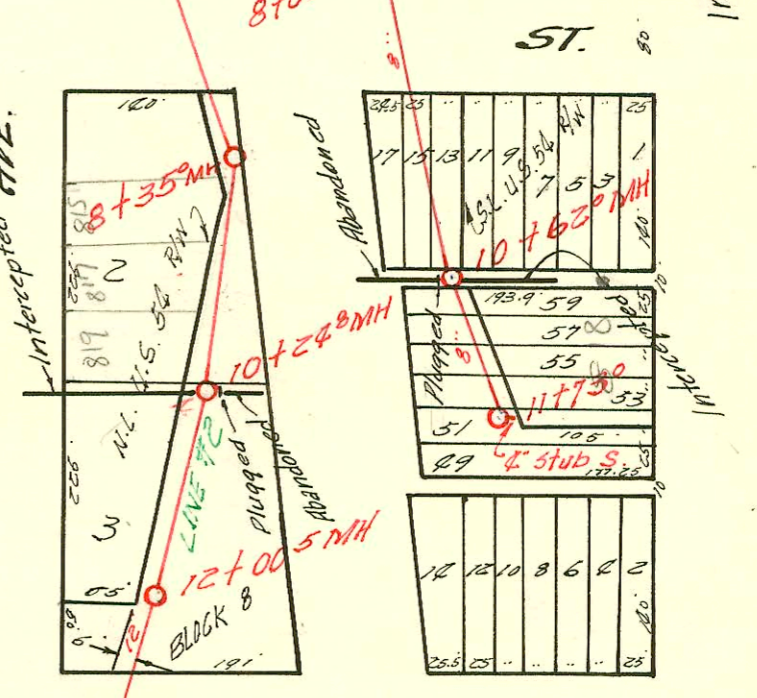
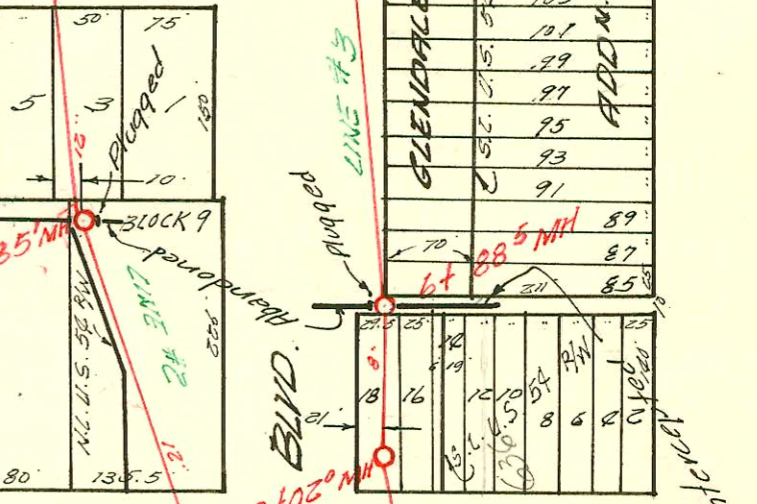
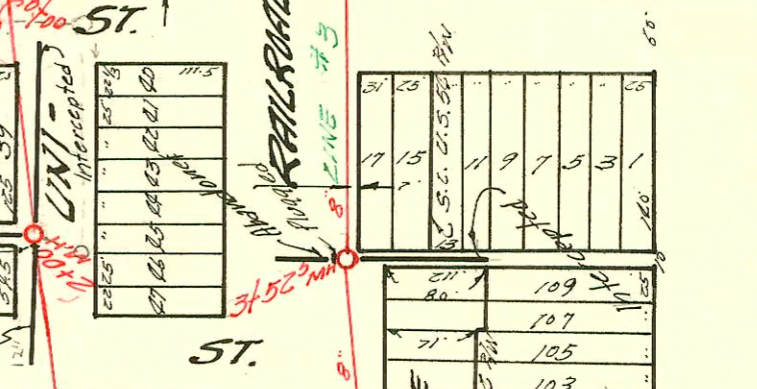
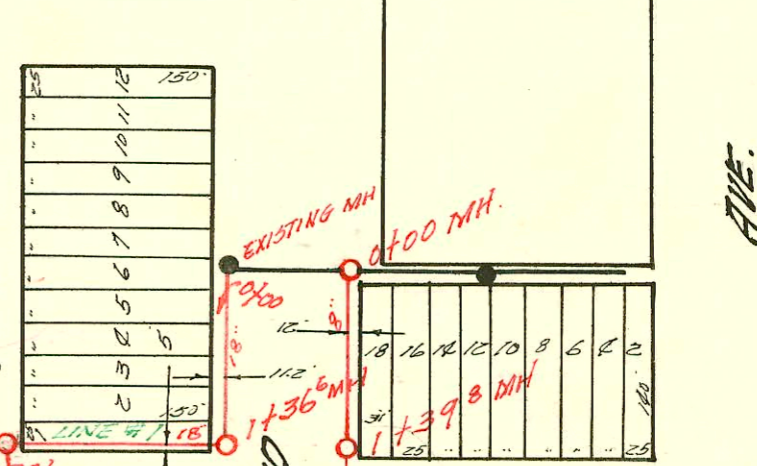
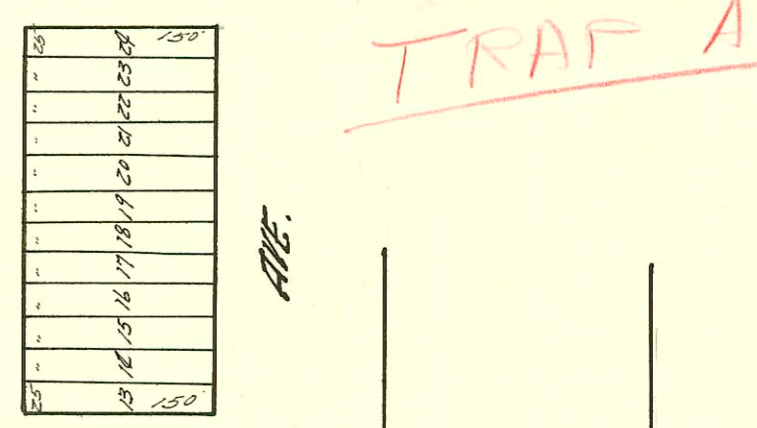
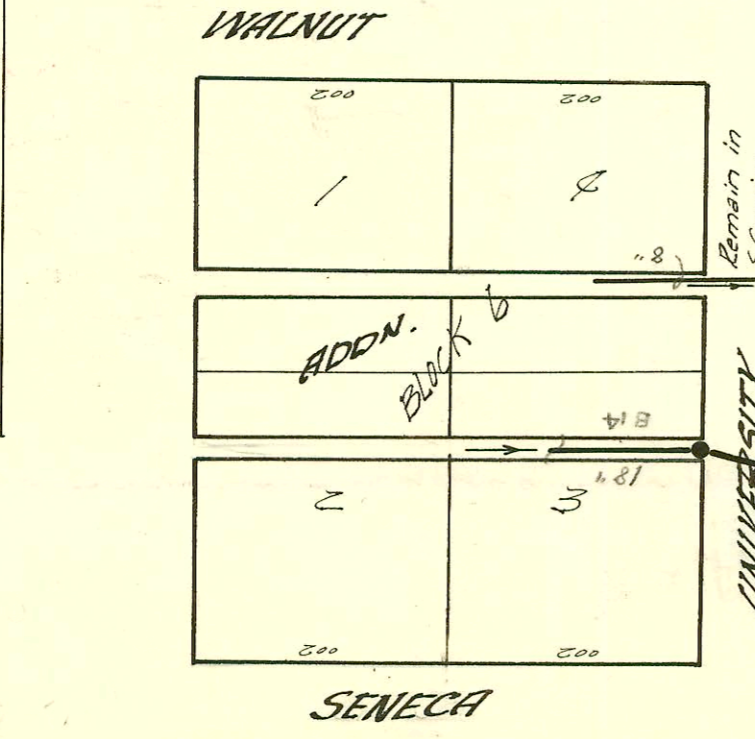
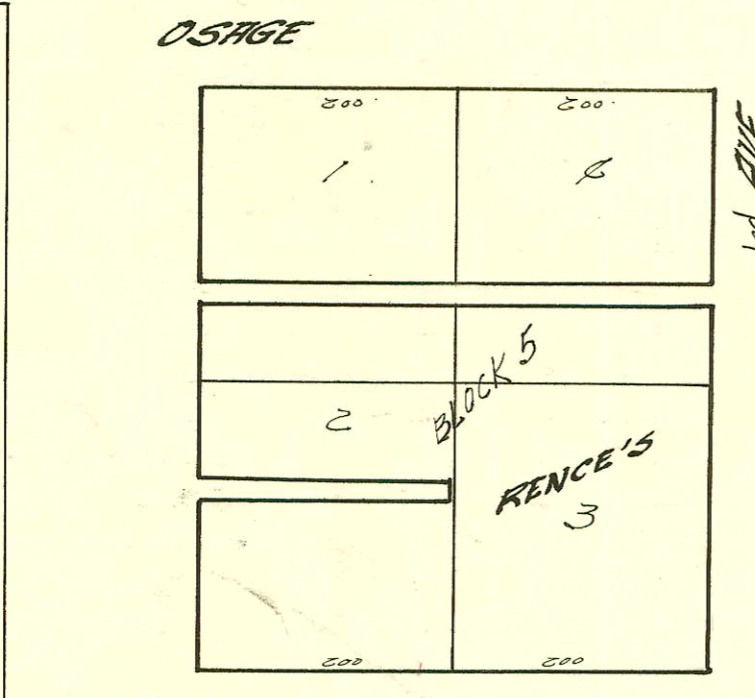
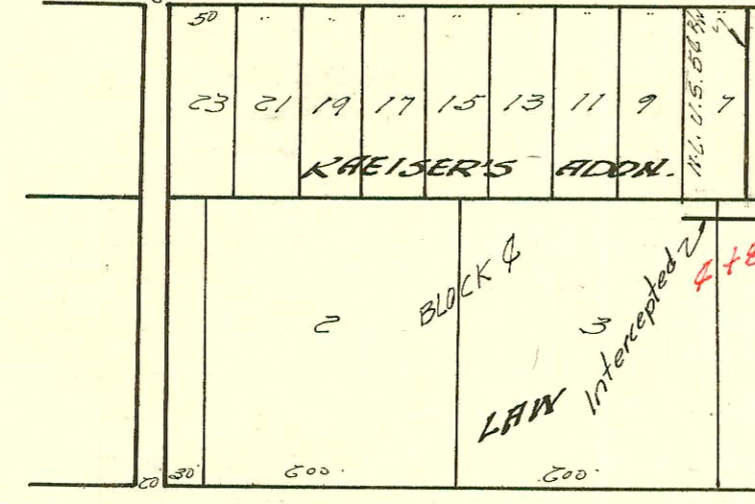
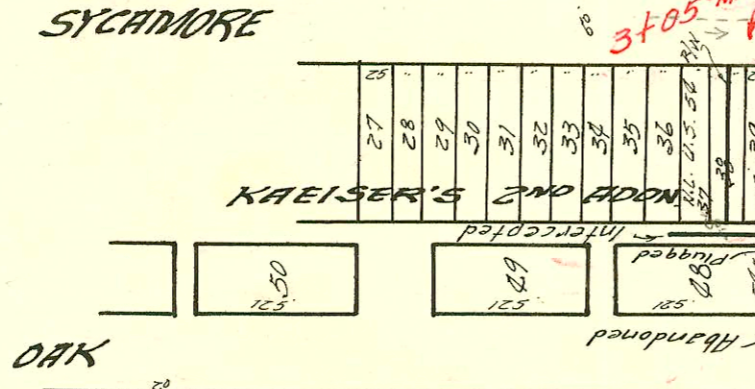
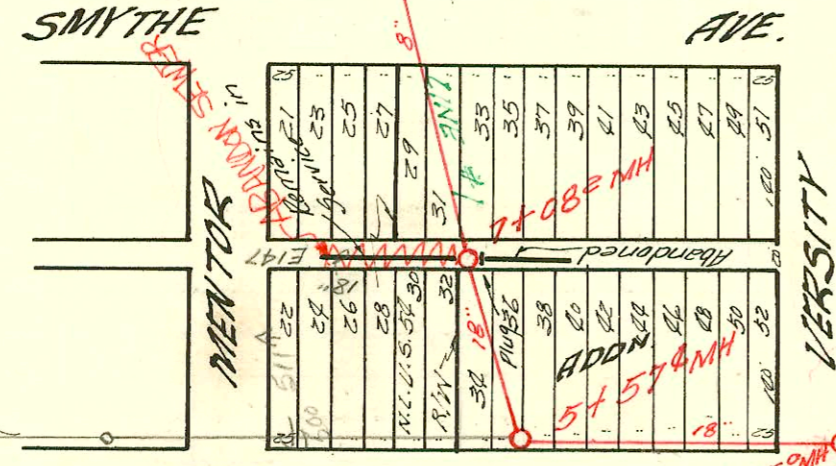
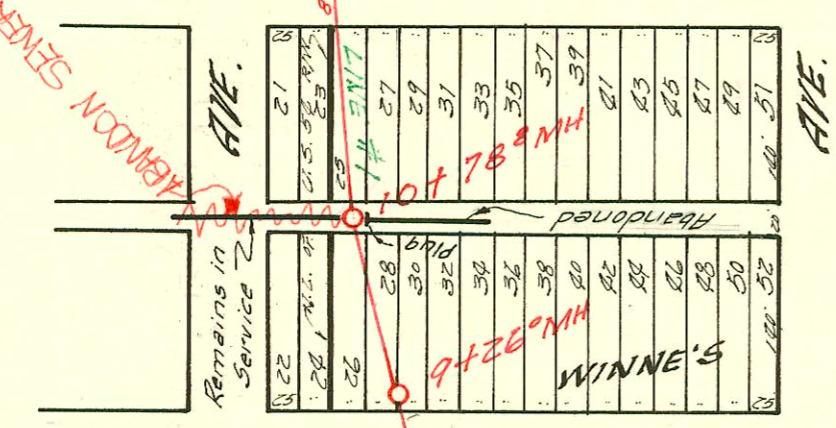


See N-168
Relocation of Sump #2
Sewer District #2

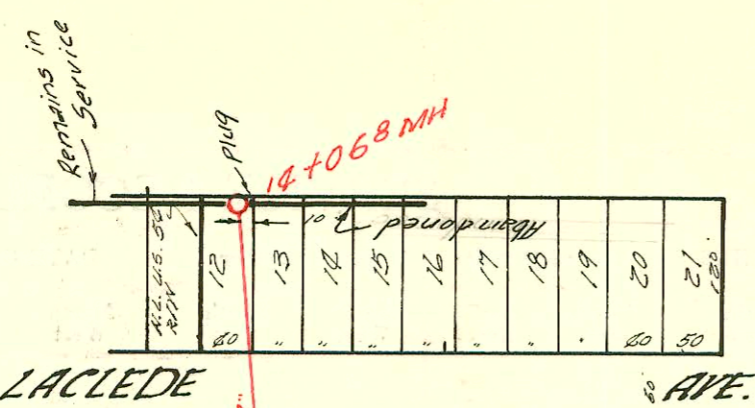

TRAP AREA

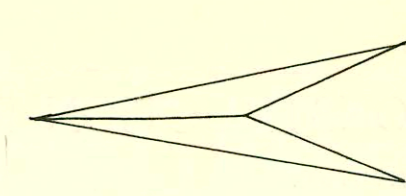

RELOCATION OF PART OF S.S. IN DIST. 8421
 W.B. CARTER CONSTRUCTION CO. MAY 21 57
 BK. NO. 12-36 (PROV. NO. C7)
 FILE NO. 6-1-26

AVE.

ST.

ST.

ST.

ST.

UNIVERSITY

BROCKWAY

HENDRIX

SENECA

WALNUT

OSAGE

OAK

KAEISER'S 2ND ADDN.

KAEISER'S ADDN.

BLOCK 5
RENCE'S

ADDN. BLOCK 6

BLOCK 7

SMYTHE

SYCAMORE

OAK

OSAGE

WALNUT

SENECA

LACLEDE































