



Plat Book 9
page 69

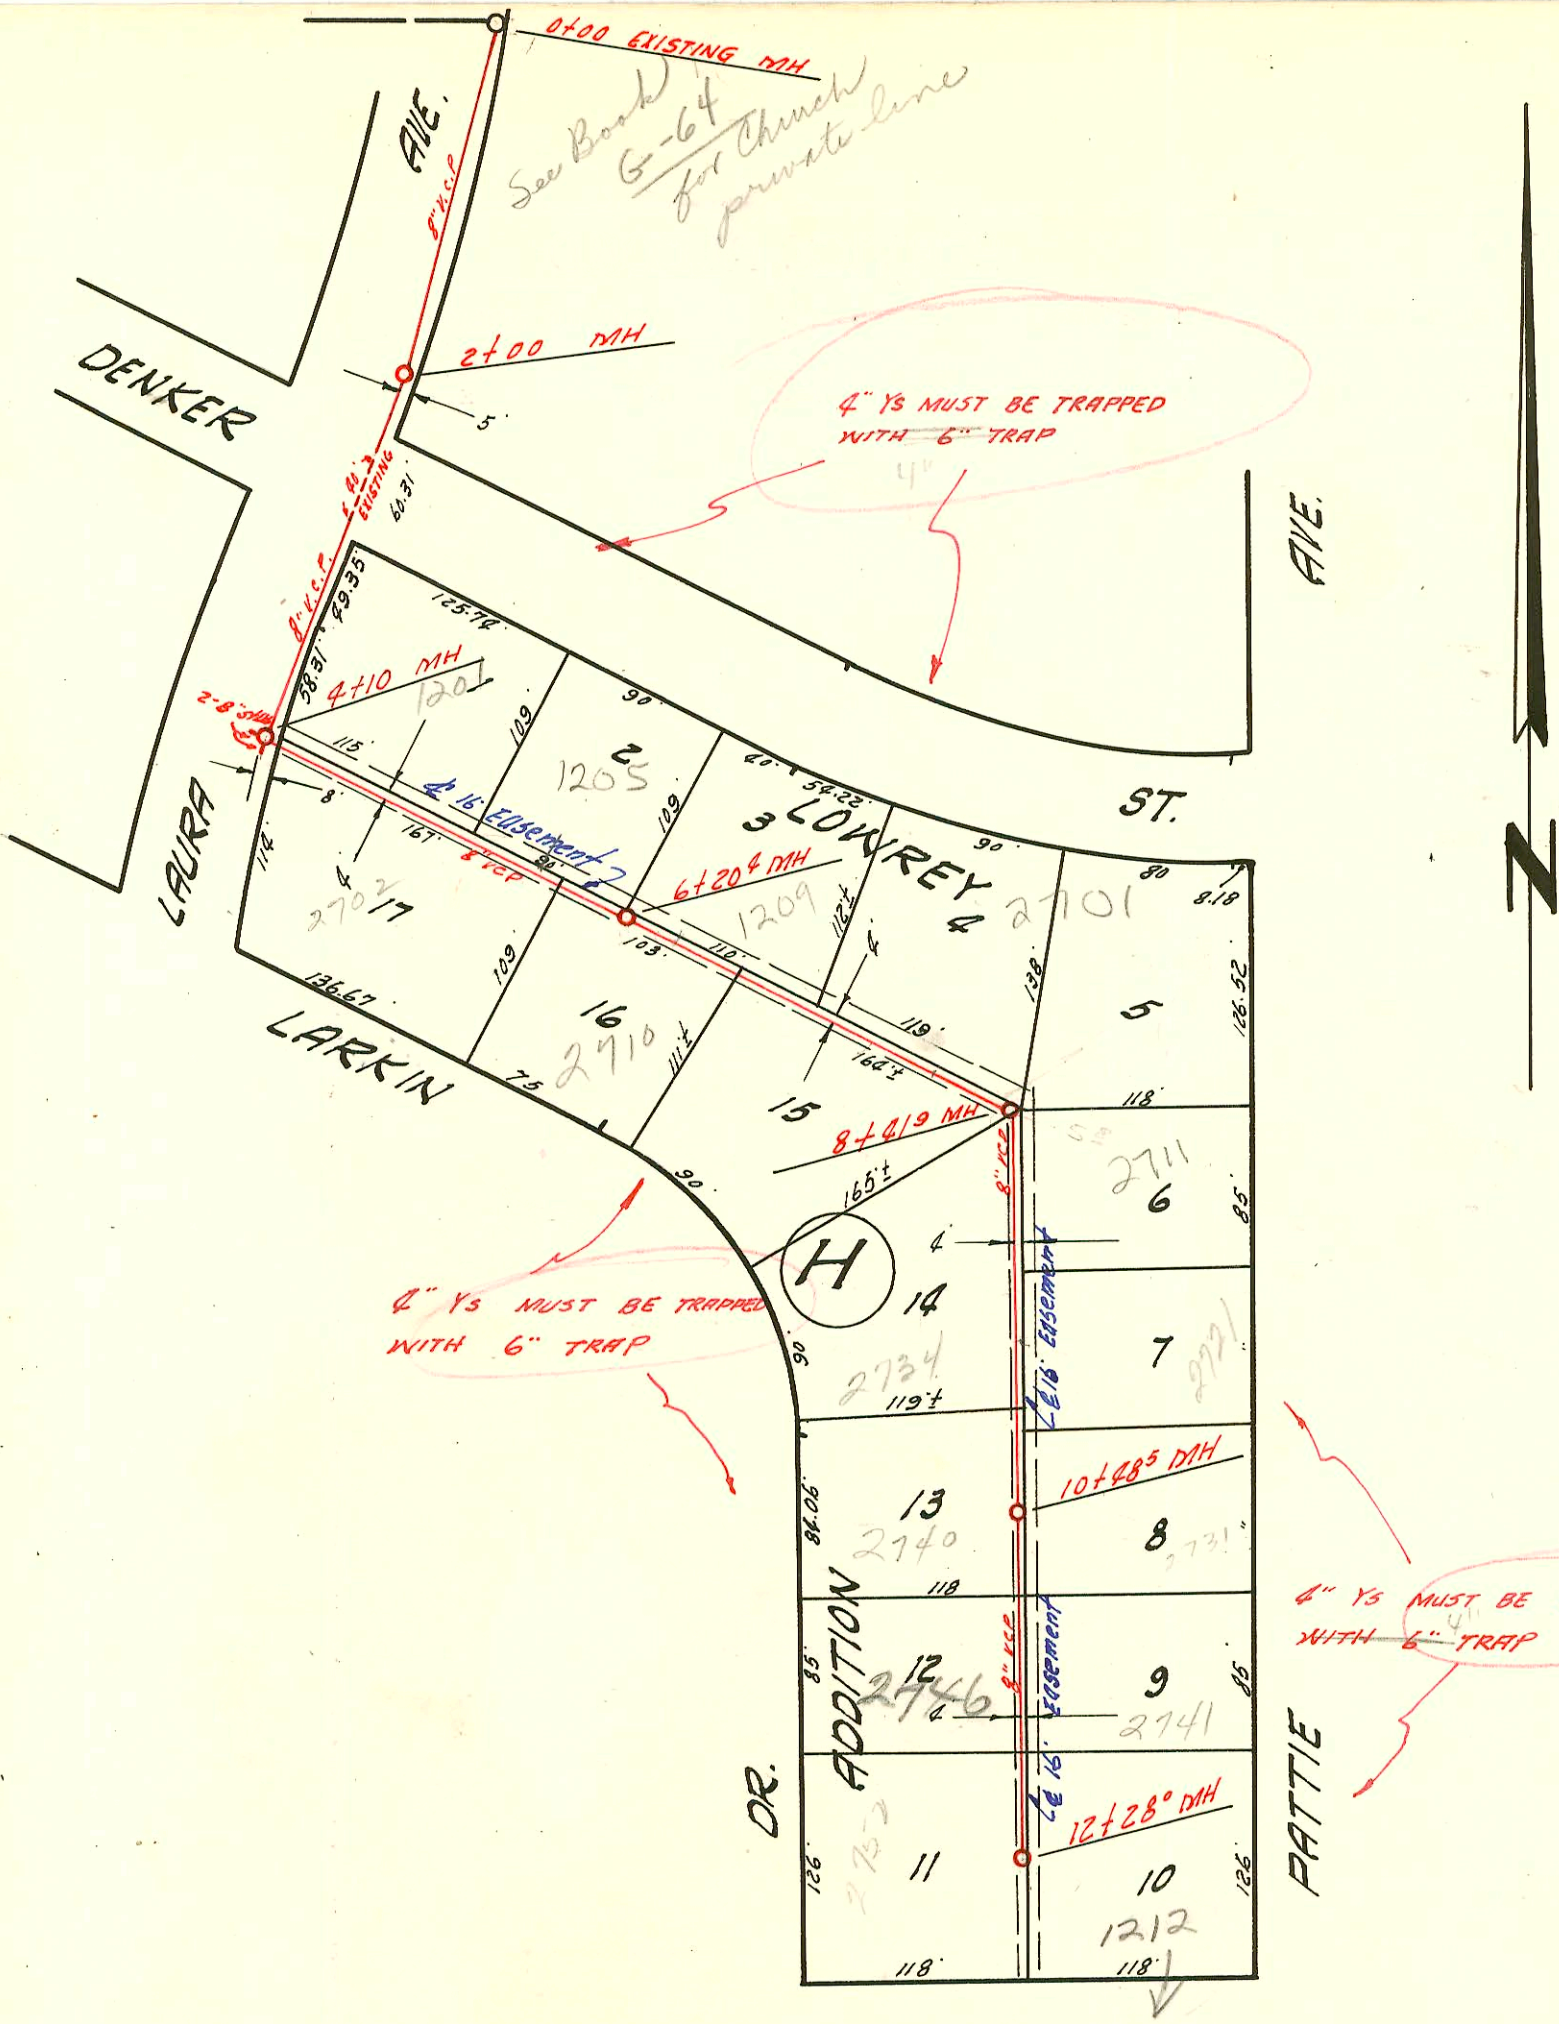

TRAP AREA

LATERAL 22 DIST. A S.S. 20
UTILITY CONTRACTORS INC., JAN 2 '58
BK. NO. K-22 PROJ. NO. C26-35

See page 114
(int 26)

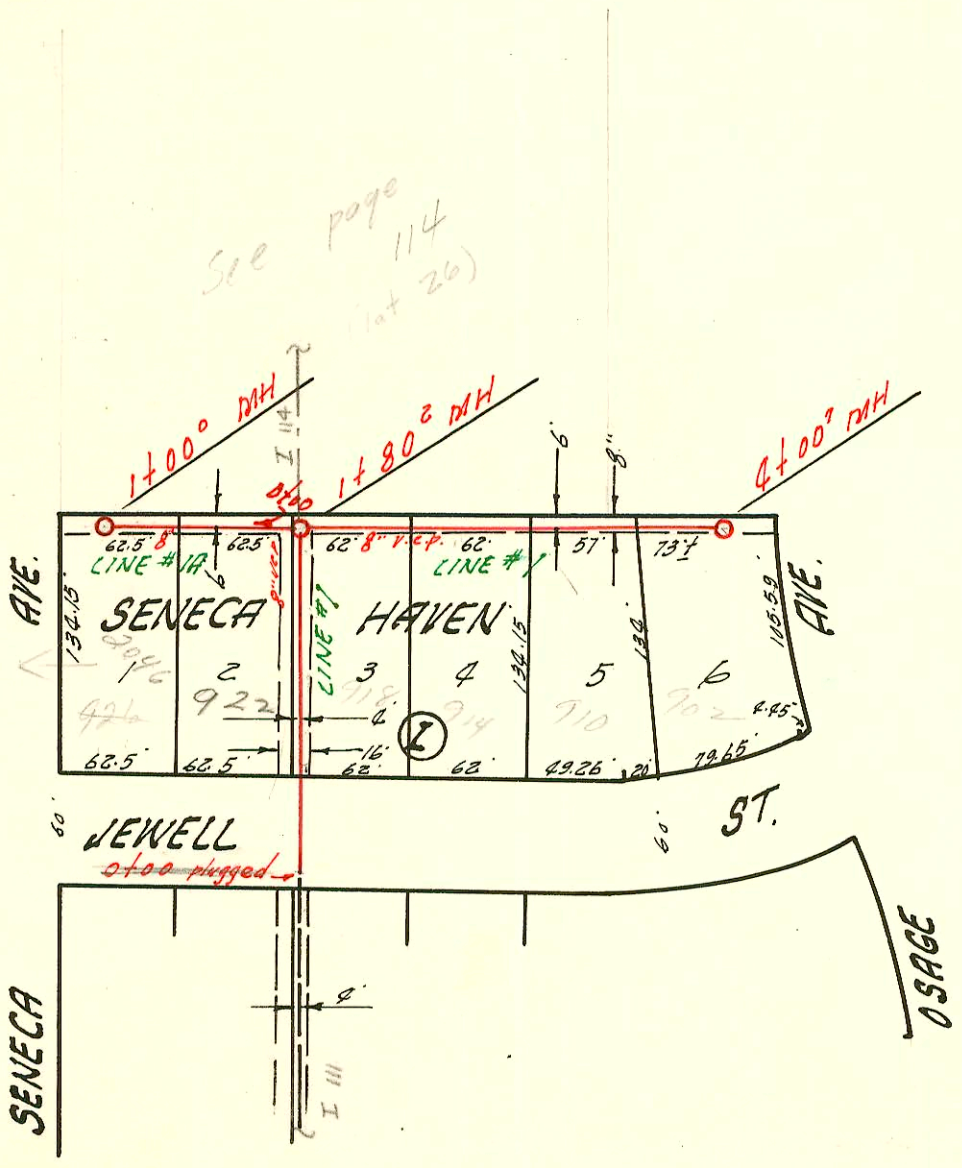

LATERAL 35 SUB. 2 S.S. 22
L. C. PEDDICORD CONTR. JAN. 2 '58
BK. NO. K-39 PROJ. NO. C27-18

