

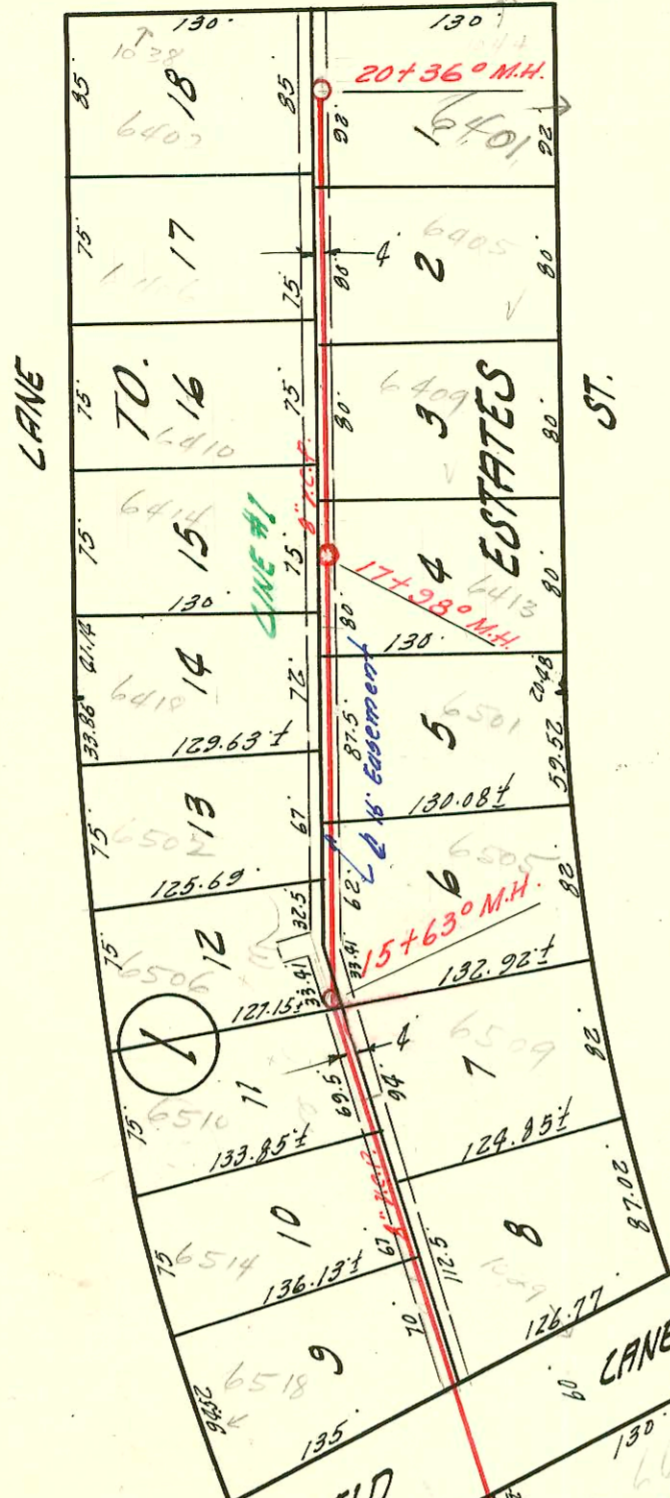


WOODLAWN BLVD.

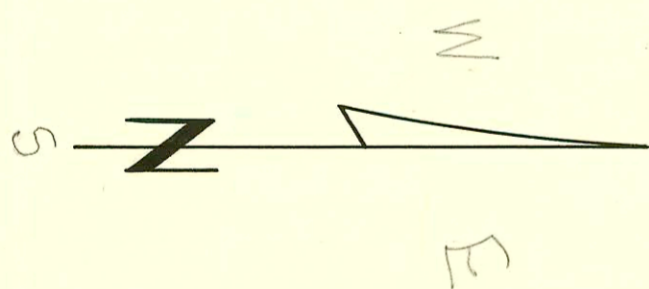


LATERAL 51 D.C.S. #2 S.S. NO. 12  
 W.B. CARTER CONSTR. CO. 4-9-58  
 BK. NO. K-44 PROJ. NO. 027-53


SCALE 1" = 100'

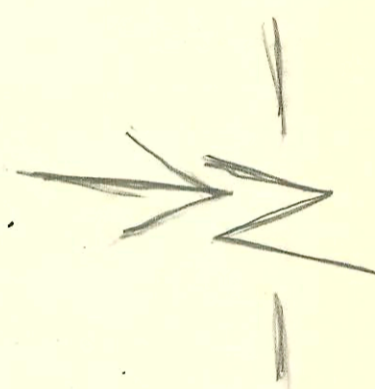

WHITFIELD

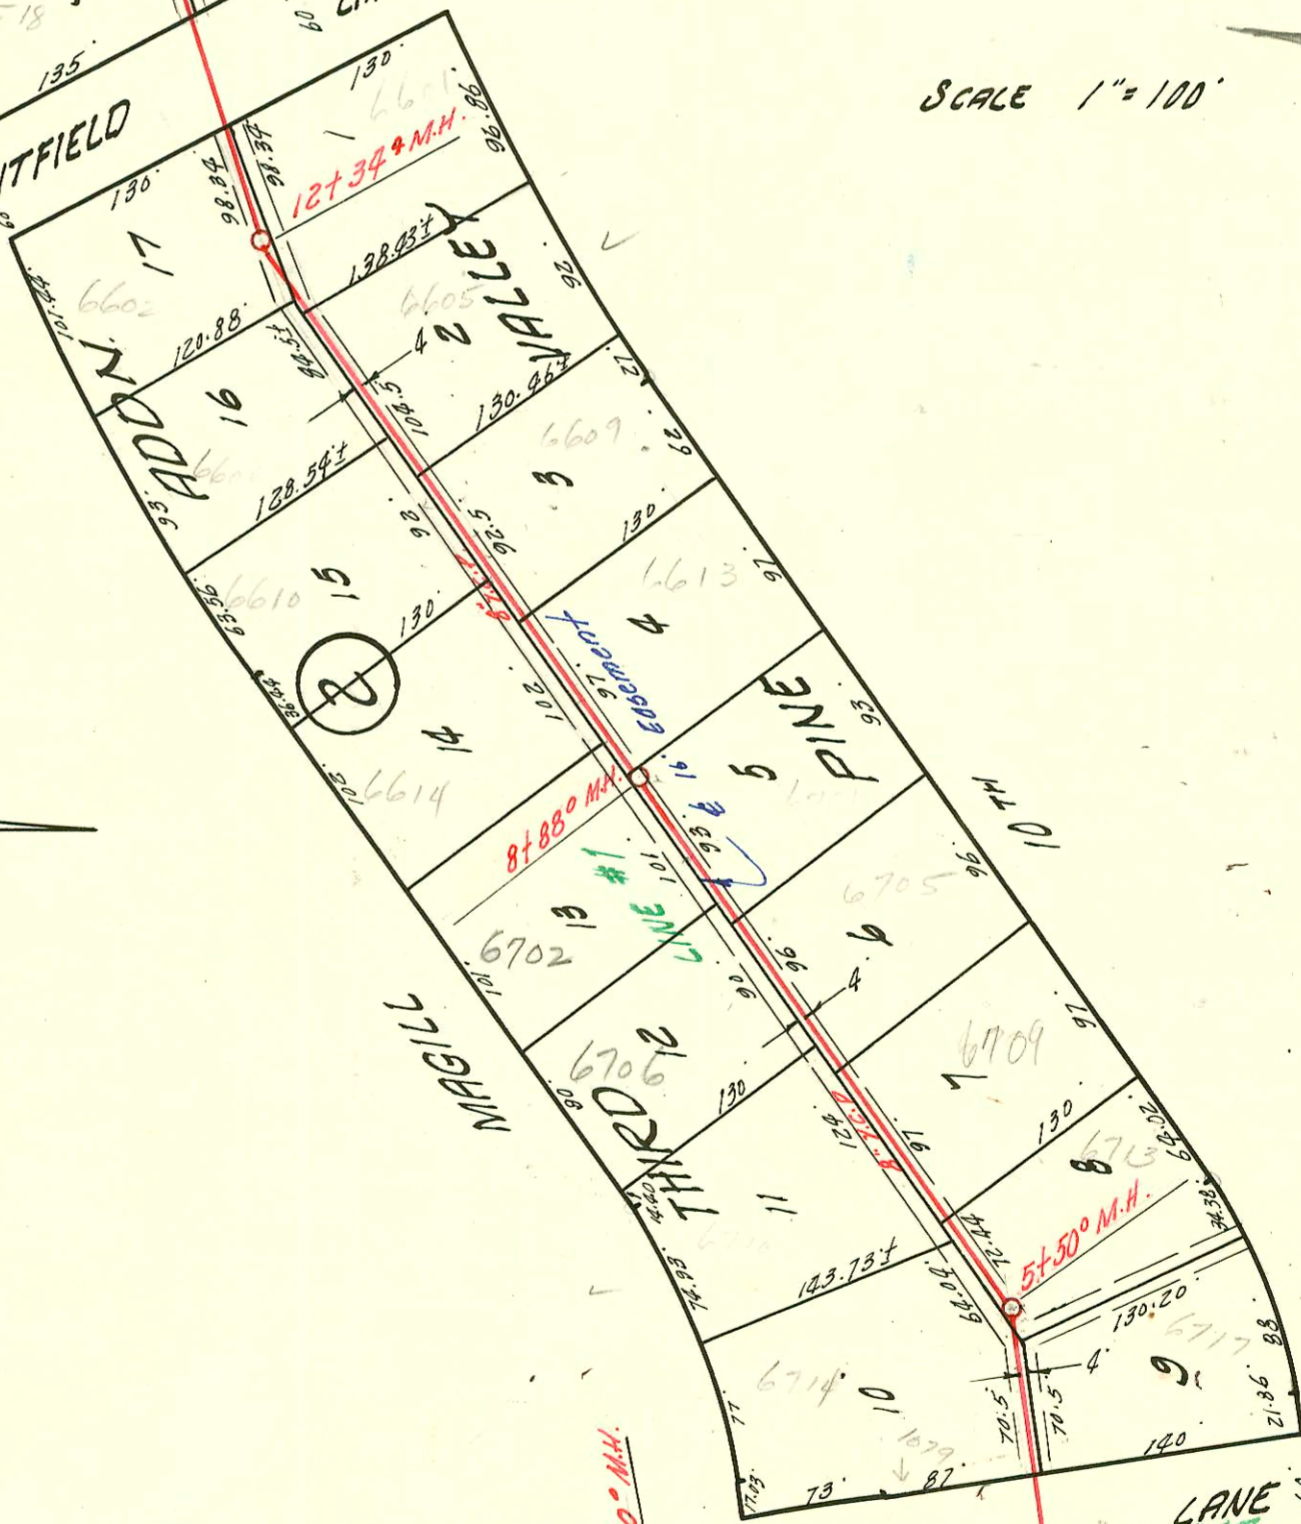

ARMOUR LINE #1

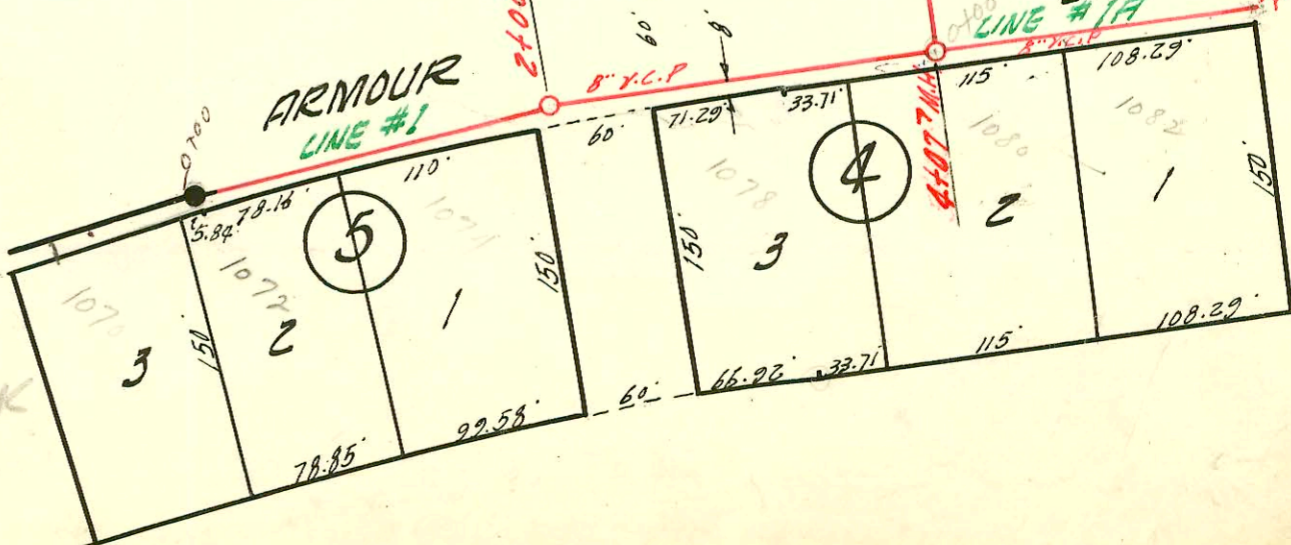

93-43604-7 12 292 1070 W. Armour-  
 Rep 'S' at edge of sidewalk

