



LATERAL 39 SAN. SEWER 22
 PETER KIEWIT SONS' CO. 4-25-58
 BK. NO. K-53 PROJ. NO. C26-78

LATERAL 18 SUB. 9 S.S. 22
 PETER KIEWIT SONS, CO. 5-5-58
 BK. NO. K-53 PROJ. NO. C27-42

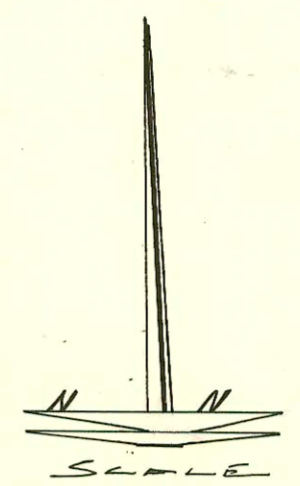

Ext. To Lot 18, Sub 9, S.S. 22
 W. B. Carter Const. Co. Inc. Booked 2-26-69
 Book J.K. 7 Private Project

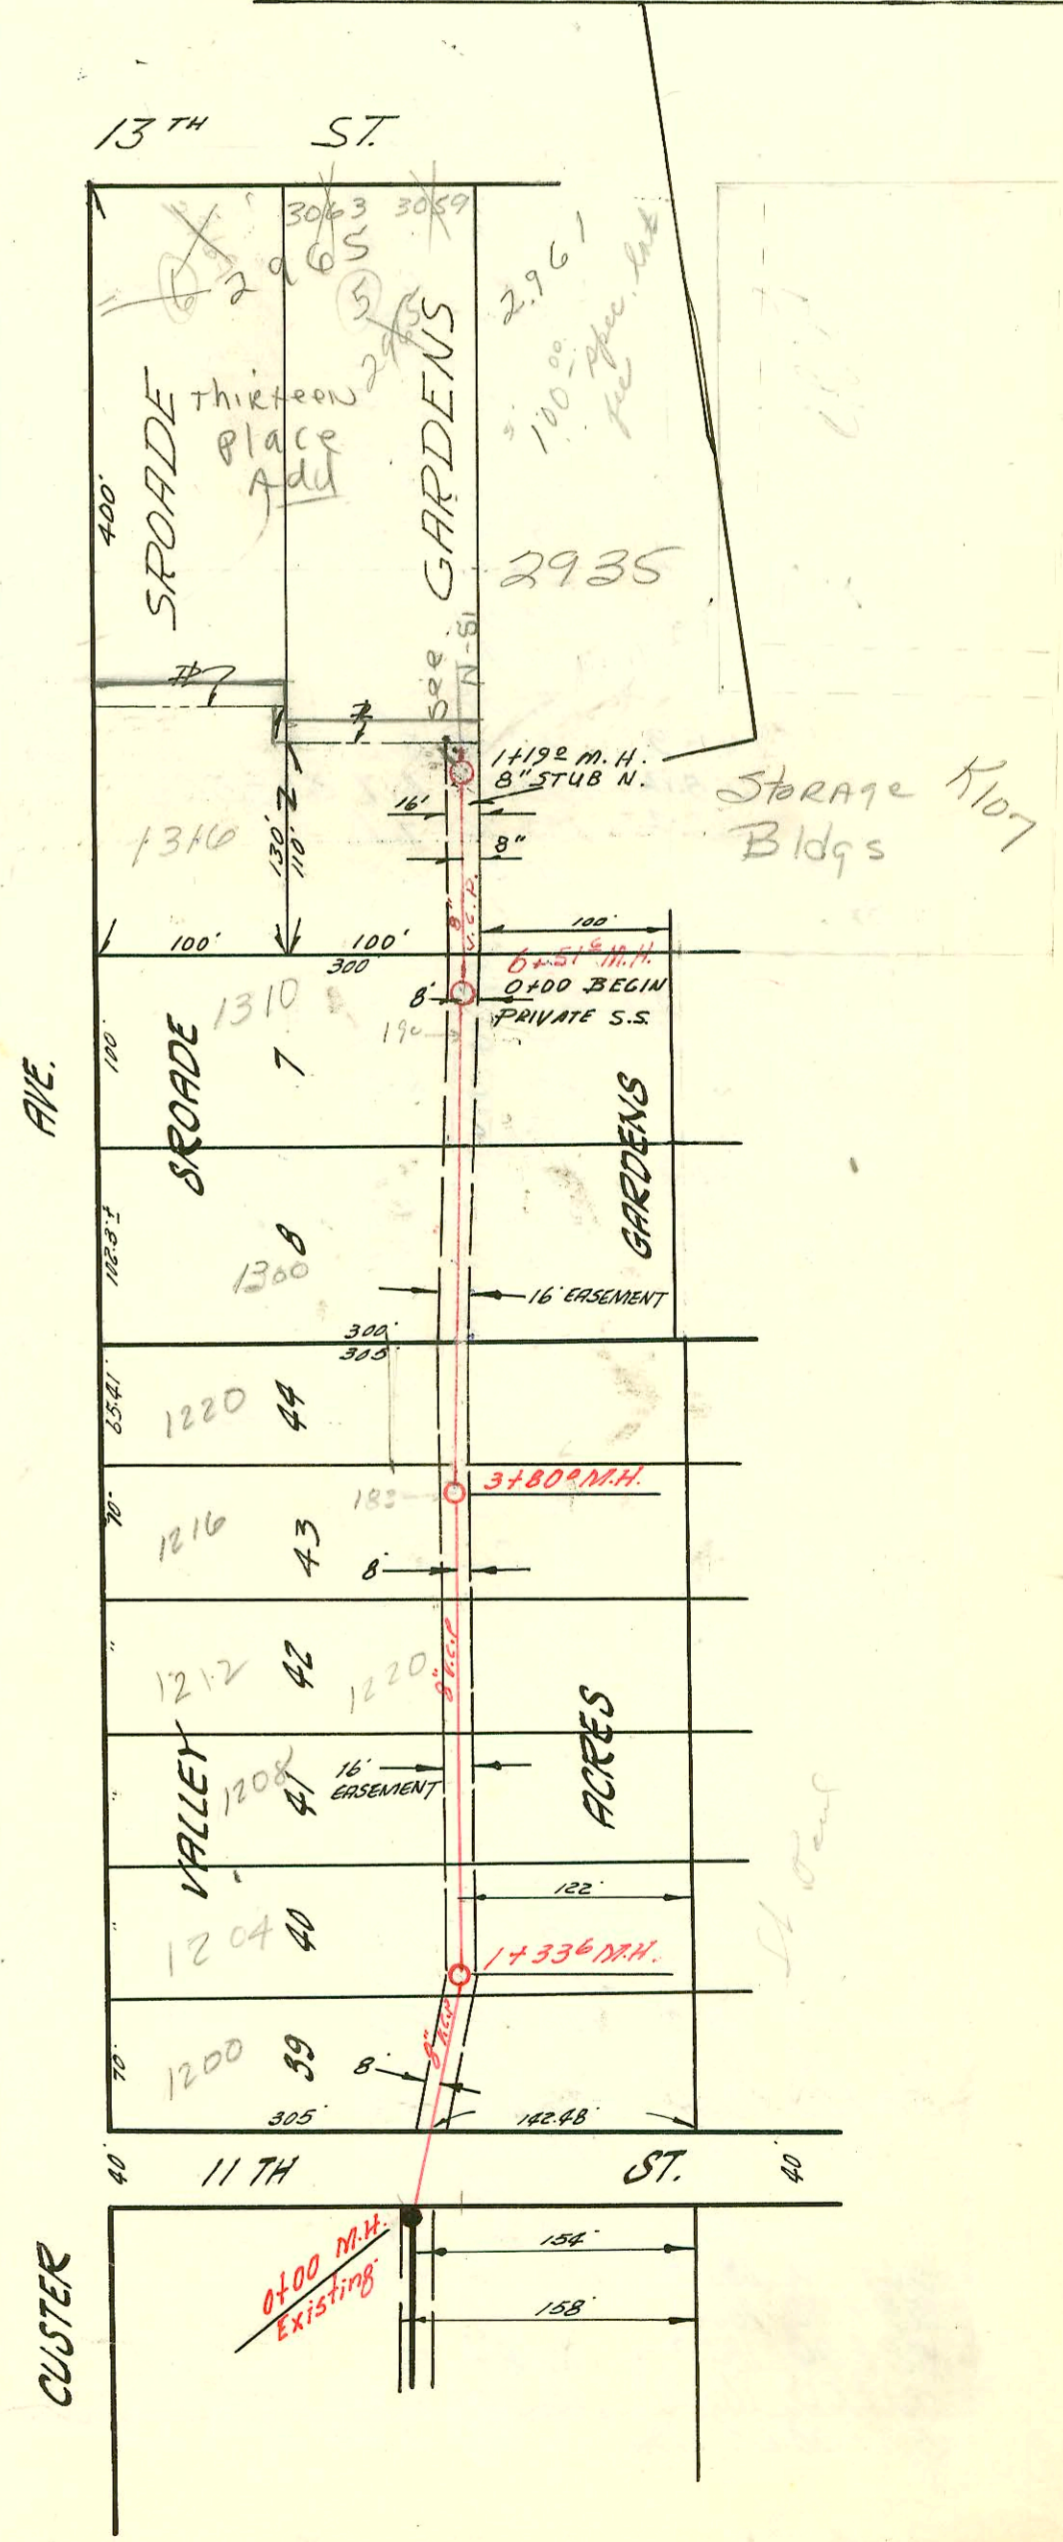

CUSTER

CONSTRUCTION RECORD

SERVICE RECORD

STATION	ELEVATION		Depth	MANHOLE	4-INCH "Y" BRANCHES		No. of Permit		House Number		DATE OF PERMITS	
	Ground	Grade			North West	South East	North West	South East	North West	South East	North West	South East
0+00	120.0	110.77	9.2	EXISTING M.H.								
1+00	121.8	111.17	10.6		+65°							
2+00	123.2	111.56 OUT 111.64 IN	11.6	1+974	+04°							
3+00	122.7	112.07	10.6		2+56° (W) 2+66° (S.E.)							
	122.7	112.28 OUT 112.41 IN	10.3	3+535	4" 5/16 SW.							
4+00	122.3	112.57	9.7		2+57°							
5+00	121.41	112.97	8.4		4+74°							
6+00	120.8	113.37	7.4		4+88°							
7+00	120.8	113.77	7.0		5+03°							
8+00	121.4	114.17	7.2		+75°							
9+00	120.7	114.57	6.1		+17°							
	120.6	114.85	5.7	9+687	4" stub N.W.							
LAT. 18 SUB. 9 S.S. 22												
0+00	122.9	115.52	7.4	Existing M.H.								
1+00	124.0	115.72	8.3		+65°	+63°						
2+00	125.4	115.92	9.6	1+336								
3+00	124.2	116.12	8.1		+12°	+10°						
4+00	123.3	116.32	7.0	3+80°	+77°	+75°						
5+00	124.1	116.52	7.6		+23°							
6+00	125.0	116.72	8.3	6+516	+577	+88°						
	124.8	116.82	8.0		+30°							
Ext. to Lat. 18, Sub. 9 S.S. 22												
0+00	114.9	125.06	10.1	EXIST. M.H. 0+00								
1+00	116.1	126.08	10.0		0+65°	0+94.4°						
	116.3	126.26	10.3	1+192	8" STUB N.							

N/C 2002-00667 9/2/02 726 N Joann

97-86547 5-30-97 1730 N Joann

2466
 59624 (7357) Day Colman - 1-26-77 (2770.4) (Spotted at stage at Property Line)
 59577-7357 Joann - Don Colman - 1-24-77 (Refracted at metal NK permit Referto #C59624)
 7061 Top 746 N Joann 10/28/83
 7187 Top 1318 N Joann 10/28/83

92-8243 6-16-92 (2965 w/13th - Hennings (on septic))
 94 111367 10-18-94 1747 N Joann (Clay runs under addition - permit to clay at house)