157A

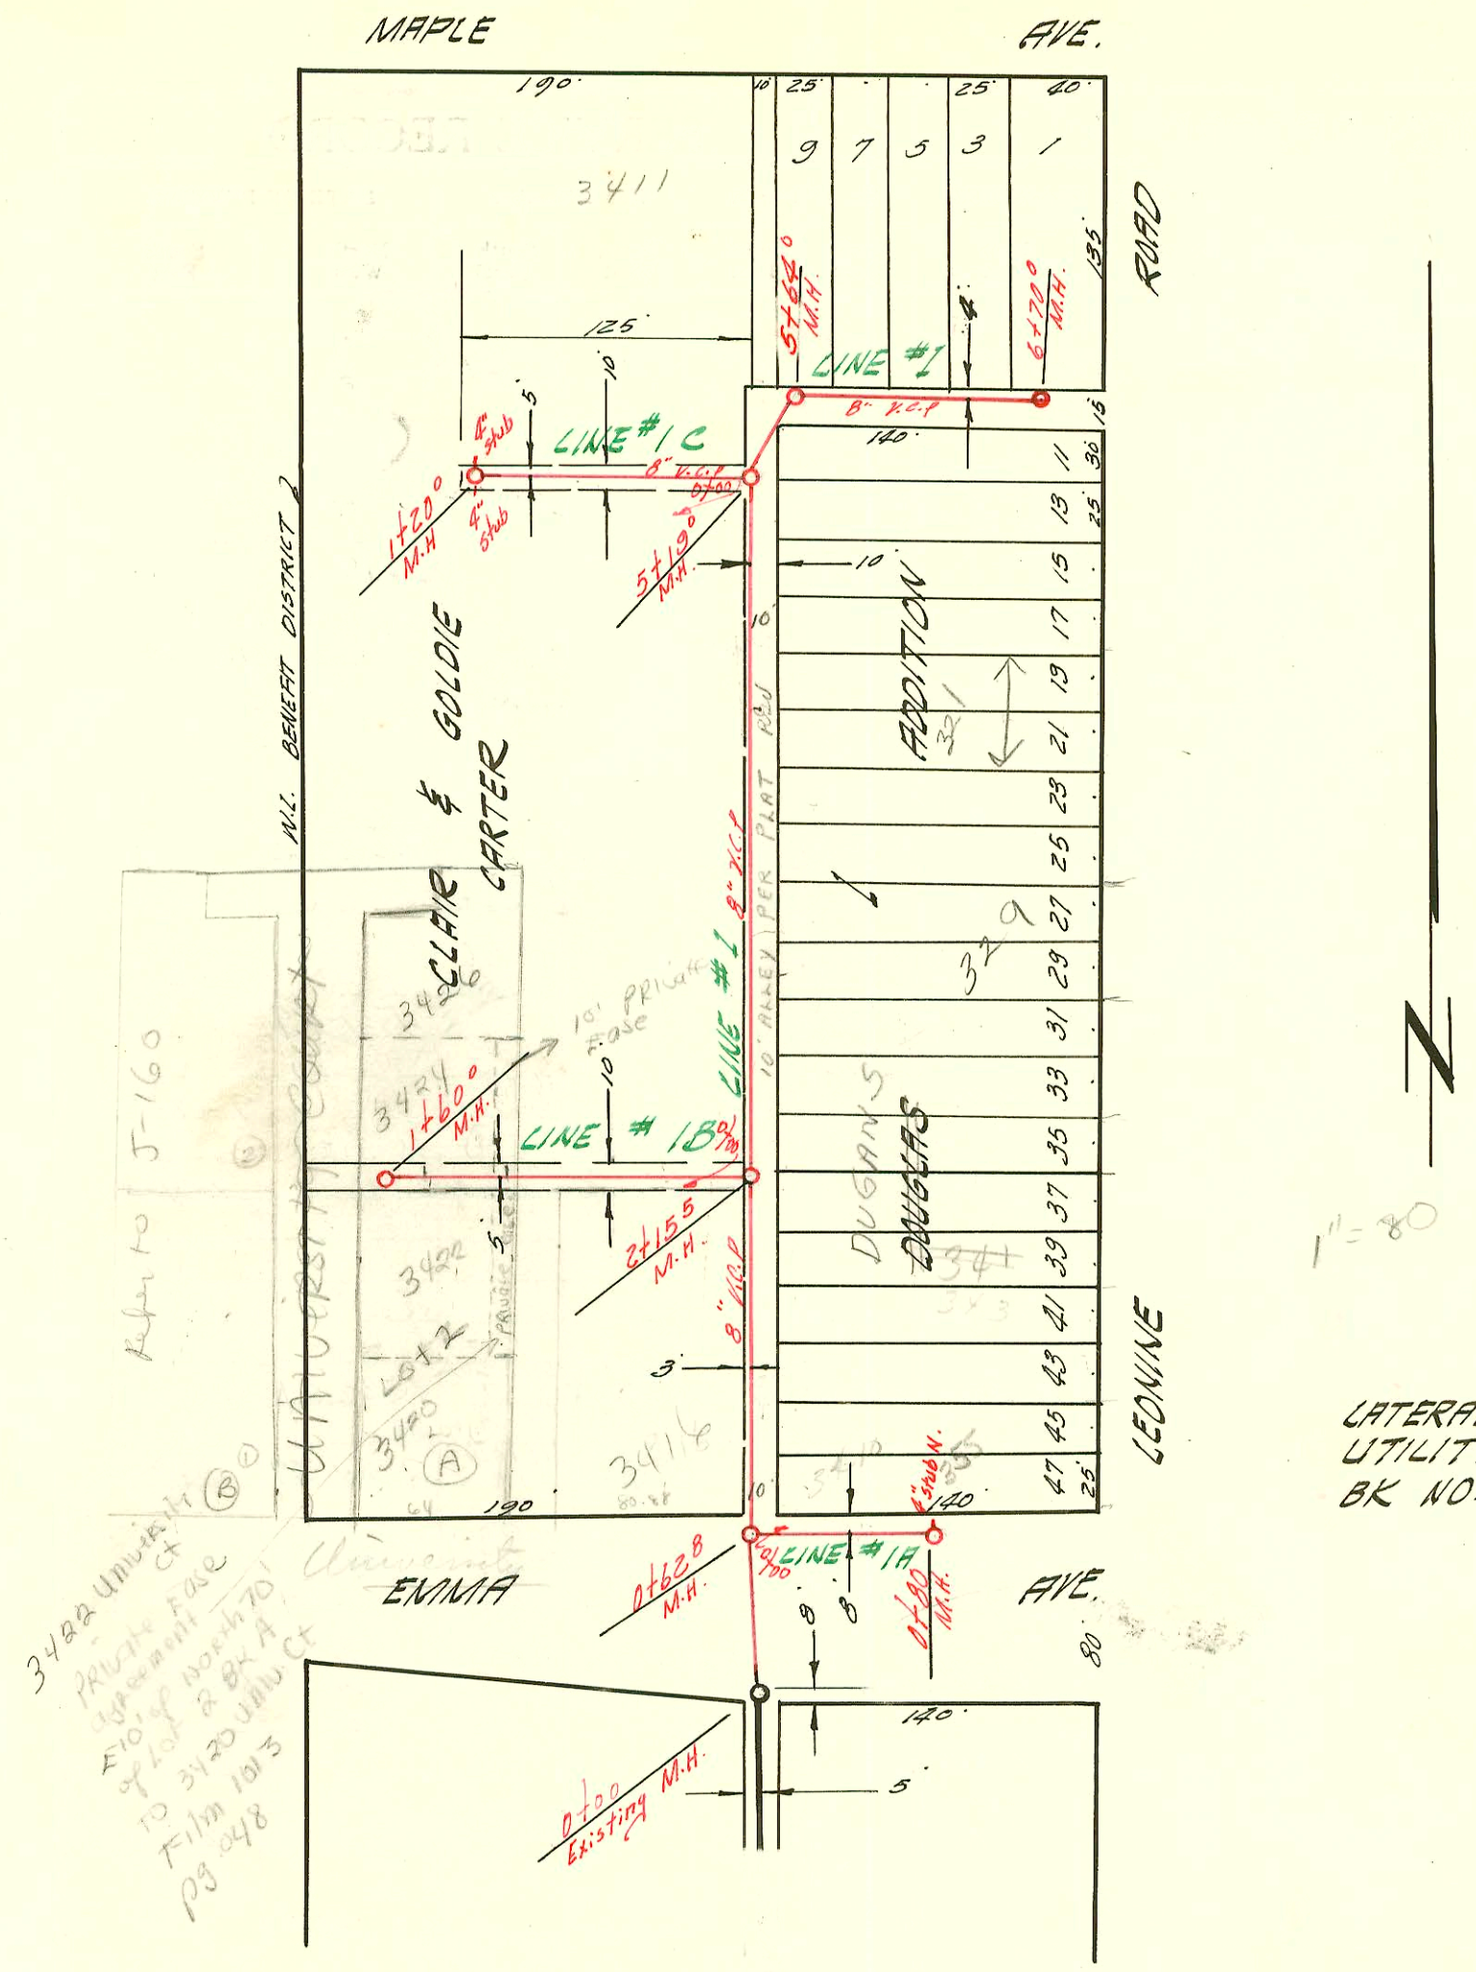

LATERAL 48 SUB. 5 S.S. 22
UTILITY CONTRACTORS INC. 8-5-58
BK NO. K-50 PROJ. NO. C28-39

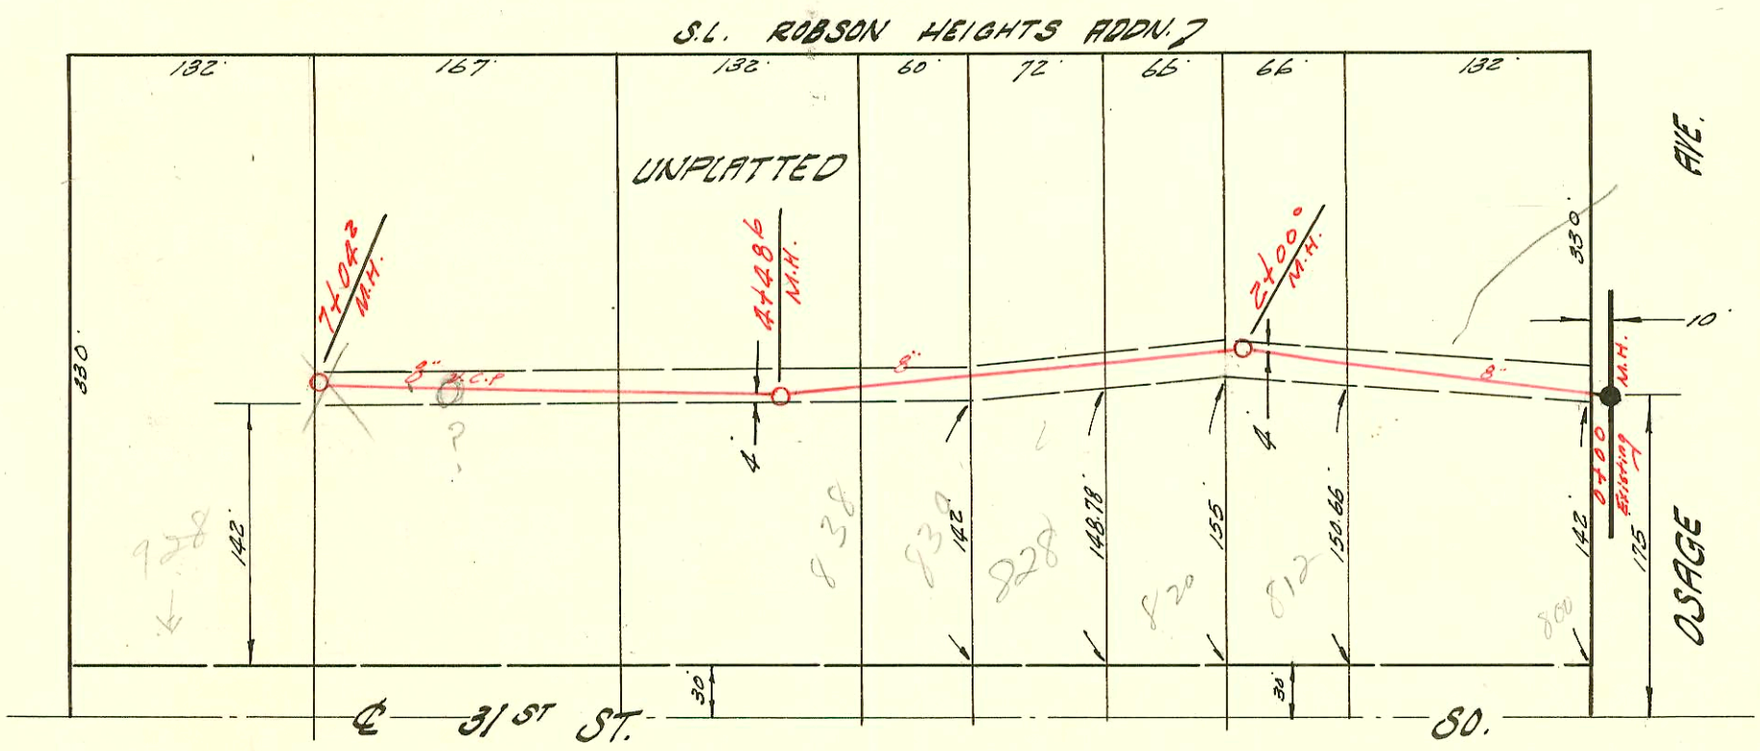

LAT. 9 SUB. 4 S.S. 22
UTILITY CONTRACTORS INC. 8-6-58
BK NO K-49 PROJ. NO. C 26-23

157

Form 41-(54) 6-57

CONSTRUCTION RECORD							SERVICE RECORD					
STATION	ELEVATION		Depth	MANHOLE	4-INCH "Y" BRANCHES		No. of Permit		House Number		DATE OF PERMITS	
	Ground	Grade			~~North~~ West	~~South~~ East	North West	South East	North West	South East	North West	South East
LINE #1												
0+00	114.7	108.45	6.2	Existing M.H.								
	115.1	108.57	6.5	0+62.8								
1+00	115.2	108.65	6.5									
						+79.2		C47833 8538	Cut off 341 So. Leonine		12-18-74 10-31-58	
2+00	115.6	108.85	6.7					C57298	343 S. Leonine		8-20-76	
	115.7	108.88	6.8	2+15.5								
						+63.3		8212	337 Leonine		10-2-58	
					+97.6							
3+00	116.9	109.05	7.8									
						3+23.0		2000 01034 7968	329 S.D. Leonine		4-27-00 8-28-58	
					+49.4							
						+83.4		9589	327 Leonine		3-11-59	
4+00	116.0	109.25	6.7									
					4+01.0							
						4+20.7		C38723 14746	321 So. Leonine		5-2-73 7-25-61	
					4+58.0							
5+00	115.4	109.45	5.9									
	115.6	109.49	6.1	5+19								
	114.9	109.58 OUT	5.3	5+64								
		109.68 IN	5.2									
					+87.0 (N)	+89.0 (S)						
6+00	114.3	109.75	4.5		+49.0 (N)	+51.0 (S)						
	113.8	109.89	3.9	6+70								
LINE #1A												
0+00	114.8	108.68	6.1	Existing M.H.								
					North. +43		8730		3410 Emma		11-20-58	
	114.0	108.83	5.2	0+80	4" stub N.		14255		355 S. Leonine		6-5-61	
LINE #1B												
0+00	115.6	108.99	6.6	Existing M.H.								
					0+30.0	+28.0		16041		3416 University		8-17-62
					0+79.0							
						+81.0						
1+00	117.2	109.18	8.0		1+07.0 TAP	1+06.0 TAP	23235	20256	3426 UNIVERSITY	3420 UNIVERSITY	5/25/89	8-10-68
					1+39.0	1+48.0 TAP 1+41.0	931726-7	20257	3424 UNIV CT.	3422 UNIVERSITY	1-27-93	8-10-68
	118.8	109.30	9.5	1+60								
LINE #1C												
0+00	115.8	109.60	6.2	Existing M.H.								
					+27.0							
					+65.0		# 7628		3411 W. Maple		8-5-58	
					+94.0		# 7500		3411 W. Maple		8-5-58	
1+00	117.4	109.79	7.6						S.D.			
	117.6	109.83	7.8	1+20.0	4" stubs N. & S.		962524 10899		3415 W. Maple		8-11-77 7-23-59	
0+00	95.3	88.16	7.1	Existing M.H.								
					+27.0	+25.0		11597		800 W 31st St.		10-6-59
						+90.0						
1+00	95.3	88.36	6.9									
						+52.5		7988		812 W 31st St.		9-3-58
2+00	95.6	88.56	7.0	2+00.0								
						+27.6		15295		820 W. 31st St.		3-14-62
3+00	95.6	88.76	6.8									
						+05.0		6-14-973 11800		828 W 31st St.		7-16-69 11-16-59
						+61.5		7688		830 W 31st St.		8-14-58
4+00	95.5	88.96	6.5									
					+13.0			2007 00101			-S10	3-5-07
						+32.0		7687		838 W 31st St.		8-14-58
	95.4	89.06	6.3	4+48.6								
5+00	95.4	89.16	6.2									
6+00	95.9	89.36	6.5									
					+09.7	+07.7		B 1315 7689		Cancel off 912 W 31st St.		5-27-64 8-14-58
					+53.4	+55.4						
7+00												
	95.4	89.57	5.8	7+04.2								

#13538 Tap - 928 W. 31st Pl. Venoley Enterprises - 11-7-60 (7+04.2 MH)
#B-424 - 928 W. 31st St. Pipe Alloy - 11-19-63 - tap in M.H. at end of line.