168A

I 2

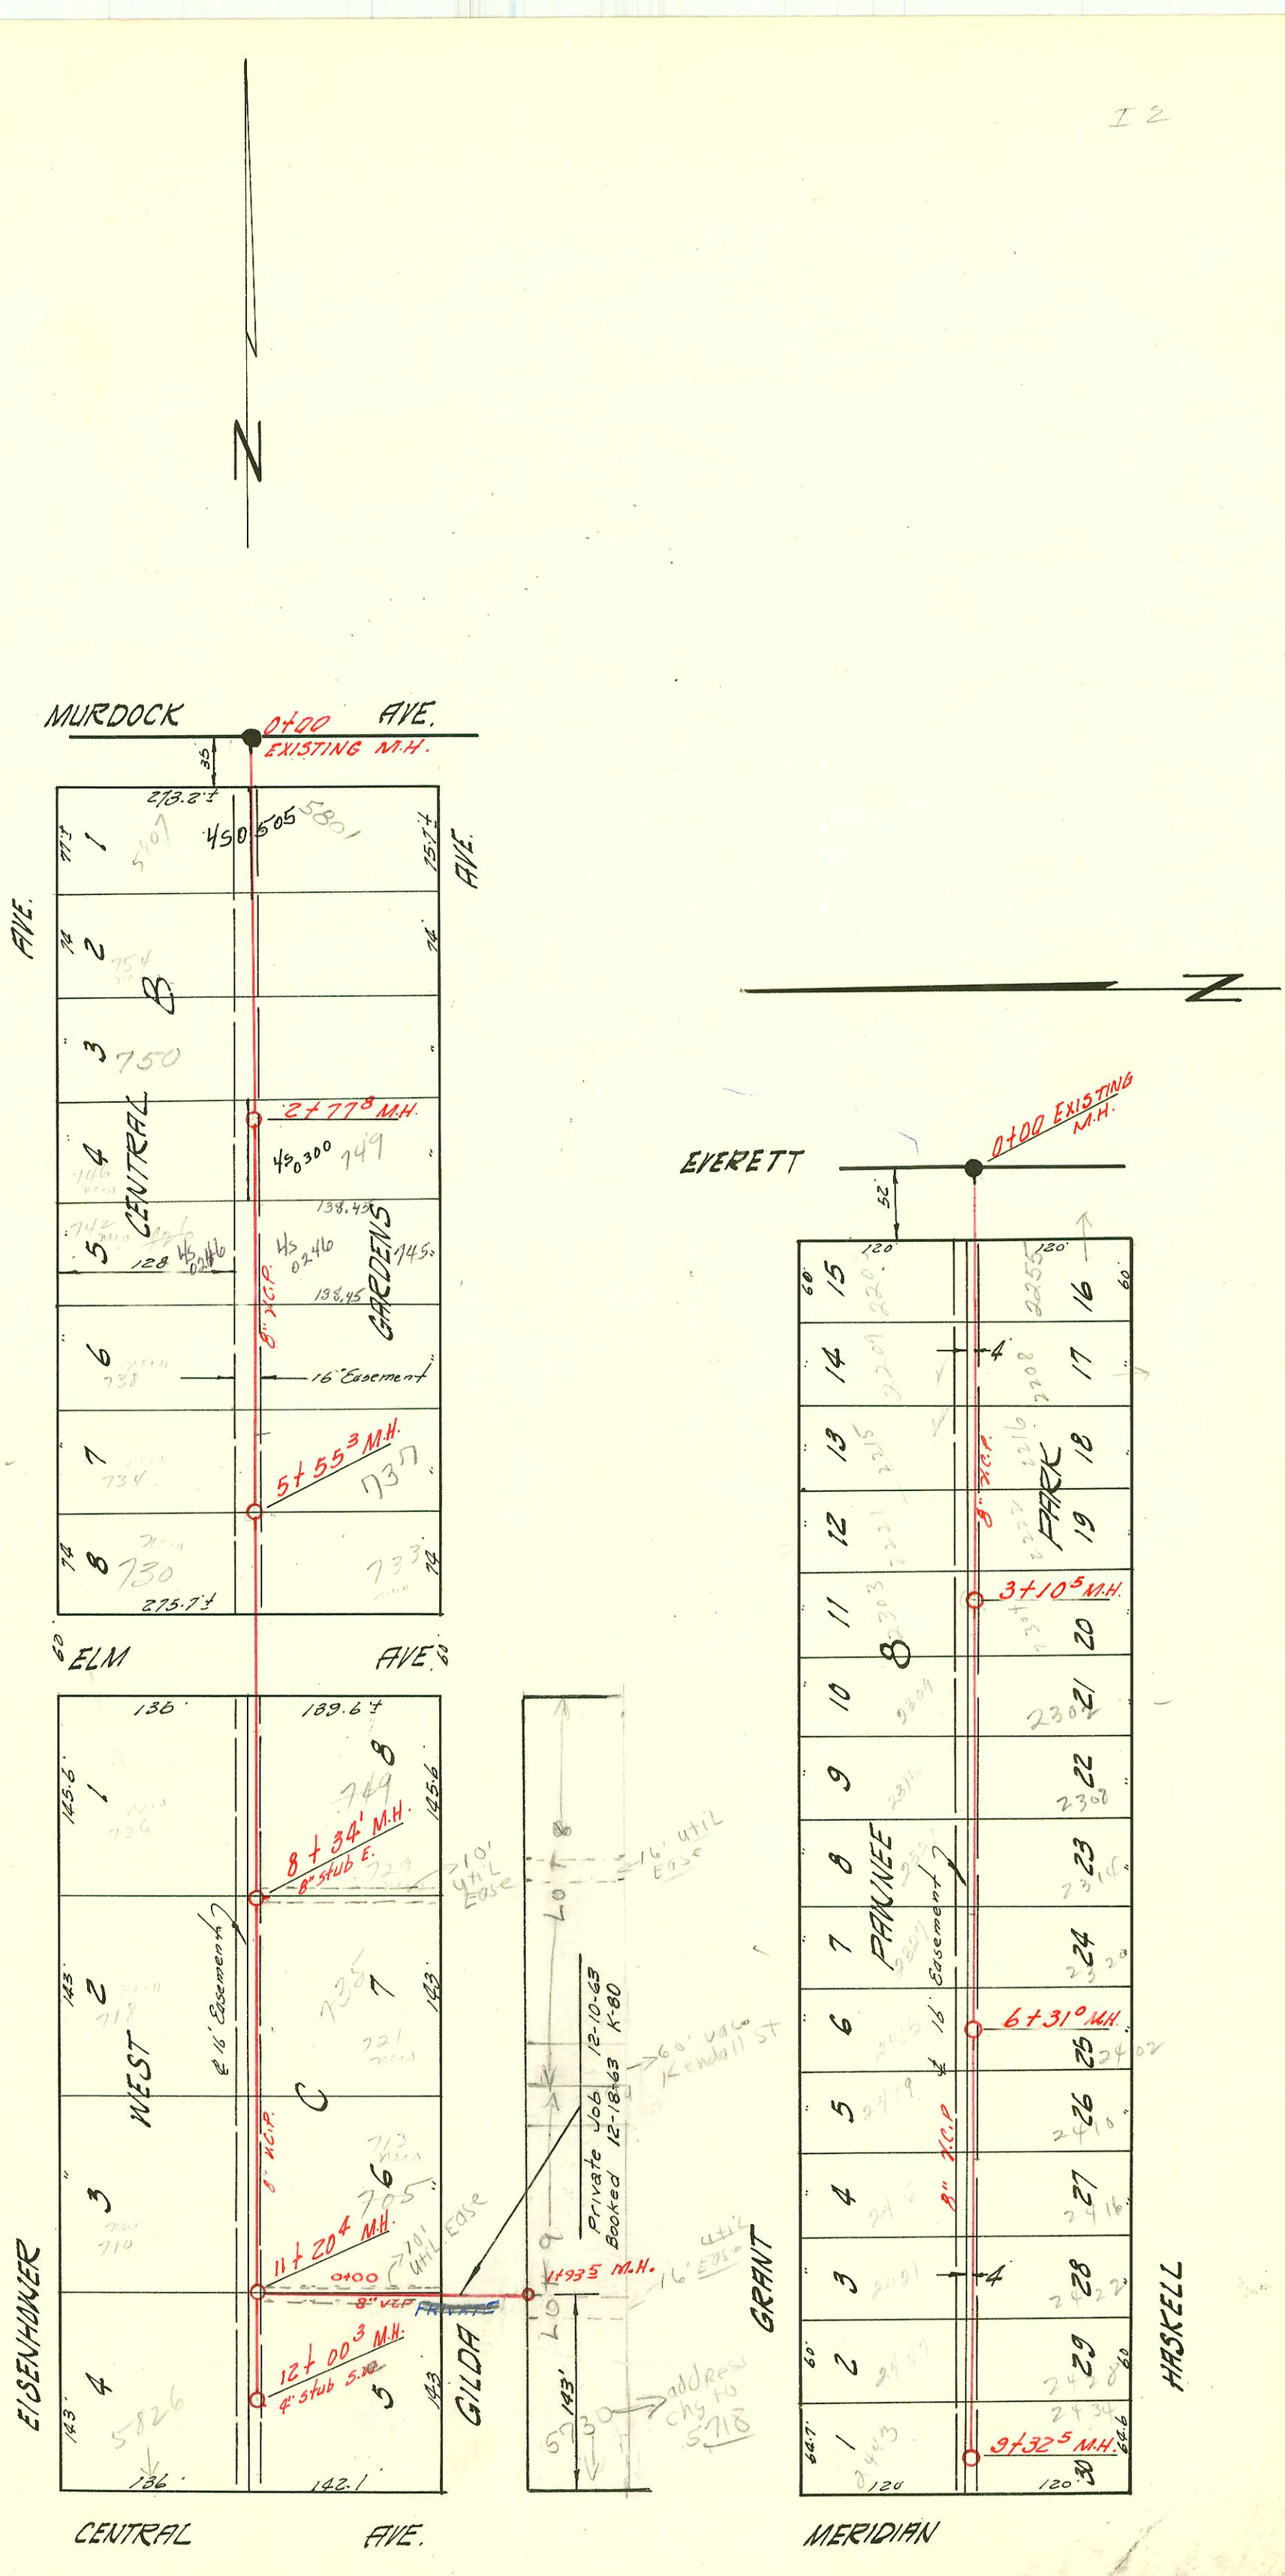

LATERAL 57 SUB. 5 S.S. 22
W.B. CARTER CONSTR CO. 9-22-58
BK. NO. K-55 PROJ. NO. C28-57

LATERAL 8 SUB. 3 S.S. 22
W.B. CARTER CONSTR. CO. 9-22-58
BK. NO. K-58 PROJ. NO. C25-16

168

Form 41-(54) 6-57

CONSTRUCTION RECORD / SERVICE RECORD

STATION	ELEVATION Ground	ELEVATION Grade	Depth	MANHOLE	4-INCH "Y" BRANCHES ~~North~~ West	4-INCH "Y" BRANCHES ~~South~~ East	No. of Permit North West	No. of Permit South East	House Number North West	House Number South East	DATE OF PERMITS North West	DATE OF PERMITS South East
LAT 57 -												
0+00	122.9	112.73	10.2	Existing M.H.	0+81.96 ~~+62~~	0+82.9 ~~+60~~	9640	4198	5807 W. Murdock	5801 W. Murdock	11-14-83	9-28-81
1+00	123.9	112.93	11.0									
					+43	+37	#13297 15831		754 R Eisenhower		5-14-81 6-29-62	
2+00	124.2	113.13	11.1									
					+12	+10	#C7297		750 Eisenhower		3-13-68	
	124.0	113.29	10.7	2+77								
					+84	+82	97-50977 14480	C59518	746 R Eisenhower	749 Gilda	9-29-97 7-25-61	1-19-77
3+00	124.0	113.33	10.7									
					3+61	+59	8249	C63924	~~826~~ M.H.? Eisenhower	746 Gilda	10-10-58	11-9-77
4+00	123.6	113.53	10.1									
					+32	+30	14625		738 Eisenhower		9-1-61	
5+00	123.2	113.73	9.5									
					5+04	5+02	20000 ~~764.7~~	98-6831-7	~~734~~ R Eisenhower	737 Gilda	1-26-68 12-11-62	4-29-98
	123.1	113.84	9.3	5+55								
					+80	5+78		B6083		733 Gilda		7-29-66
6+00	122.8	113.93	8.9									
7+00	122.5	114.13	8.4									
						+07		9660		729 ~~749~~ N. Gilda		3-20-59
					+22		10376 10389		~~714~~ 725 Eisenhower		9-17-80 5-20-59	
8+00	122.4	114.33	8.1		7+10.5 tap		1277		726 Eisenhower		9-17-80	
	122.5	114.40	8.1	8+34	8" stub E							
					+60	+58	20681 15920	8160	718 R Eisenhower	721 ~~735~~ Gilda	5-16-58 9-18-62	9-24-58
9+00	122.6	114.53	8.1									
					+94		10597		~~700~~ N Eisenhower		6-10-59	
10+00	122.1	114.73	7.4									
						+29		10851		713 ~~705~~ Gilda		7-10-59
						+67						
11+00	122.3	114.93	7.4									
	122.5	114.97	7.6	11+20	8" stub E							
					11+91		9936 16038 96-108387-7 20487		5826 S W. Central 5826 W. Central	Rp	12-29-83 8-17-62 7-9-97 4-18-88	
12+00												
	122.3	115.13	7.2	12+00	4" stub S.E.							
LAT. 8 SUB 3 S.S. 22												
0+00	102.1	94.00	8.1	EXISTING M.H	'Y' No	'Y' So						
					+71	+69	C76556 8077		2203 R Grant		2-25-58 9-22-58	
1+00	101.6	94.20	7.4			1+00		C3916		2255 R Everett 2308		7-13-67
					+27	+25	9060	56642 17211	2309 Grant	Haskell	1-28-59	7-12-76 10-23-96
					+87	+85	9061	10797	2315 Grant	2316 Haskell	1-28-59	9-9-59
2+00	101.7	94.40	7.3									
					+45	+43	8072	10064	2221 Grant	2222 Haskell	9-22-58	4-17-59
3+00	102.0	94.60	7.4									
					+02	+00	9062	10065	2303 Grant	2304 Haskell	1-28-59	4-17-59
	101.9	94.62	7.3	3+10								
					+70	4" P.V.C. 40 3+68	9063	94-16364-7 C22698	2309 Grant	2302 R Haskell	1-28-59	10-7-94-R 1-26-71
4+00	102.0	94.80	7.2									
					+28	4+41.4 4" Sch 40 PVC See Below 4+26	9064	92-10100-7 92-4218-7 C22699	2315 Grant	2308 R Haskell	1-28-59	7-2-92 3-26-92 1-26-71
					+92	See Below 4+90	9065	92-4219-7 C22700 92-10099-7	2321 Grant	2314 R Haskell	1-28-59	3-26-92 1-26-71 7-2-92
5+00	102.1	95.00	7.1									
					+47	4+76.4 4" Sch 40 PVC 5+45		#93-22103-7 C22701		2320 R Haskell		8-20-93 1-26-71
6+00	102.4	95.20	7.2									
					See Below +09	6+65.6 4" Sch 40 PVC 6+07	9067	92-10098-7 92-4220-7 C22702	2409 Grant	2402 R Haskell	1-28-59	7-2-92 3-26-92 1-26-71
	102.4	95.24	7.2	6+31								
					+69	+67	9068	#C22703	2409 Grant	2410 Haskell	1-28-59	1-26-71
7+00	102.8	95.40	7.4									
					+25	4" PVC 40 7+23	9069	#14641 C22704	2415 Grant	2416 R Haskell	1-28-59	11-12-91 1-26-71
					+90	7+88	9070	#26268 C22705	2421 Grant	2422 R Haskell	1-28-59	10-3-90 1-26-71
8+00	103.3	95.60	7.7									
					+50	4" Sch 40 PVC 8+48	9071	#27084 C22706	2427 Grant	2428 R Haskell	1-28-59	2-15-91 1-26-71
9+00	103.0	95.80	7.2									
					+11	4" Sch 40 PVC 9+09	8535	#27085 C22707	2443 Grant	2434 R Haskell	10-31-58	2-15-91 1-26-71
	103.1	95.86	7.2	9+32								
PRIVATE												
0+00	122.5	114.97	7.6	Exist. 0+00 (See 11+20 Above)								
1+00									chg addr to 5718 ~~5730~~ W. Central			
				1+93	m.H tap			B641			1-3-64	

94-4921-7

#9066 - Tap. 2327 Grant - Jet @ Bldg 1-28-59 (5+43.1) (R)

#13247 - Tap. 730 Eisenhower - Headgate to Bldg. 8-12-60 (5+97.3)

#98-4219-7 - 3314 W. Haskell - 3/26/92 - Permit Exp. NO Inspection.

#92-4220-7 - 2400 W. Haskell - 3/26/92 - NO Inspection Called.

#92-4218-7 - 2300 W. Haskell - 3-26-92 - NO Inspection Called.

4-7-94 4" ABS

96-108300-7 7-9-96 5826 W Central Line from Bldg add (4" SDR35) Does no exist line Just past C.O.