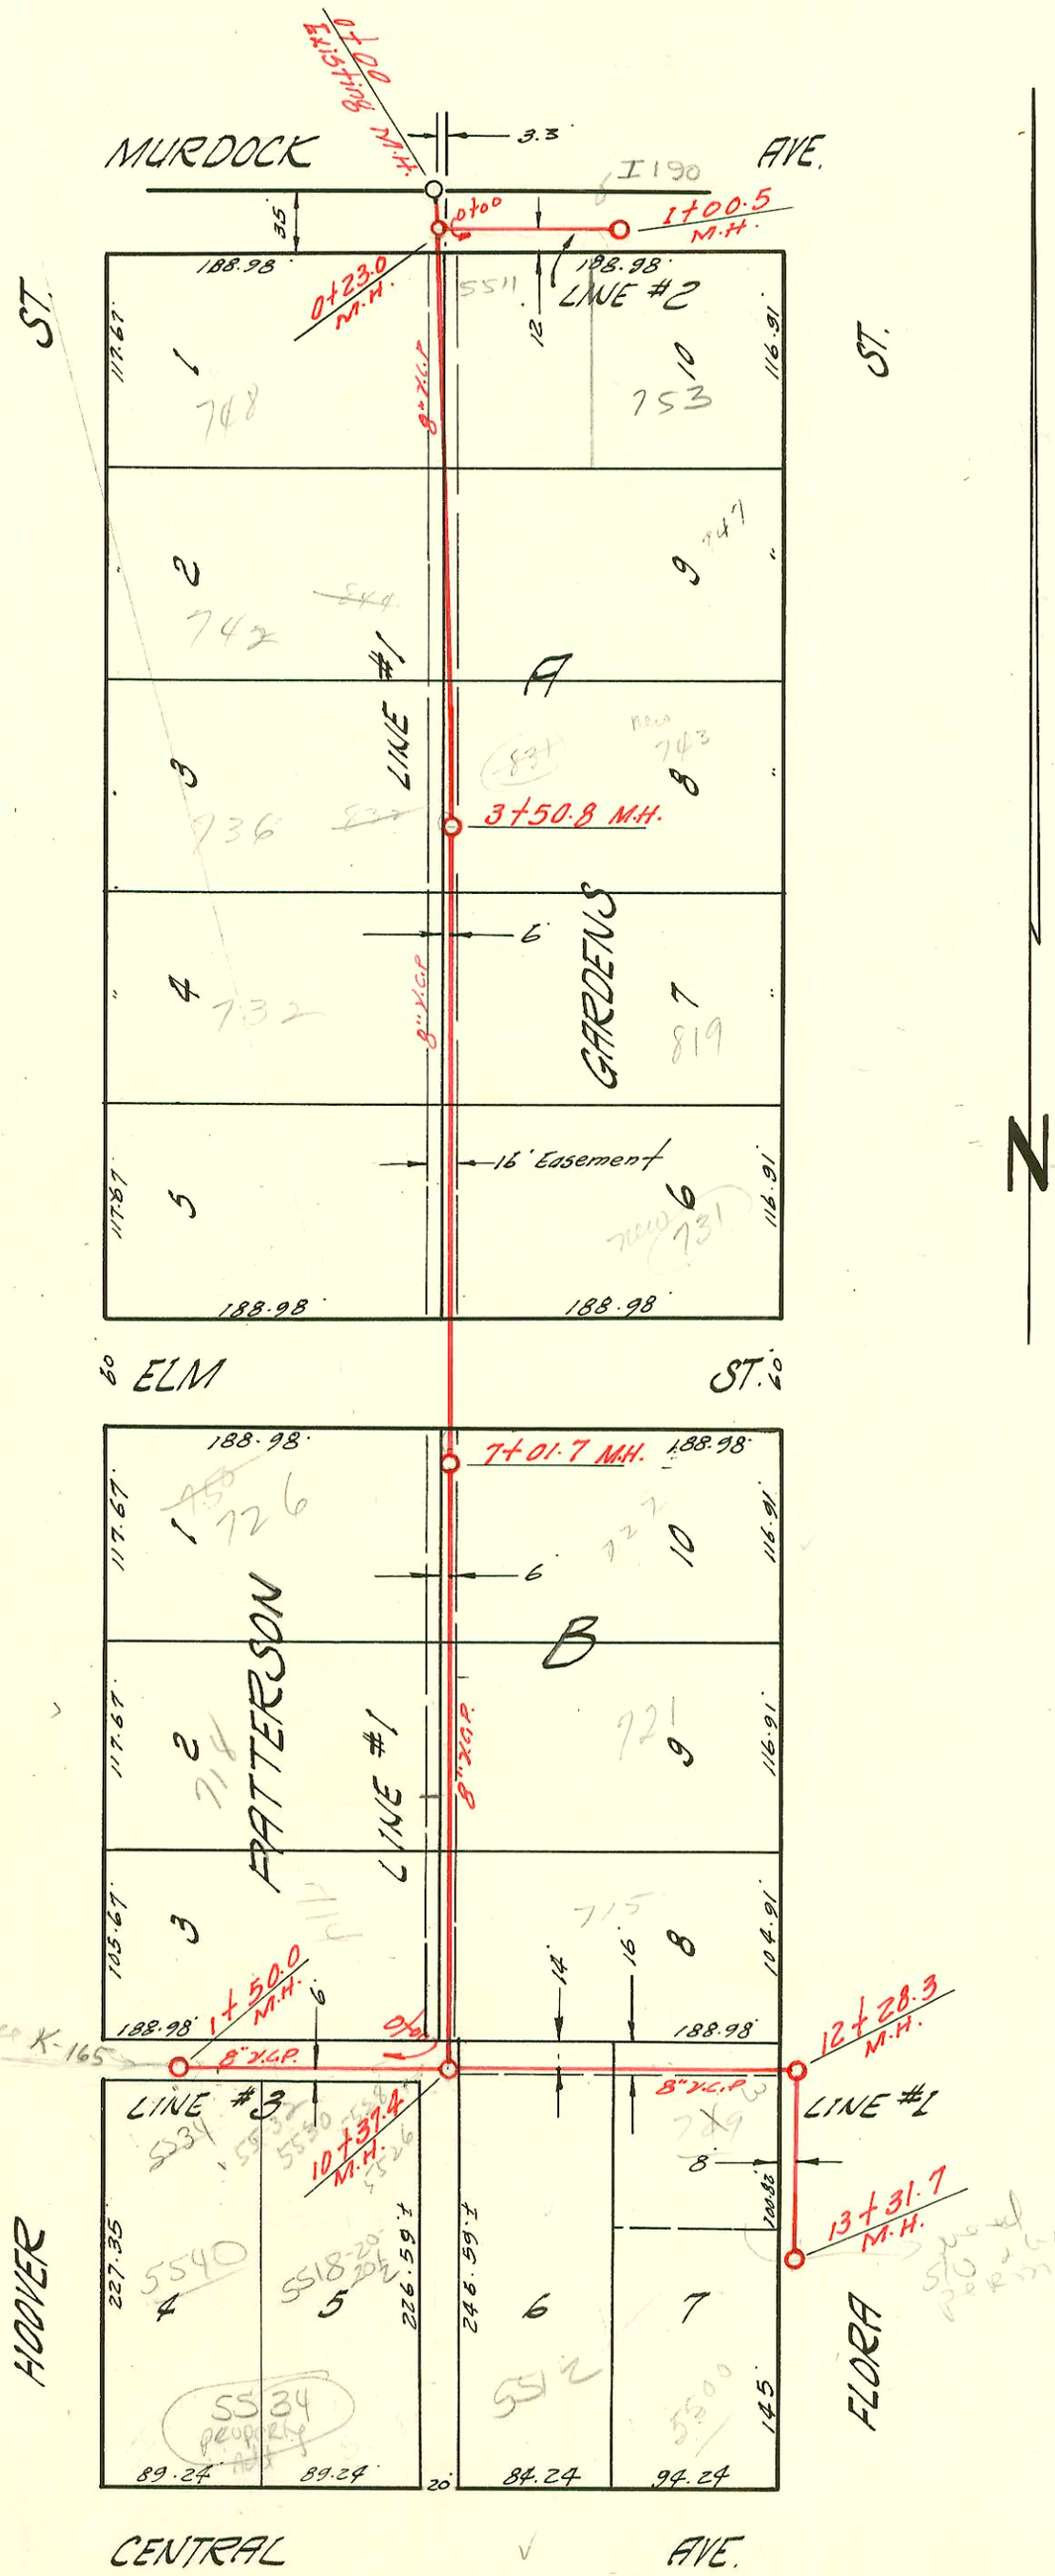

LATERAL 62 SUB. 5 S.S. 22
UTILITY CONTRACTORS INC. 11-6-58
BK. NO. K-52 PROJ. NO. C 28-64

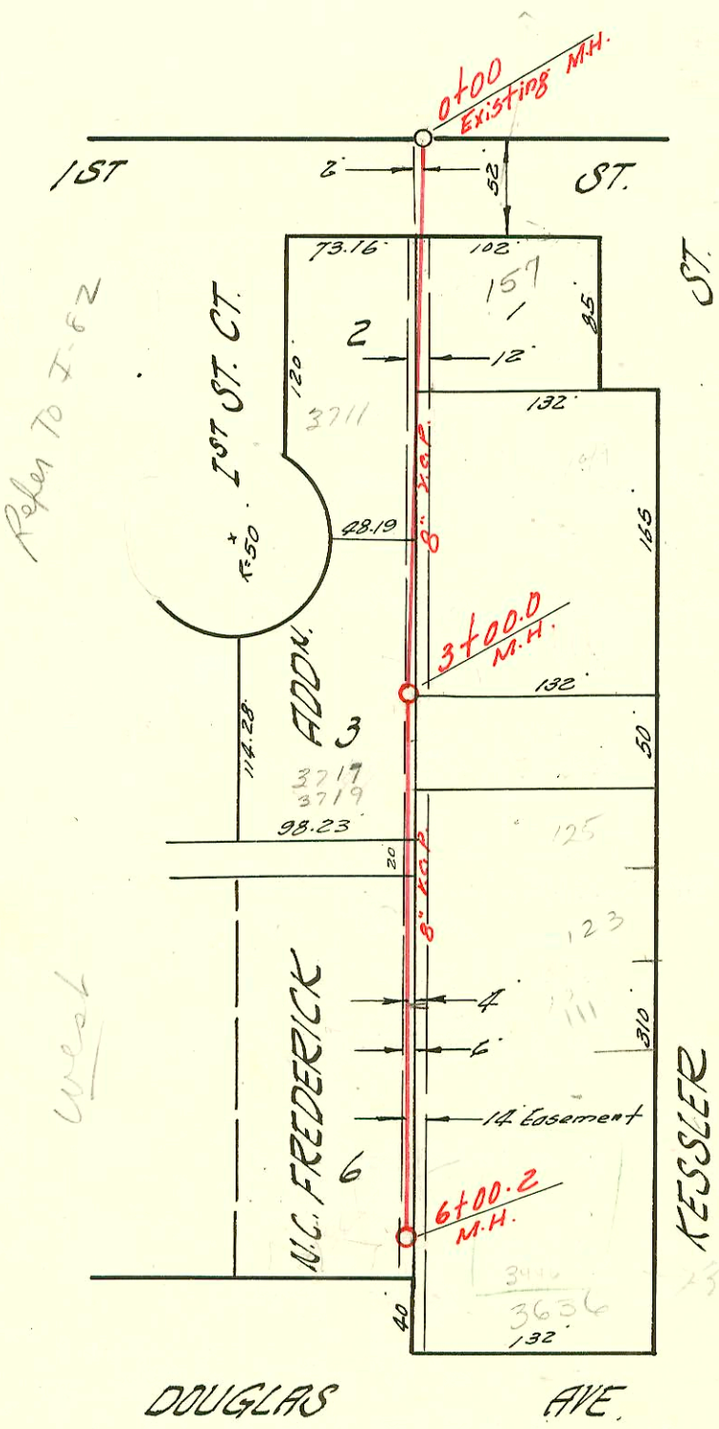

LATERAL 8 SUB. 6 S.S. 22
W.B. CARTER CONSTR. CO. 11-6-58
B.K. NO. K-58 PROJ. NO. C 28-8

193

Form 41-(54) 6-57

CONSTRUCTION RECORD / SERVICE RECORD

	STATION	ELEVATION Ground	ELEVATION Grade	Depth	MANHOLE	4-INCH "Y" BRANCHES ~~North~~ West	4-INCH "Y" BRANCHES ~~South~~ East	No. of Permit North West	No. of Permit South East	House Number North West	House Number South East	DATE OF PERMITS North West	DATE OF PERMITS South East
LAT. 62 SUB. 5 S.S. 22	LINE #1 0+00	123.2	113.40	9.8	Existing M.H.								
		123.2	113.49	9.7	0+23°								
						+99⁶	+97⁶	25440 15700	26810 12786	748 N. Hoover	5511 W. B, R Murdock	5-31-90 5-31-62	12-28-90 5-20-60
	1+00	123.1	113.80	9.3									
						+60⁶							
						+94⁹		15627		742 N. Hoover		5-11-62	
	2+00	123.5	114.20	9.3							747 R ~~743~~ N. Elora		
							+12⁶		18887 10821				8-17-87 7-9-59
						2+81⁹							
	3+00	123.3	114.60	8.7									
						3+22°	+20°	15620	19998	~~736~~ 719 N. R Hoover	~~831~~ 743 N. Elora	5-11-62	4-10-59
		123.3	114.80	8.5	3+50⁸								
						+95⁷							
	4+00	123.3	115.00	8.3									
						+42⁷	+40⁷	13718	9921	~~737~~ 711 Hoover	~~814~~ 737 N. Elora	12-29-60	4-1-59
	5+00	123.7	115.40	8.3									
						+09⁸							
						+19⁵		13941		5524 W. Elora	715 N. Elora	3-8-61	
							+57⁹		14123				4-27-61
	6+00	123.1	115.80	7.3									
	7+00												
		123.0	116.20	6.8	7+01⁷								
						+11⁹	+09⁹	11342	10379 16042	~~730~~ 726 N. Hoover	727 N. Elora	8-26-59	3-6-84 1-17-62
	8+00	122.9	116.60	6.3									
						+09⁹							
							4" Sch 40 P.V.C. +23⁶		~~15~~ 29⁷ 19249		721 R Elora		1-3-95 8-18-60
						+85⁶		12949		718 N. Hoover		6-15-60	
	9+00	122.8	117.00	5.8									
						+38⁸		3724		~~712~~ 714 N. Hoover		11-18-58	
							+86⁵		4 15727		715 N. Elora		6-7-62
	10+00	123.0	117.40	5.6									
		124.0	117.54 OUT 6.5 117.66 IN 6.4		10+37⁴								
	11+00	123.8	117.90	5.9		Top 10+46°			C42917		5512 W Central		1-2-73
						+03² (N)	‖ +01² (S)		15376		5512 W. Central		3-29-62
							4" Sch 40 Donut ‖ +72 (S)		2001-00146		5500 W NK Central		1-22-01
	12+00	124.1	118.30	5.8									
		124.0	118.40 OUT 5.6 118.48 IN 5.5		12+28³								
	13+00	124.4	118.80	5.6									
						Sealoff B+27°		2001-00567 14266		5500 S/O W Central	Plug + Concrete 3-19-01 1' from main 5' N of MH 6-7-61		
		124.6	118.92	5.7	13+31⁷								
LINE #2	0+00	123.0	117.32	5.7	Existing M.H.								
							O+94° (S)		12785		7537 Elora		5-20-60
	1+00	123.7	118.40	5.3	1+00⁵								
LINE #3	0+00	123.9	117.62	6.3	0+00								
							O+20⁹ 6" (S)		# B3412		See B/BW 5318-20-20½ W. Central		5-14-65
							O+50⁵ 6" (S)						
	1+00	123.8	118.04	5.8									
		123.6	118.24	5.4	1+50°								
							1+02⁵ 6" (S)						
LAT. 8 SUB. 6 S.S. 22	0+00	121.8	110.43	11.4	Existing M.H.								
							+78°		8667		3715 W. Inc		11-18-58
	1+00	119.9	110.73	9.2									
						1+45°	+72°		8880		149 N. Kessler		12-22-58
	2+00	118.6	111.03	7.6									
							+31²						
						+67⁴	+65⁴						
	3+00	117.1	111.33	5.8	3+00°								
						Top 3+20.1	+14°	C52876		3717-19 W. 1st St Cent			
							+69°		8879		125 N. Kessler		12-22-58
	4+00	116.4	111.63	4.8									
						+28²	+26²		8878		123 N. Kessler		12-22-58
						+76⁵	4 +74⁵		94-8495-7 10595		111 N. S/O Kessler		6-3-94 6-10-59
	5+00	116.2	111.93	4.3									
						+21⁴	5 +19⁴		9905		109 N. Kessler	5/B 3636 W. Douglas	4-1-59
						5 +59⁵		# 15870		3450 W. Douglas		7-16-62	
						5 +95⁸	5 +93⁸						
	6+00	116.6	112.23	4.4									
					6+00²								

97-16247 2-6-97 5518 W Central (adding Greenstrip)

1537 - 3448 W. Douglas 10-17-80 - Mike Bratcher 6+00.2 - N (5+52.2 or 48' N of MH)

#8621 - Top 157 N. Kessler - Joe McDonald Plbg. 11-12-58 1+16

#9403 - top 5530 W. Central - Bowers Plbg - 2-27-59 0+71

#12698 top Lot bound Wye 3448 W. Douglas Frederick Plbg 4-25-60 (3+98)

12351 T top 5532 W. Central Mr. Bowers 3-30-60 (1+04, line 3)

#14767 - top - 129 N. Kessler - 10-3-61 - Henry Hedgpeth Plbg (3+34.6)

15171 - top - 5534 W. Central - 9-8-62 Bowers Plbg (1+18 - Line 3)

15871 - top - 3451 W. Douglas - 9-10-62 Baker Plbg (5+50.2)

2000-02720-1 6020 - top - 709 N. Elora S/O - 8-14-62 - Keith Willard (11+58.3) - Caster Plbg - S/O with plug 12/14/00

B4872 - top - 5536 W. Central - 1-3-66 - Arnold Plbg (1+27.7 Line 3)