


LATERAL 6 SUB. 8 S.S. 22
 UTILITY CONTRACTORS INC. 11-5-58
 BK. NO. K-65 PROJ. NO. C27-52

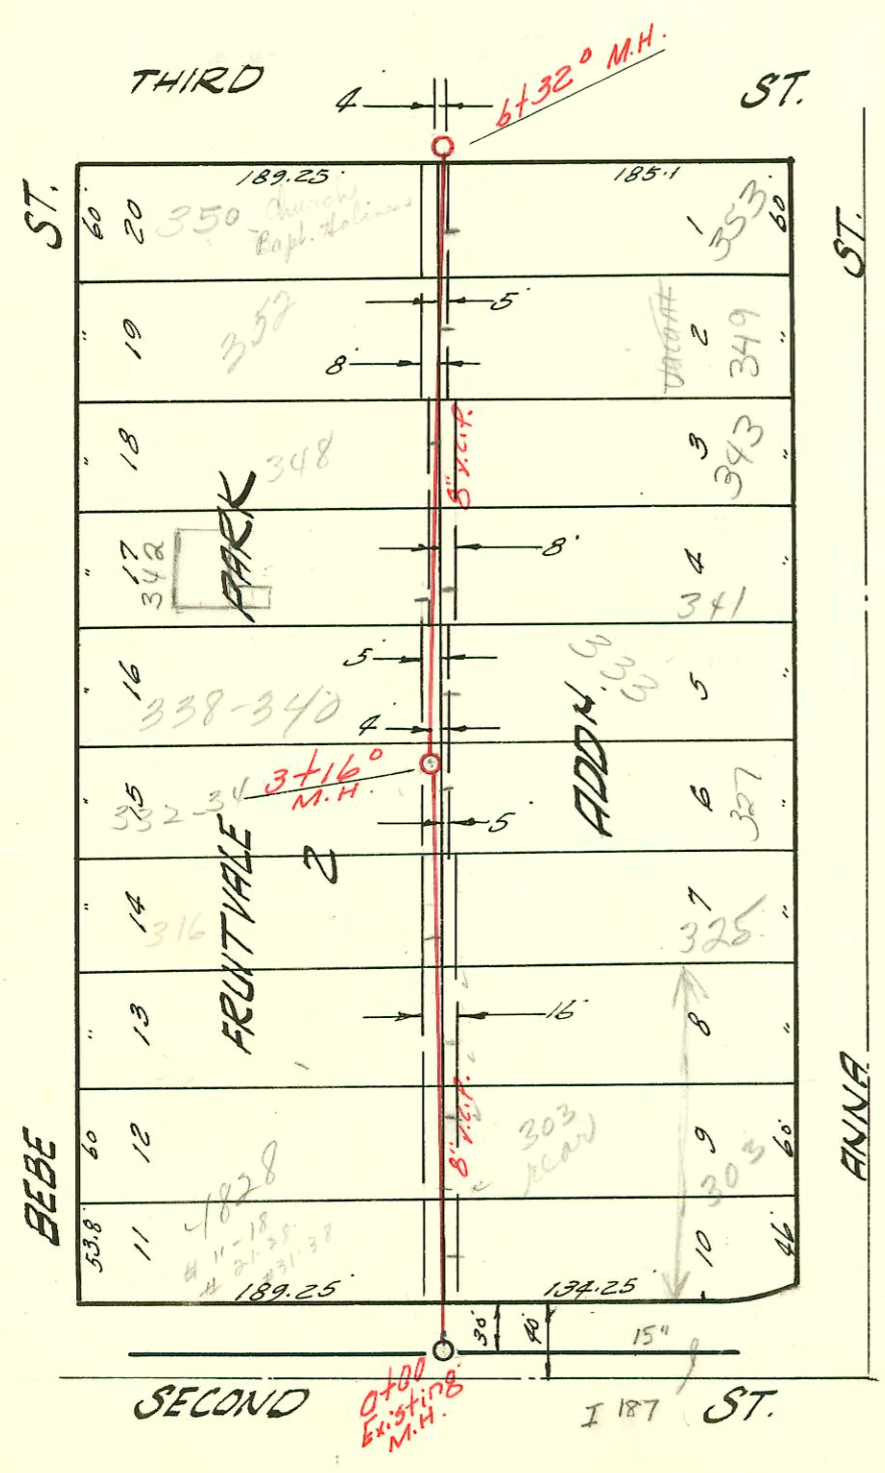

LATERAL 25 SUB. 5 S.S. 22
 W.B. CARTER CONSTR. CO. DEC 22, 58
 BK. NO. 51 PROJ. NO. C27-85

CONSTRUCTION RECORD						SERVICE RECORD							
STATION LINE #1	ELEVATION		Depth	MANHOLE	4-INCH "Y" BRANCHES		No. of Permit		House Number		DATE OF PERMITS		
	Ground	Grade			North West	South East	North West	South East	North West	South East	North West	South East	
0+00	120.4	108.04	12.4	Existing M.H.		4" SCH 40 +775		2000-02571 - Donut 14236	in 4 551 N.R. Sheridan			11-22-00 6-1-61	
1+00	118.6	108.44	10.2			+327		14068	575 N. Sheridan			1-13-61	
	118.2	108.69	9.5	1+625		+721		9818	509 Sheridan 575 N. Sheridan			2-5-59	
2+00	117.7	108.84	8.9			+193 4" Riser		9345	3320 ruevel			2-12-59	
						+733		24247 276367	537 N.A. Sheridan			11-8-89 11-25-80	
3+00	117.2	109.24	8.0			+721		12654	533 N. Sheridan			4-13-60	
						+216		86308	529 N. Sheridan			9-7-66	
4+00	117.4	109.64	7.8			+730		3664	521 N. Sheridan			7-14-81	
	117.5	109.93	7.6	4+732		+218	4+198	4821	517 N. Sheridan			11-30-81	
5+00	117.1	110.04	7.0			+813							
						+110	+1130	15609	3316 Helm	503 N. Sheridan		5-10-62 2-16-59	
117.0	110.26	6.7	5+175										
LINE # 1A													
0+00	118.2	108.81	9.4	Existing M.H.	Y.N.	Y.S.							
						+370							
1+00	118.8	109.19	9.7			+098	+078 4" Riser	1207		3322 ruevel		12-22-59	
	118.9	109.31	9.6	1+296									
LINE # 1B													
0+00	117.4	110.05	7.3	Existing M.H.	Y								
						+410	+390						
1+00	117.4	110.43	7.0			+210	+190	19970 (K) 40150 (S) 8897		33220 St. Louis		1-25-80 12-30-58	
	117.6	110.53	7.0	1+290				4615 8897					
LAT. 25 SUB. 5 S.S. 22													
0+00	119.7	112.00	7.7	Existing M.H.		+524							
						0+504	0+504	102017	9222	4828 (W) 121-28	303 N. Anna	12-5-80	2-17-59
						0+870	0+870		9223	4828 (W) 11-18	303 N. Anna (ward)		2-17-59
1+00	120.3	112.30	8.0			+230	+210	2016	9224	4828 (W) 11-18	303 N. Anna	12-5-80	2-17-59
						+413	+594						
2+00	120.4	112.60	7.8			+260	+240	2018	8898	4828 (W) 11-28	510 325 N. Anna	3-2-07 8-4-60	12-30-58
						+995	+995	2007 00489 13148	16950	33220 11-18	327 N. Anna	2-21-95	1-12-62
3+00	120.1	112.90	7.2			+815		952097 11484		33220 11-18		10-9-59	
	120.0	112.95	7.0	3+160									
4+00	121.0	113.20	7.8			+550	+530	11478	12349	338-340 N. Beebe	333 N. Anna	10-7-59	3-14-60
						+005	+025	11485	9007	342 N. Beebe	341 N. Anna	10-23-91 10-9-59	1-12-59
						+610	+747	11486	9161	348 N. Beebe	343 N. Anna	10-9-59	1-26-59
5+00	120.6	113.50	7.1			+332	+352	11471	813741	352 N. Beebe	344 N. Anna	9-30-59	9-6-95
						+686	+836	10830	9087	350 N. Beebe	353 N. Anna	7-9-59	1-30-59
6+00	121.9	113.80	8.1										
	121.9	113.90	8.0	6+320									

#16243 Top 4819 W 3rd French (5+77)