

Fees Street


Macarthur Elementary School

Macarthur Street

Roosevelt Street

Dunkin Street

Kays Street

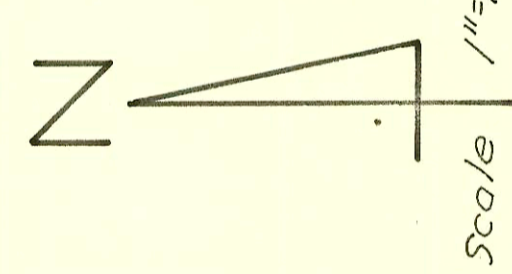

Portion of Plainview Sewer

CONSTRUCTION RECORD						SERVICE RECORD						
STATION	ELEVATION		Depth	MANHOLE	4-INCH "Y" BRANCHES		No. of Permit		House Number		DATE OF PERMITS	
	Ground	Grade			North West	South East	North West	South East	North West	South East	North West	South East
Portion of Plainview Sewer Line No. 1												
0+00				0+00 EXIST. M.H.								
1+00												
2+00												
3+00												
4+00				3+50								
5+00												
6+00												
7+00				6+15								
8+00												
9+00												
10+00												
11+00				10+65								
12+00				11+65								
13+00												
14+00												
15+00												
16+00				15+40								
17+00												
18+00												
19+00				18+50								
20+00												
21+00												
22+00				21+60								
23+00				23+85	22+73.2 TWP		23506		3051 S. Oliver		7-10-89	
24+00												
25+00												
26+00												
27+00												
28+00				28+45	top in m. 210233				478 PE 31m		8-27-68	
Line No. 2												
0+00	= 3+50 Line #1			0+00								
1+00												
2+00												
3+00				3+00								
4+00				4+70								
Line No. 3												
0+00	= 10+65 Line #1			0+00								
1+00												
2+00												
3+00				2+10								
4+00				4+40								
Line No. 4												
0+00	= 15+40 Line #1			0+00								
1+00												
2+00												
3+00												
4+00				4+70								
5+00												
6+00												
7+00												
8+00				8+00								

See next page for lines 5, 6, & 7

c 67417 - 2821 ⁵⁰ 7-18-78 ad Henning
 c 67419 - 2821 ⁵⁰ 10-9-78 ad Henning