


Portion of Plainview Sewer

3051  
(CONNECTION  
BLDG)

Water  
Reservoir

Civil  
Defense

Fire Department  
Training  
Center  
4780

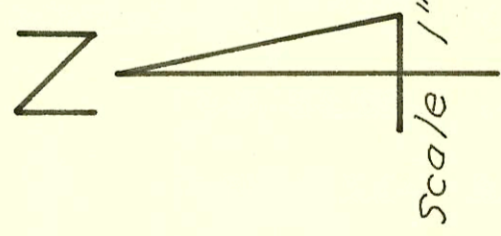

31st Street South

Oliver

Timpke

Kansas

CONSTRUCTION RECORD						SERVICE RECORD						
STATION	ELEVATION		Depth	MANHOLE	4-INCH "Y" BRANCHES		No. of Permit		House Number		DATE OF PERMITS	
	Ground	Grade			North West	South East	North West	South East	North West	South East	North West	South East
Portion of Plainview Sewer (Cont.)												
Line No. 5												
0+00				Line#1 0+00								
1+00												
2+00												
					2+65							
3+00												
4+00												
5+00												
					5+45							
Line No. 6												
0+00				Line#1 0+00								
1+00												
2+00												
					1+10							
					2+85							
Line No. 7												
0+00				Line#1 0+00								
1+00												
2+00												
3+00												
4+00												
					4+10							

# 25193 - 4/25/90 - 4778 E. 31st St (old civil Defense Bldg) - 510 115' W of EPL (inner edge of sidewalk) and 79' N of SPL