

I213A


LATERAL 175 SOUTHWEST INTERCEPTOR  
BUILT BY: UTILITY CONTR. INC.  
PROJ. N<sup>o</sup> 468-76-245-81186-000-000-001  
BOOKED 11-5-82 FROM BR 54

OR map


SCALE 1" = 200'

Lots 2, 3, 4 & 5  
Bk. T. Whertland  
Pl. 5th Addn  
requires special  
law. No lot. of main  
power easement  
5-2-85  
DRB

Plot 677

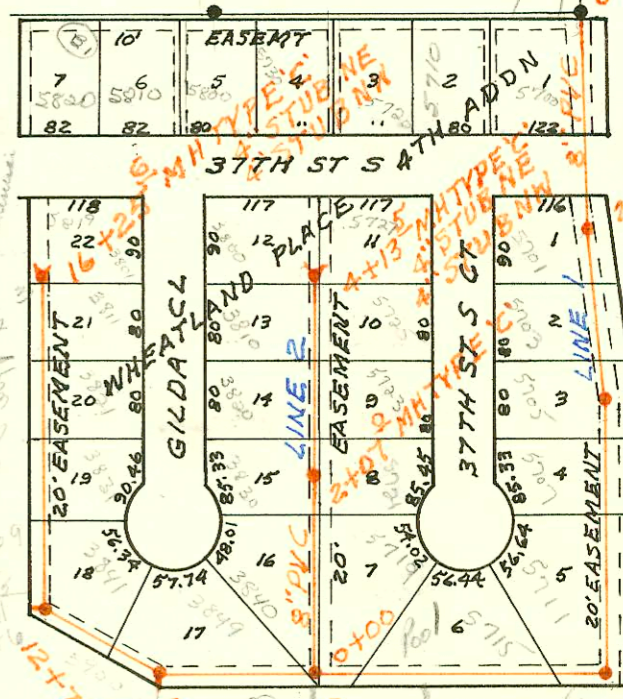

1200 Paid 2/26/87  
#18239 = \$400 assee fee  
per lot.  
lots 8, 9, 10

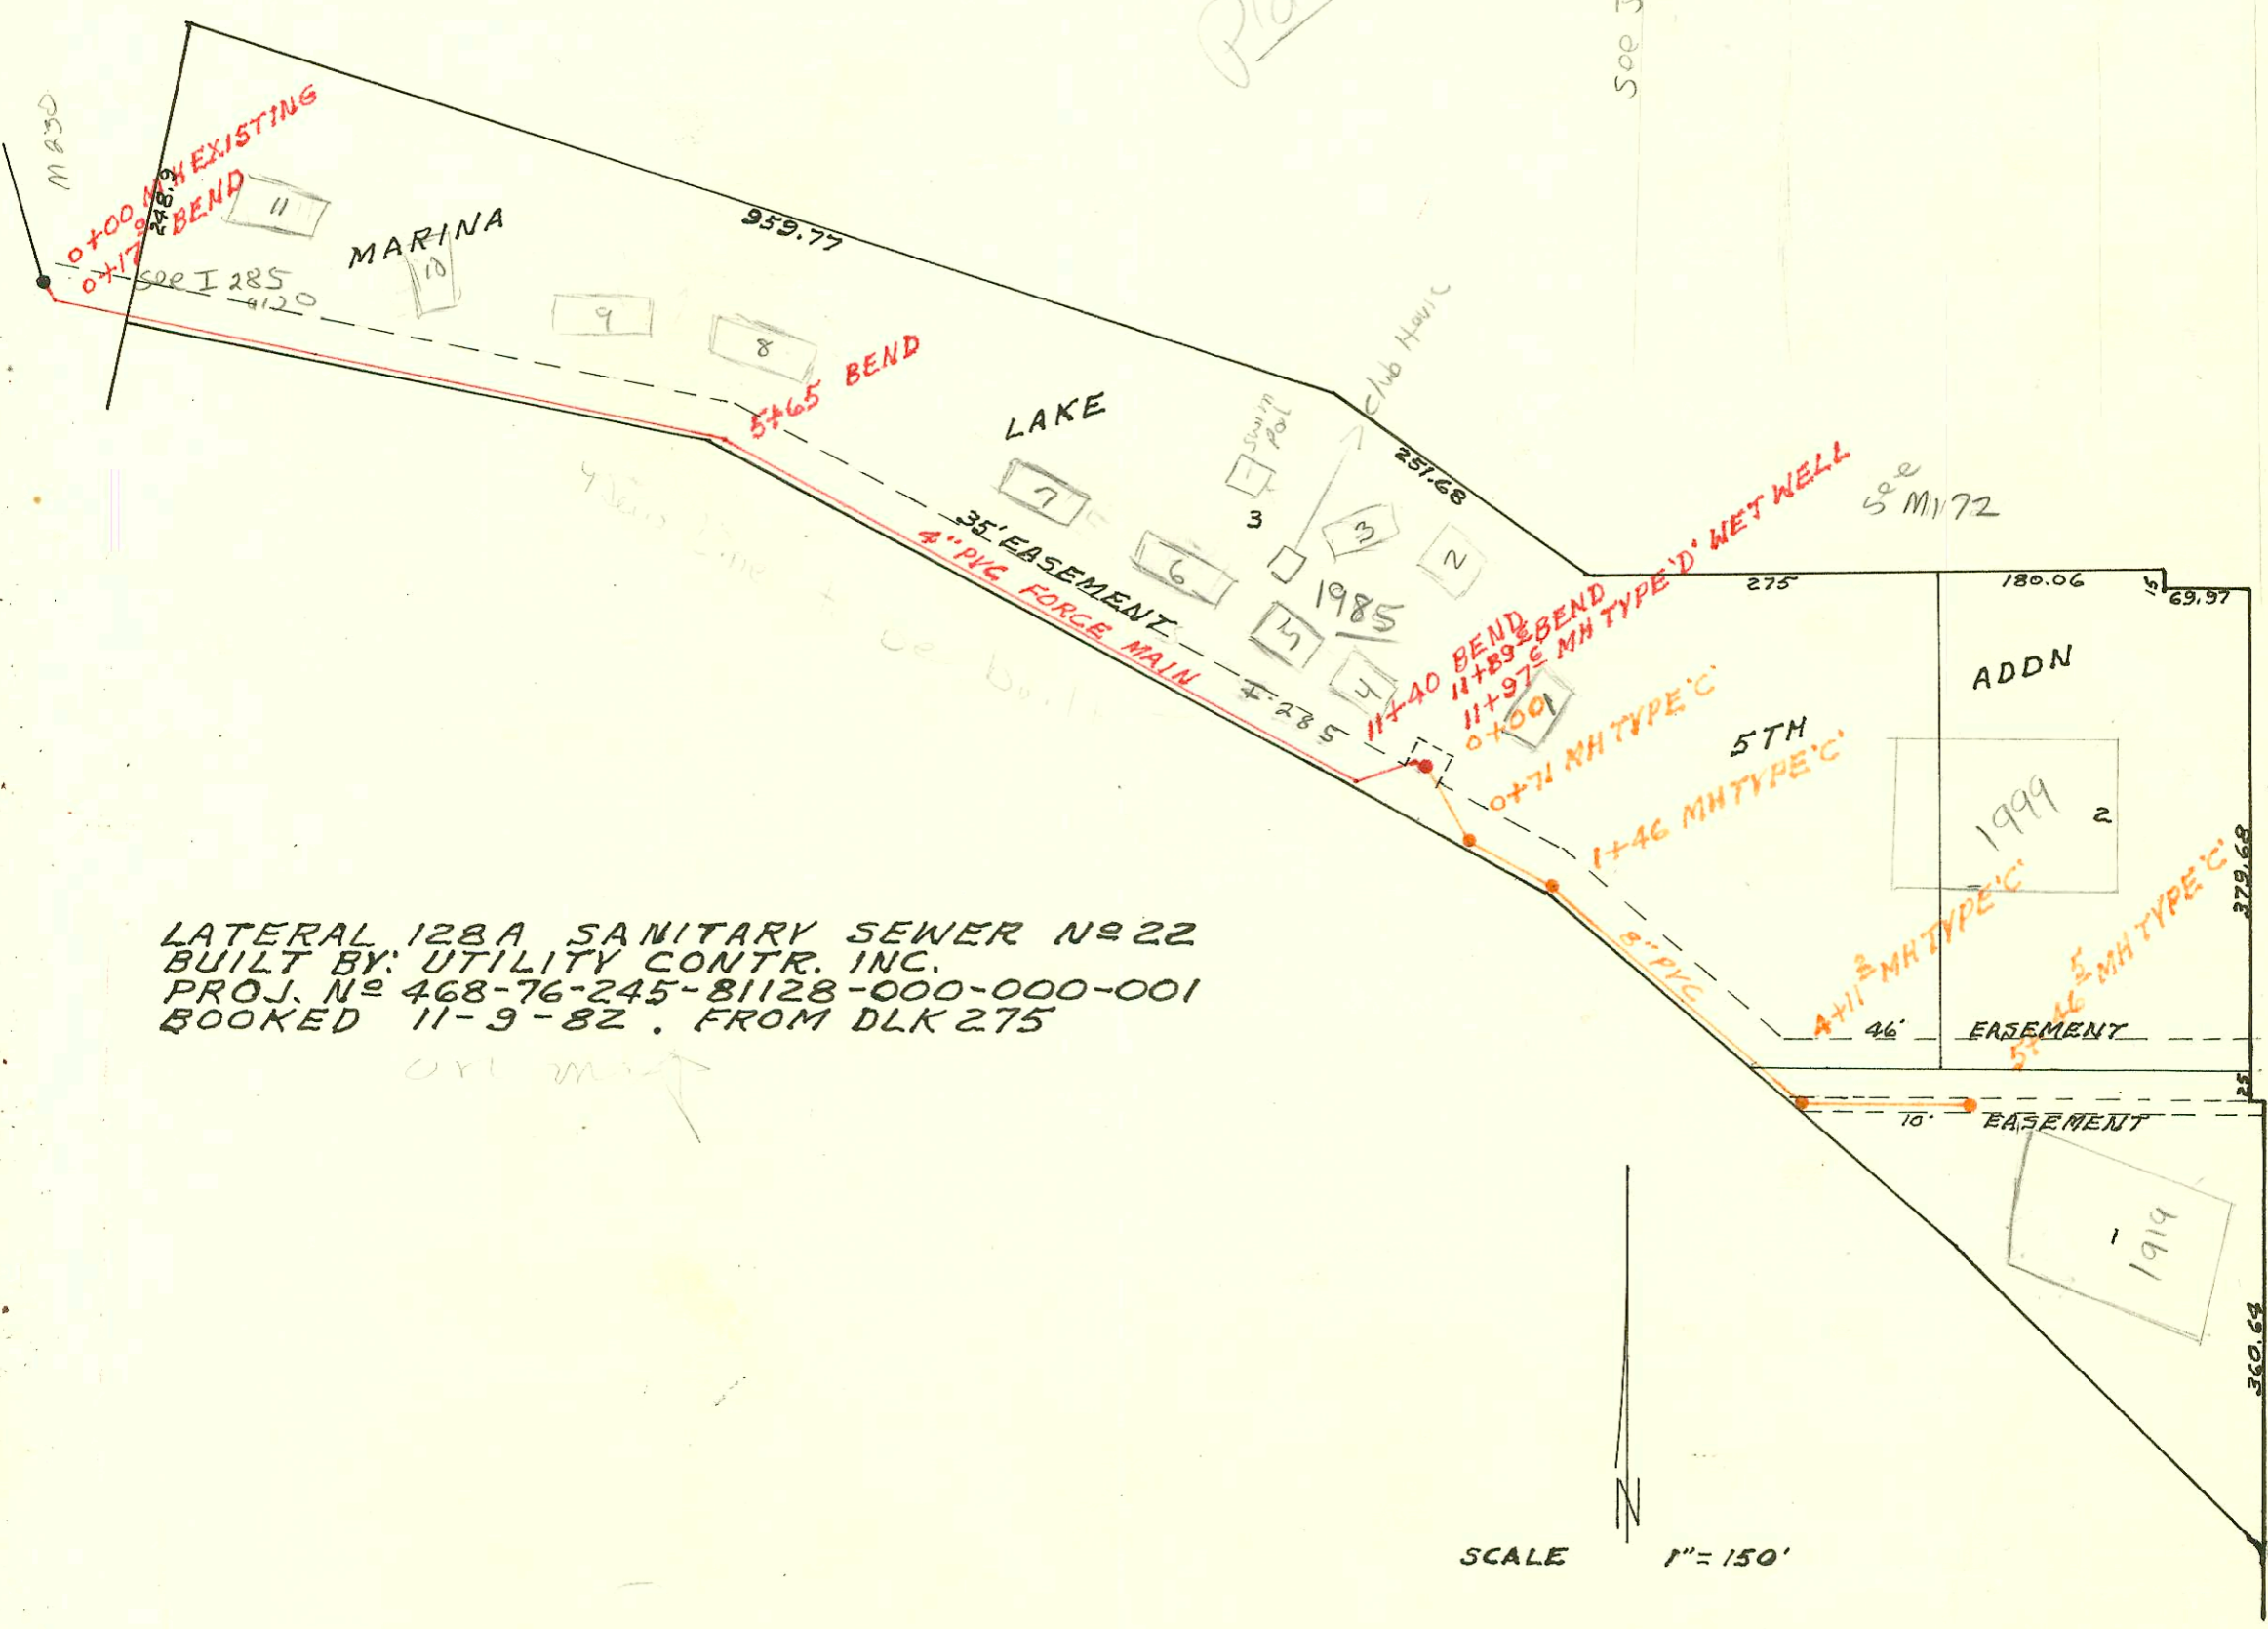

LATERAL 128A SANITARY SEWER N<sup>o</sup> 22  
BUILT BY: UTILITY CONTR. INC.  
PROJ. N<sup>o</sup> 468-76-245-81128-000-000-001  
BOOKED 11-9-82 FROM DLK 275

OR map

SCALE 1" = 150'

AMIDON

