



LATERAL 236 MAIN 5 SAN SEWER N^o22
 BUILT BY: UTILITY CONTR. INC.
 PROJ. N^o 468-76-245-81225-000-000-001
 BOOKED 2-4-83 FROM DLK 454

OUR MAP

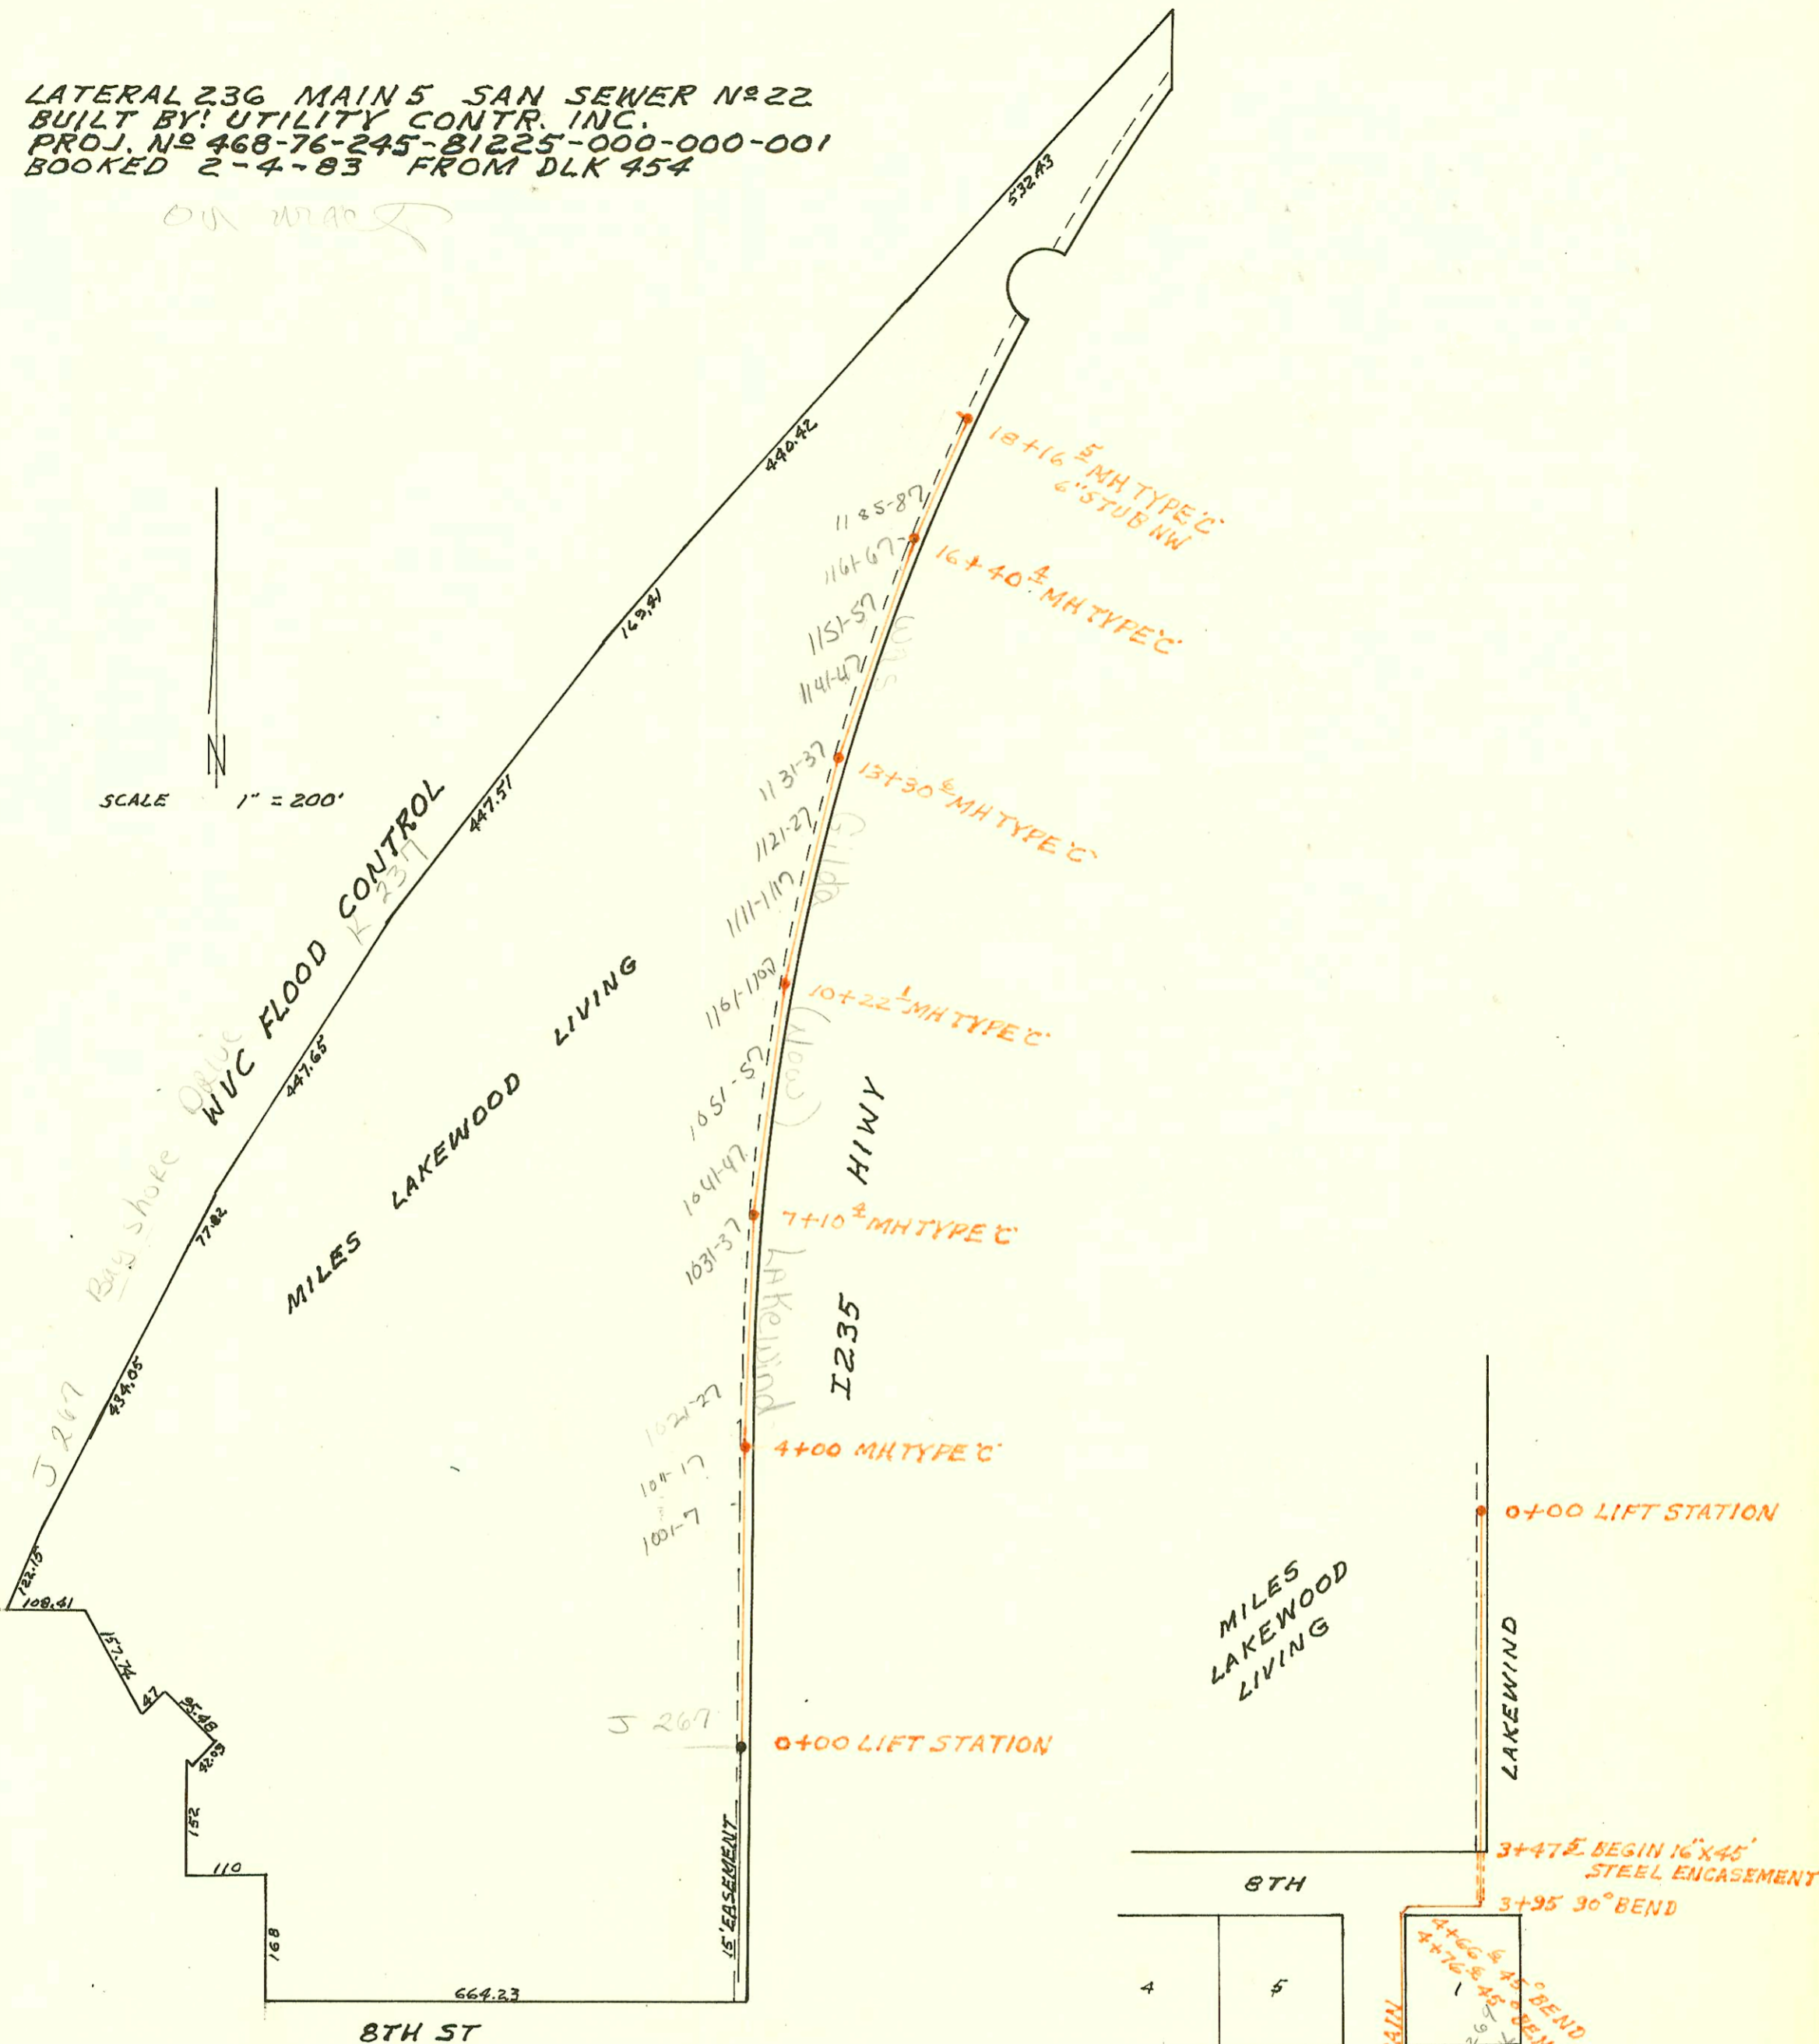

LIFT STATION & FORCE MAIN TO SERVE
 LOT 1 BLOCK 1 MILES LAKEWOOD LIVING ADDN
 BUILT BY: MID STATES CONST. CO.
 PROJ. N^o 468-76-245-81226-000-000-001
 BOOKED 7-22-83 FROM DLK 397

2-10-83
 1-10-83

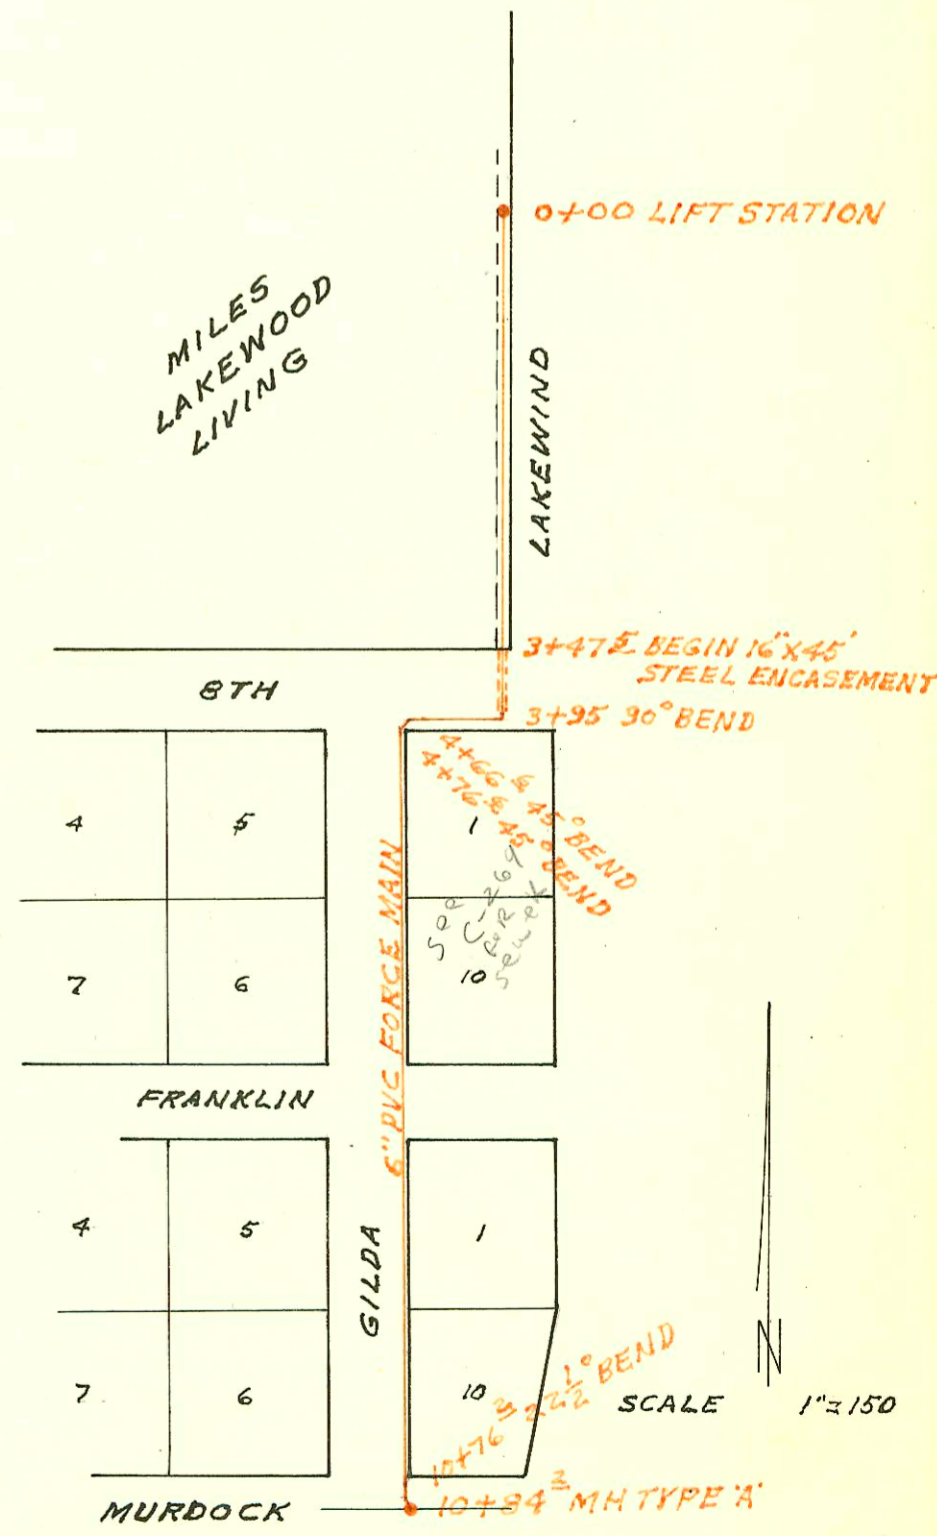

SCALE 1" = 150'

CONSTRUCTION RECORD						SERVICE RECORD						
STATION	ELEVATION		Depth	MANHOLE	4-INCH "Y" BRANCHES		No. of Permit		House Number		DATE OF PERMITS	
	Ground	Grade			North West	South East	North West	South East	North West	South East	North West	South East
LAT 236 MAIN 5 S.S. N ^o 22												
0+00	124.6	112.10	12.5	WET WELL								
1+00	124.3	112.44	11.9		1+14.2		7657		1001 Lakewood		2-11-83	
					1+83.8		7658		1003 Lakewood		3-11-83	
2+00	124.3	112.77	11.5		1+86.0		7659		1005 Lakewood		3-11-83	
3+00	124.6	113.11	11.5		3+27.0		7660		1007 Lakewood		2-11-83	
					3+74.0		7796		1025 Lakewood		4-8-83	
4+00	124.3	113.44	10.9	4+00	4+54.0		8092		1031 Lakewood		5-6-83	
					4+94.0		8097		1033 Lakewood		5-9-83	
5+00	123.9	113.76	10.1		5+37.6		8099		1037 Lakewood		5-9-83	
					5+56.4		8594		1041 Lakewood		6-30-83	
6+00	124.0	114.08	9.9									
7+00	123.8	114.41	9.4									
	124.2	114.44	9.8	7+10.4	7+39.4		8921		1101 Lakewood		8-4-83	
					8+00.4		8922		1103 Lakewood		8-4-83	
8+00	124.0	114.70	9.3		8+03.4		8923		1105 Lakewood		8-4-83	
					8+37.4		8924		1107 Lakewood		8-4-83	
9+00	124.0	114.99	9.0		9+09.1		9054		1111 Lakewood		8-24-83	
					9+12.1		9056		1115 Lakewood		8-24-83	
10+00	124.0	115.28	8.7		9+50.1		9057		1117 Lakewood		8-24-83	
	124.2	115.34	8.9	10+22.1	9+75.1		9491		1121 Lakewood		10-24-83	
11+00	123.8	115.58	8.2		10+14.1		9492		1123 Lakewood		10-24-83	
					10+16.1		7493		1125 Lakewood		10-24-83	
12+00	124.0	115.88	8.1		10+54.5		7494		1127 Lakewood		10-24-83	
					10+77.7		10605		1129 Lakewood		4-1-84	
13+00	124.3	116.19	8.1		11+14.7		10606		1133 Lakewood		4-11-84	
	124.9	116.28	8.6	13+30.6	11+17.1		10607		1137 Lakewood		4-11-84	
					11+53.1		10608		1139 Lakewood		4-11-84	
14+00	125.1	116.50	8.6		11+79.5		13727		Lakewood		5-20-85	
					12+16.6		13728		Lakewood		5-20-85	
15+00	125.0	116.80	8.2		12+26.6		13729		1143 Lakewood		5-20-85	
					12+53.6		13730		Lakewood		5-20-85	
16+00	125.1	117.11	8.0									
	125.1	117.24	7.9	16+40.4	115.01.40 PVC 16+59.3 NYC		94127597		1185-87 Lakewood		8-5-94	
17+00	124.8	117.44	7.4									
18+00	125.1	117.78	7.3									
	125.3	117.84	7.5	18+16.5	6" STUB NW							

LIFT STATION & FORCE MAIN TO SERVE LOT 1 BLK 1 MILES LAKEWOOD LIVING

0+00				LIFT STA								
3+47.5				16" X 45'								
3+92.5				STEEL ENCASUREMENT								
3+95				45° BEND								
4+66.6				45° BEND								
4+76.6				45° BEND								
10+76.2				22 1/2° BEND								
10+84.2	124.0	116.51 112.10		MH TYPE A								

Form #192-020 (July, 1981)
 #15902 - 3-20-86 1151 Lakewood - 26' W of MH
 #15903 - 3-20-86 1153 Lakewood 9.5' W of MH
 #15904 - 3-20-86 1155 Lakewood 12' W of MH
 #15905 - 3-20-86 1157 Lakewood 48' S of MH

93-6105-7 3-24-93 1161-1163 N Lakewood - (Private Road)
 (11+21.6 top) 209' S. of MH
 93-8046-7 4/15/93 - 1167 1169 N Lakewood - 140' S of MH (16+76.5 top)
 93-18931-7 7/15/93 - 1173-75 N. Lakewood - 124 ft S of MH (16+92.5 top)
 94-6132-7 4-21-94 1179-1181 N. Lakewood - W -