I220A

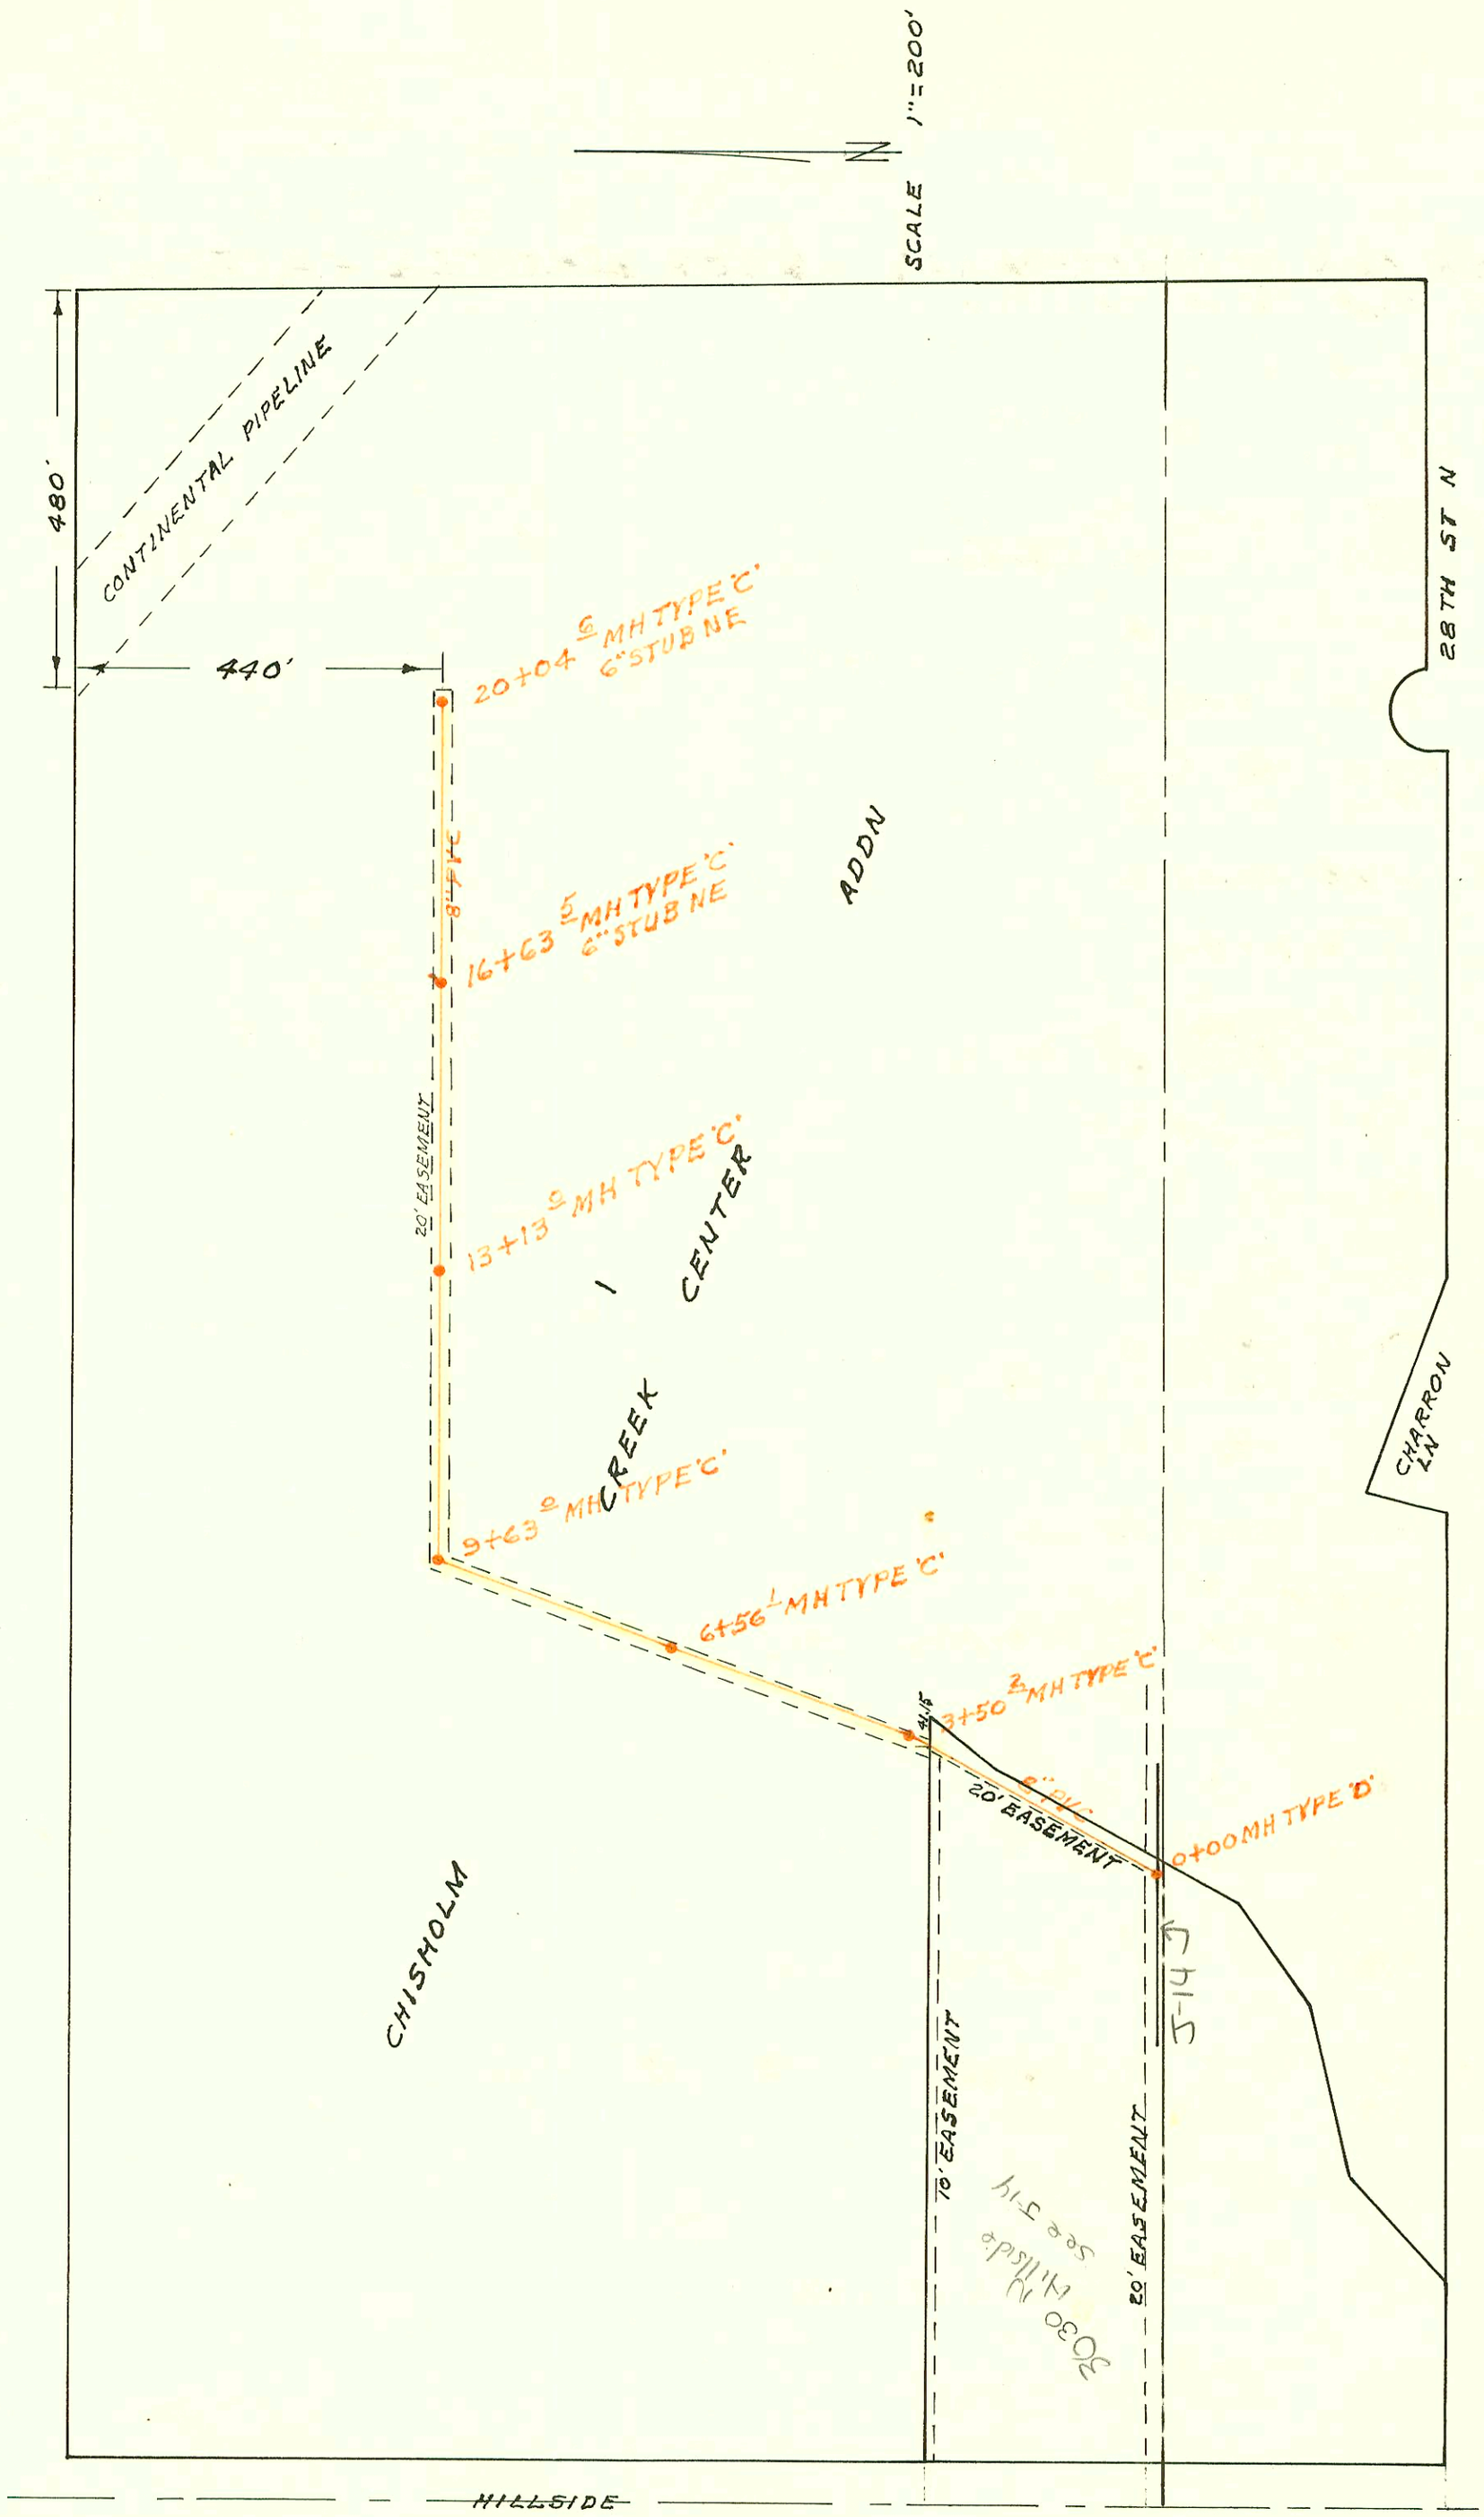

SANITARY SEWER FOR LOT 1
CHISHOLM CREEK CENTER ADDN
BUILT BY: MID STATES CONST. CO.
PROJ. № 468-76-245-80000-000-000-008
BOOKED 3-11-83 FROM TDC 52

on map

I220

CONSTRUCTION RECORD							SERVICE RECORD					
STATION	ELEVATION		Depth	MANHOLE	4-INCH "Y" BRANCHES		No. of Permit		House Number		DATE OF PERMITS	
	Ground	Grade			North West	South East	North West	South East	North West	South East	North West	South East
SAN SEWER FOR LT 1 CHISHOLM CREEK CENTER ADDN												
0+00	150.5	136.78	13.7	0+00								
1+00	150.4	137.71	12.7									
2+00	152.2	138.65	13.6									
3+00	150.7	139.58	11.1									
	152.4	140.05 140.15	12.4 12.3	3+50.2								
4+00	149.4	140.33	9.1									
5+00	150.0	140.69	9.3									
6+00	150.2	141.05	9.2									
	152.2	141.25	11.0	6+56.1								
7+00	149.9	141.43	8.5									
8+00	150.4	141.83	8.6									
9+00	150.1	142.23	7.9									
	152.6	142.48 142.58	10.1 10.0	9+63.0								
10+00	150.2	142.34	7.5									
11+00	150.7	143.17	7.5									
12+00	151.3	143.61	7.7									
13+00	151.8	144.04	7.8									
	152.5	144.10	8.4	13+13.0								
14+00	152.4	144.54	7.9									
15+00	153.2	145.05	8.2									
16+00	153.8	145.56	8.2									
	160.0	145.88	14.1	16+63.5	6" STUB NE							
17+00	160.1	146.01	14.1									
18+00	164.4	146.37	18.0									
19+00	157.3	146.73	10.6									
20+00	155.3	147.09	8.2									
	155.3	147.11	8.2	20+04.6	6" STUB NE							
SAN SEWER FOR LOT 1 ROCKWOOD 11TH ADDN PH I												
0+00	149.6	138.89	10.7	0+00 EXISTING								
1+00		141.08										
						1+17.0 TAP	2001-0283 25316		223 Rock Rd		8-15-01 5-14-90	
2+00		143.27										
	152.6	143.54 147.68	9.1 4.9	2+12.4	8" STUB W							
3+00		148.38										
	152.8	148.76	4.0	3+47.2								
						4+03.3	93-28427		333 N Rock Rd 101-102		11-3-93	
4+00		149.13				4+44.1	93-28418-7		" # 103		11-3-93	
						4+76.8	93-28414-7		" # 104		11-3-93	
5+00		149.83				5+12.4	93-28421-7		" # 105		11-3-93	
						5+43.3	93-28414-7		" # 106		11-3-93	
6+00		150.53				5+71.3	93-28422-7		" # 107		11-3-93	
7+00		151.23				7+01.2	93-28424-7		" # 108-109		11-3-93	
	156.4	151.37	5.0	7+19.4	8" STUB N							

Form #192-020 (July, 1981) 6659 - 333 N. Rock Rd see above 10-1-82 - David Gies (see bldg. lic. to plot site on top no meas. given by inspector)
6660 - " " see above