


30' SEWER ESMT.  
35' SEWER ESMT.

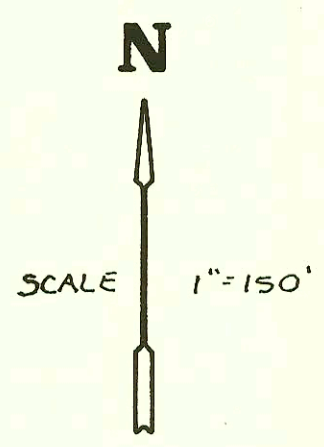

LAT 27, MAIN 22, WAR INDUSTRIES  
 P.L. #. 468-76-245-81307-000-000-001  
 Built by : MID-STATES CONST.  
 BOOKED 3-1-84 FROM MQP-23

18-31

WILDERNESS 3rd

See J-247

LAT 27  
LINE 1

LINE 2

LINE 3

LINE 4

LINE 5

LINE 6

CONSTRUCTION RECORD						SERVICE RECORD						
STATION	ELEVATION		Depth	MANHOLE	4-INCH "Y" BRANCHES		No. of Permit		House Number		DATE OF PERMITS	
	Ground	Grade			North West	South East	North West	South East	North West	South East	North West	South East
MAIN 22, WAR INDUSTRIES												
0+00	210.41	200.73	9.7	0+00								
1+00	209.2	201.80	7.4									
2+00	210.6	202.60	8.0									
3+00	212.6	203.40	9.2									
	214.68	206.75 IN	7.9	3+74.8								
4+00												
5+00	215.9	208.00	7.9									
6+00	217.8	208.80	9.0									
7+00	220.0	209.60	10.4									
	220.41	209.81	10.8	7+29.8								
8+00	222.0	210.40	11.6									
9+00	223.5	211.20	12.3									
10+00	224.5	212.00	12.5									
	224.53	212.44	12.1	10+74.6								
0+00	206.99	201.34	15.7	0+00								
1+00	210.0	202.16	7.8									
2+00	211.8	202.98	8.8									
3+00	214.5	203.80	10.7									
	216.82	206.21 IN	12.2	3+96.0								
4+00		206.25										
5+00	219.5	207.15	12.4									
6+00		208.05										
	221.90	208.14 OUT	13.8	6+09.6								
7+00	222.5	208.98	13.5									
8+00	222.4	209.78	12.6									
9+00	220.6	210.59	10.0									
10+00		211.39										
	220.42	211.47	9.0	10+09.7								
0+00	221.90	208.91	13.0	0+00								
1+00	221.2	209.72	11.5									
	221.49	209.93	11.6	1+26.5								
0+00	208.94	200.24	8.7	0+00								
1+00	211.5	201.07	10.4									
2+00	213.0	201.90	11.1									
3+00	214.0	202.73	10.3									
	216.02	206.26 IN	9.76	3+99.4								
4+00												
5+00	217.4	207.15	10.3									
	219.01	209.12 IN	9.9	5+85.5								
6+00	219.44	209.65	9.8	6+43.6								
0+00	216.02	206.26	9.8	0+00								
1+00												
	217.28	207.92	9.9	1+90.5								
0+00	207.90	199.06	8.8	0+00 EXIST								
	208.59	199.54	9.1	0+39.0								
1+00	209.6	200.51	9.1									

Permit would  
not be so  
long