


2101

LINE 1 4173 to 20+27
 ALL LINE 2
 LINE 4 4138 to 15+30

ARE NOT BUILT
 CLEAR

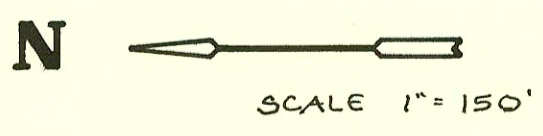

PRIV. S.S. TO SERVE LOT 1 MOBILE MANOR SOUTH
 P.L. # 46B-76-245-80000-000-000-008
 BUILT BY: MID-STATES CONST.
 BOOKED 4-25-84 FROM PLAN # DRH-11
 KW-13

8-79

CONSTRUCTION RECORD

SERVICE RECORD

PRIV. S
LINE 3

LINE 4

STATION	ELEVATION		Depth	MANHOLE	4-INCH "Y" BRANCHES		No. of Permit		House Number		DATE OF PERMITS	
	Ground	Grade			North West	South East	North West	South East	North West	South East	North West	South East
S. Lot 1, MOBILE MANOR				SOUTH (CONT)								
0+00	92.4	85.16	7.2	0+00 0+31.8 L-1								
1+00	92.5	85.56	6.9									
2+00	92.8	85.96	6.8									
3+00	93.1	86.36	6.7									
4+00	93.2	86.62	6.6	3+64								
5+00	93.3	86.76	6.5									
6+00	93.5	87.16	6.3									
7+00	94.0	87.96	6.0		6+50.0	6+51.0	10404 10405	10656 10655	618 519	419 518	3-6-84 3-6-84	4-16-84 4-16-84
8+00	94.1	88.07	6.0	7+28	7+50.0	7+51.0	10402 10403	10654 10653	616 517	417 516	3-6-84 3-6-84	4-16-84 4-16-84
9+00	94.2	88.36	5.8		8+00.0	8+01.0	10398 10399	10649 10650	612 513	413 512	3-6-84 3-6-84	4-16-84 4-16-84
10+00	94.4	88.76	5.6		8+50.0	8+51.0	10396 10397	10647 10648	511 610	510 411	3-6-84 3-6-84	4-16-84 4-16-84
11+00	94.6	89.16	5.4		9+00.0	9+01.0	10395 10394	10645 10646	509 608	508 409	3-6-84 3-6-84	4-16-84 4-16-84
12+00	94.9	89.53	5.4	10+92	9+51.0	9+48.0	10392 10391	10643 10644	507 606	407 506	3-6-84 3-6-84	4-16-84 4-16-84
13+00	94.9	89.53	5.4		10+01.0	10+00.0	10390 10389	10641 10640	505 604	504 405	3-6-84 3-6-84	4-16-84 4-16-84
14+00	94.9	89.53	5.4		10+53.0	10+53.0	10388 10389	10639 10640	602 503	502 403	3-6-84 3-6-84	4-16-84 4-16-84
15+00	94.9	89.53	5.4		10+87.5	10+87.5	10386 10387	10637 10638	501 600	401 500	3-6-84 3-6-84	4-16-84 4-16-84
0+00	92.4	85.16	7.2	0+00 0+31.8 L-1								
1+00	93.2	85.46	7.7									
2+00	94.7	85.76	8.9									
3+00	94.9	85.82	9.1	2+19								
4+00	95.3	86.06	9.2									
5+00	96.0	86.36	9.6									
6+00	96.5	86.47 OUT 86.57 IN	10.0	4+38	8" SUB W							
7+00	98.0	86.76	11.2				14201			2243 W. MacArthur	7-12-85	
8+00	95.8	87.06	8.7					14200		2101 W MacArthur	7-12-85	7-12-85
9+00	93.6	87.36	6.2		6+00.5	6+00.5	23097 23096	14177 14178	# 856 # 737	734 635	5-8-87 5-8-87	7-12-85 7-12-85
10+00	94.3	88.26	6.0		6+64.5	7+31.0	23094 23093	14195 14196	# 854 # 735	732 633	5-8-87 5-8-87	7-12-85 7-12-85
11+00	94.5	88.56	5.9		7+14.0	7+70.5	23092 23091	14193 14194	# 832 # 733	730 631	5-8-87 5-8-87	7-12-85 7-12-85
12+00	94.5	88.76	5.7	11+66	7+65.0	8+21.0	23090 23089	14191 14192	# 730 # 731	728 629	5-8-87 5-8-87	7-12-85 7-12-85
13+00	94.8	88.86	5.9		8+15.0	8+69.0	23088 23087	14189 14190	# 829 # 729	726 627	5-8-87 5-8-87	7-12-85 7-12-85
14+00	94.8	88.86	5.9		8+65.0	9+20.0	23086 23085	14187 14188	# 827 # 727	724 625	5-8-87 5-8-87	7-12-85 7-12-85
15+00	95.1	89.46	5.6		9+16.0	9+74.0	23084 23083	14185 14186	# 824 # 725	722 623	5-8-87 5-8-87	7-12-85 7-12-85
16+00	95.3	89.76	5.5		9+65.0	10+22.0	23082 23081	14183 14184	# 822 # 723	720 621	4-26-87 4-26-87	7-12-85 7-12-85
17+00	95.2	89.85	5.3	15+30	10+16.0	10+71.0	23080 23079	14181 14182	# 821 # 721	718 619	4-26-87 4-26-87	7-12-85 7-12-85
