I-27B A

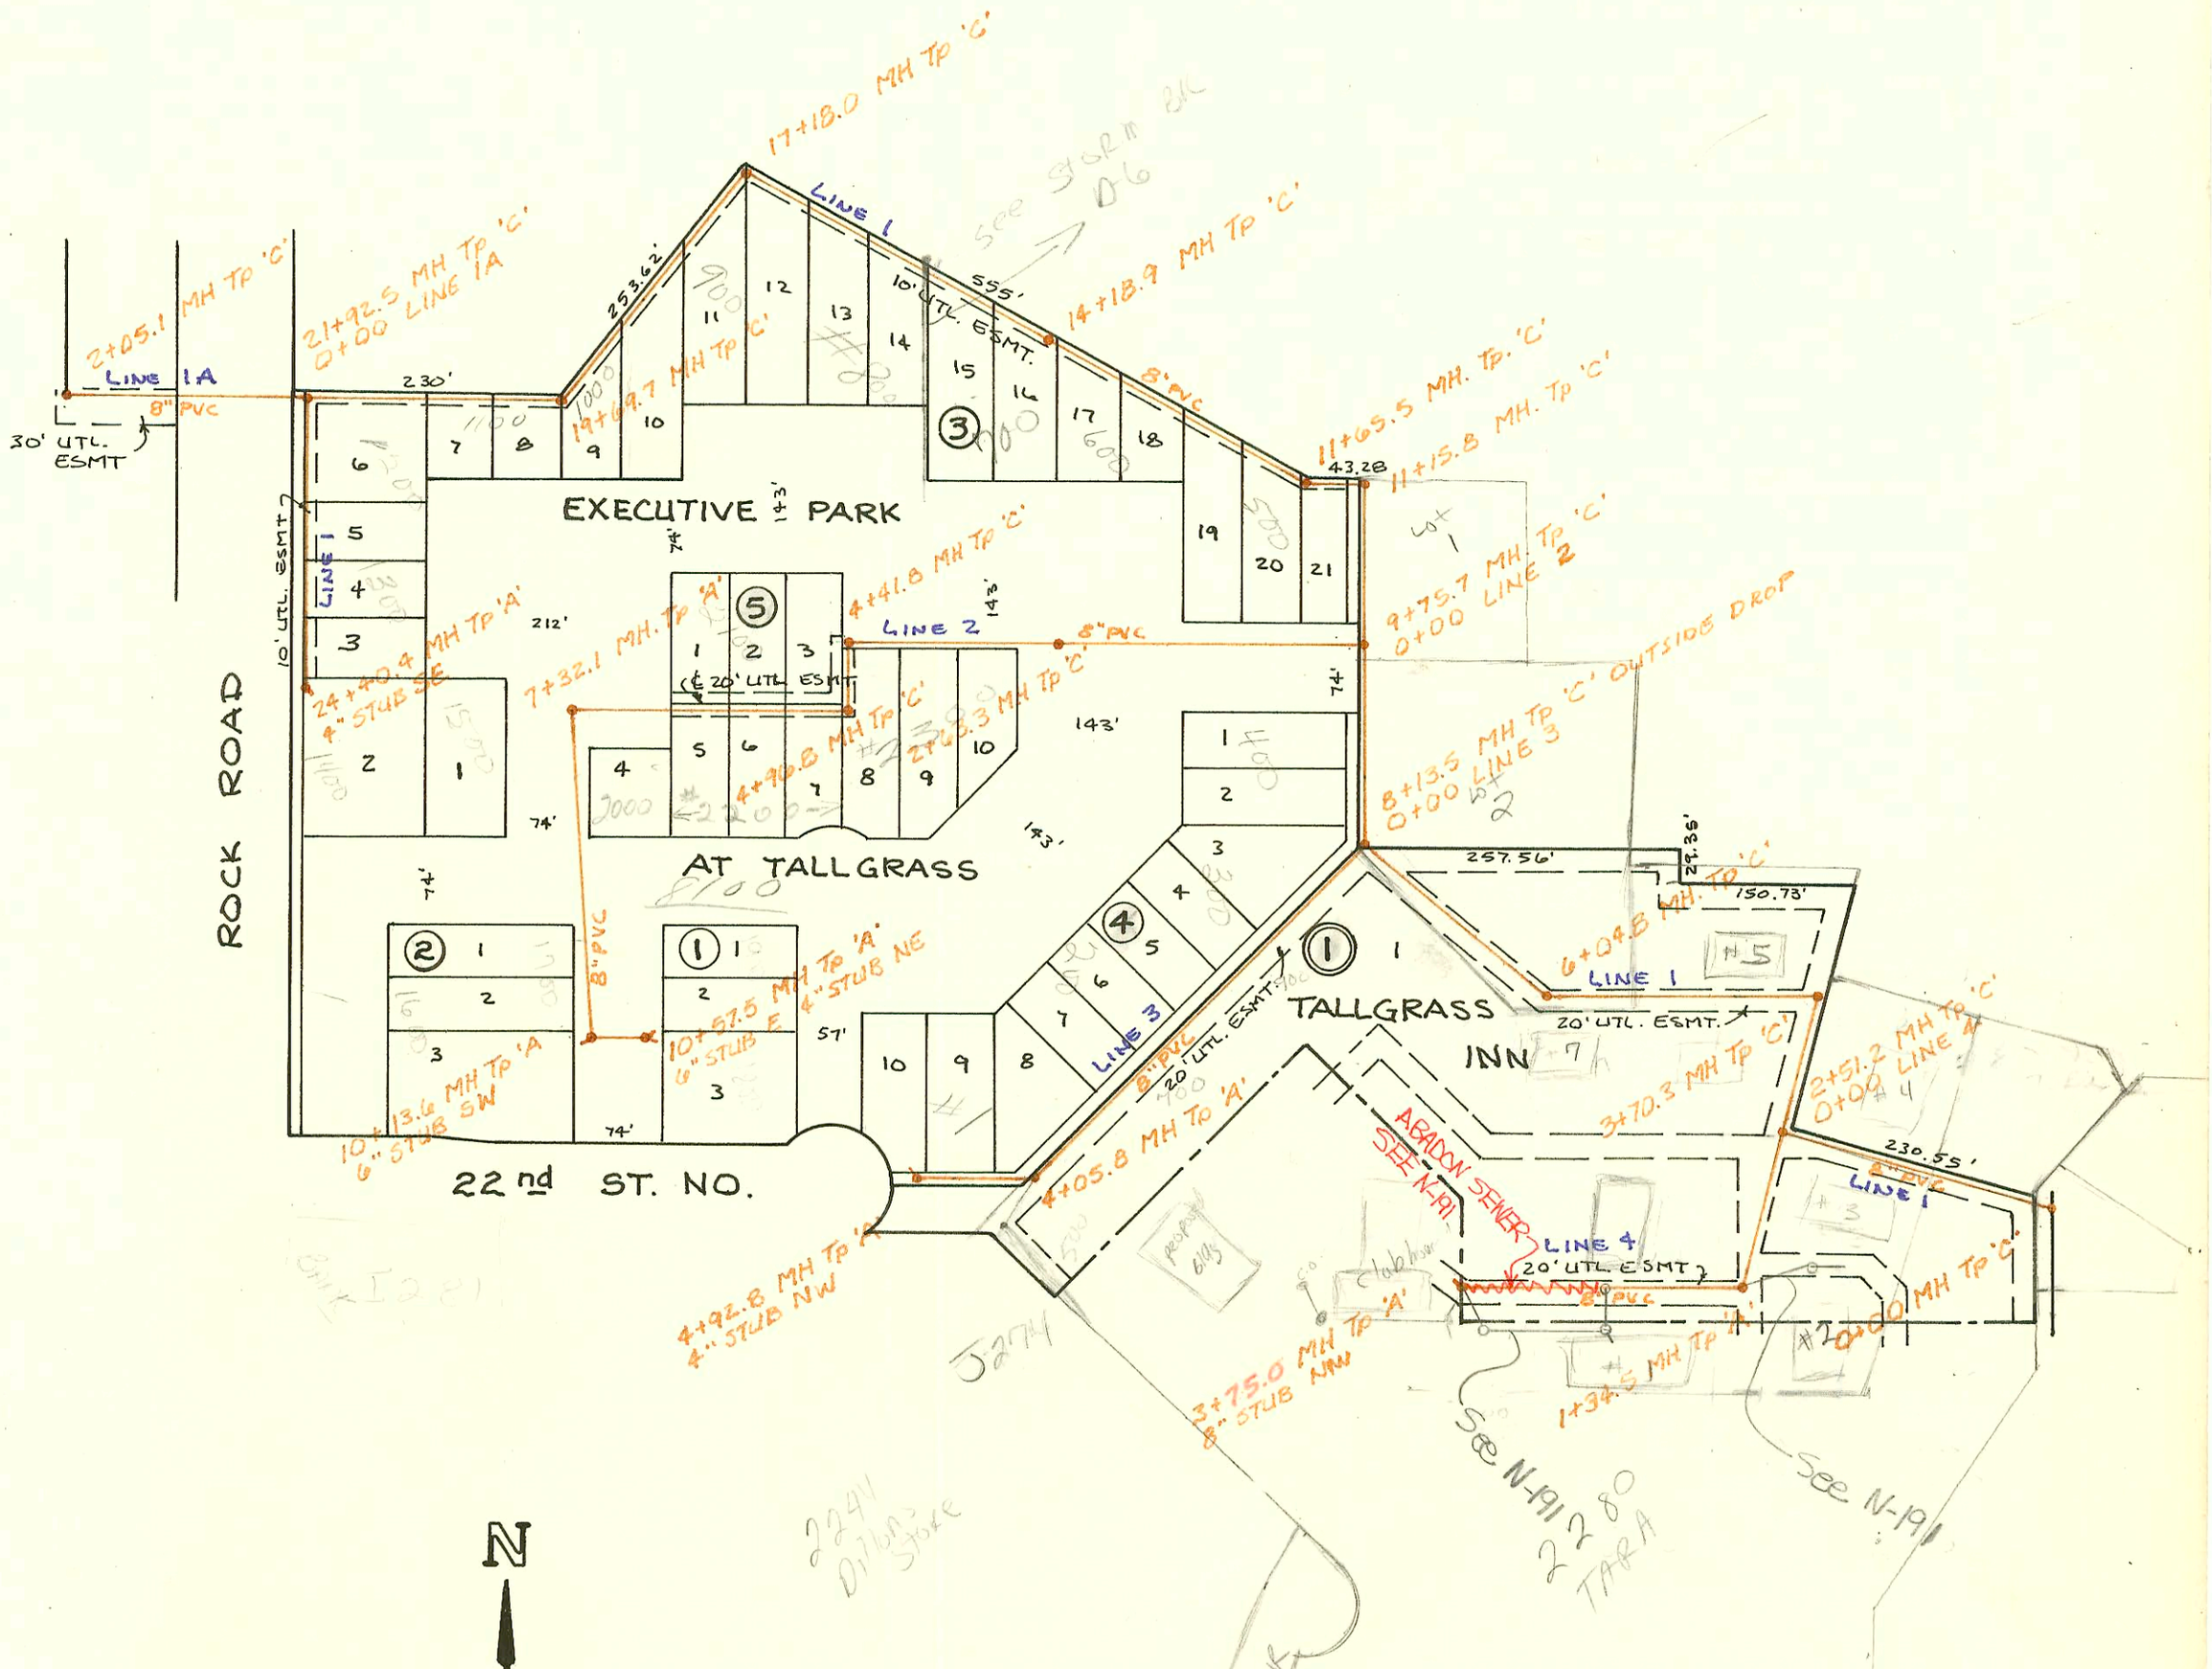

LAT 30, MAIN 22, WAR INDUSTRIES SEWER
PROJ. NO. 468-76-245-81311-000-000-001
BUILT BY UTILITY CONTRACTORS
BOOKED 7-12-84 FROM MGP-24

12-36

I-278

	CONSTRUCTION RECORD						SERVICE RECORD					
	STATION	ELEVATION Ground	ELEVATION Grade	Depth	MANHOLE	4-INCH "Y" BRANCHES North West	4-INCH "Y" BRANCHES South East	No. of Permit North West	No. of Permit South East	House Number North West	House Number South East	DATE OF PERMITS North West	DATE OF PERMITS South East
LAT 30	MAIN 22, W15.												
LINE 1	0+00	197.41	187.03	10.4	0+00								
							0+91.2 TAP		24607		2280 N TARA #3		1-11-90
	1+00	200.1	188.03	12.1		1+28.2 TAP		24606		2280 N. TARA #4		1-11-90	
	2+00	202.5	189.03	13.5									
		203.40	189.54	13.9	2+51.2 0+00 L-4								
	3+00	203.9	190.07	13.8									
		204.25	190.85	13.4	3+70.4								
	4+00	204.8	191.15	13.6									
							4+59.3 tap		11899		2280 P500		8-30-84
	5+00	205.5	192.16	13.3									
							5+74.3 tap		11898		2280 1300		8-30-84
	6+00	206.3	193.17	13.1									
		206.27	193.22	13.1	6+04.8								
	7+00	207.6	193.69	13.9									
	8+00	208.9	194.17	14.7									
		208.74	194.24	14.5	8+13.5 0+00 L-3								
	9+00	209.0	194.60	14.4									
		210.87	194.91	16.0	9+75.7 0+00 L-2								
	10+00	208.5	195.04	13.5		10+49.2 tap		15280		8100 E 22nd St.		12-17-85	
	11+00												
		207.93	195.65	12.2	11+15.8								
		207.94	196.14	11.8	11+65.5								
	12+00	208.2	196.26	11.9									
	13+00	207.4	196.63	11.0									
	14+00												
		206.62	197.07	9.5	14+18.9								
	15+00	205.1	197.43	7.7									
							15+77.9 tap		12239		8100 E 22nd St		10-12-84
	16+00	204.3	197.88	6.4									
									9685147		8100 #100 E 22ND		6-5-96
	17+00												
		207.76	198.41	9.4	17+18.0								
	18+00	209.3	199.09	10.2			4" SCH40 17+69.5		2000 019223		8000 E 22ND #100 Remodel		8-29-00
							18+62 tap		12644		8100 E 22nd St 900		11-26-84
	19+00	214.2	199.92	14.3									
		212.72	200.50	12.2	19+69.7		19+53.7 TAP		24271		8100 E 22nd #1000		11-13-89
	20+00	213.6	200.66	12.9			20+16.2 tap		12374		8100 E. 22nd #1100		10-23-84
	21+00	214.3	201.21	13.1									
		214.32	201.71 203.67	12.6 10.6	21+92.5 0+00 L-1A		21+20.2 tap		12650		8100 E 22nd St		11-26-84
	22+00		203.71										
	23+00	213.1	204.56	8.5									
	24+00	214.3	205.42	8.9									
		215.19	205.79	9.4	24+40.4 → MH tap		4" STUB SE	14662	14663	8100 E 22nd ave	8100 E 22nd St #400	9-9-85	9-9-85
LINE 1A	0+00	214.32	201.74	12.6	0+00 21+92.5 L-1								
	1+00	213.1	202.27	10.8									
	2+00												
		215.69	202.83	12.9	2+05.1								
LINE 2	0+00	210.87	195.31	15.6	0+00 9+75.7 L-1								
	1+00	210.04	196.64	13.4									
	2+00	210.1	197.97	12.1									
		209.83	198.81	11.0	2+63.3								
	3+00	210.34	199.24	11.1									
	4+00	211.62	200.42	11.2									
		211.79	200.91	10.9	4+41.8		4+75.8 TAP		20523		8100 #2300 E 22nd St		4-21-88
		211.91	201.45	10.4	4+96.8								
	5+00		201.48			5+62.8 TAP	5+89.1 TAP	25278	21468	8100 #2100 E 22nd	8100 #2200 E 22nd	5-7-90	9-12-88
	(CONT. I-277)												

Form #192-020 (July, 1981)