J 19A

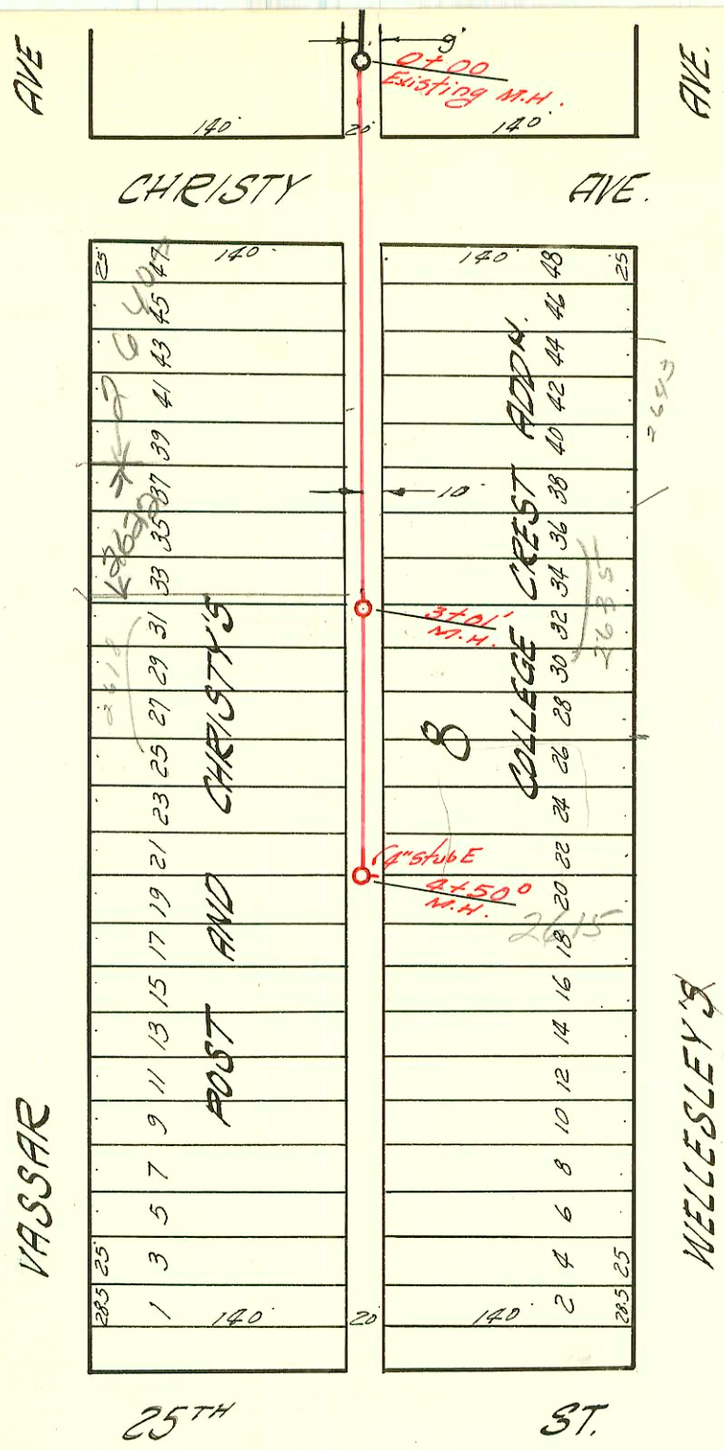

LATERAL 15 S.S. 23
PRIVATE CONTRACT
BK. NO. K-46 FEB 2, '59

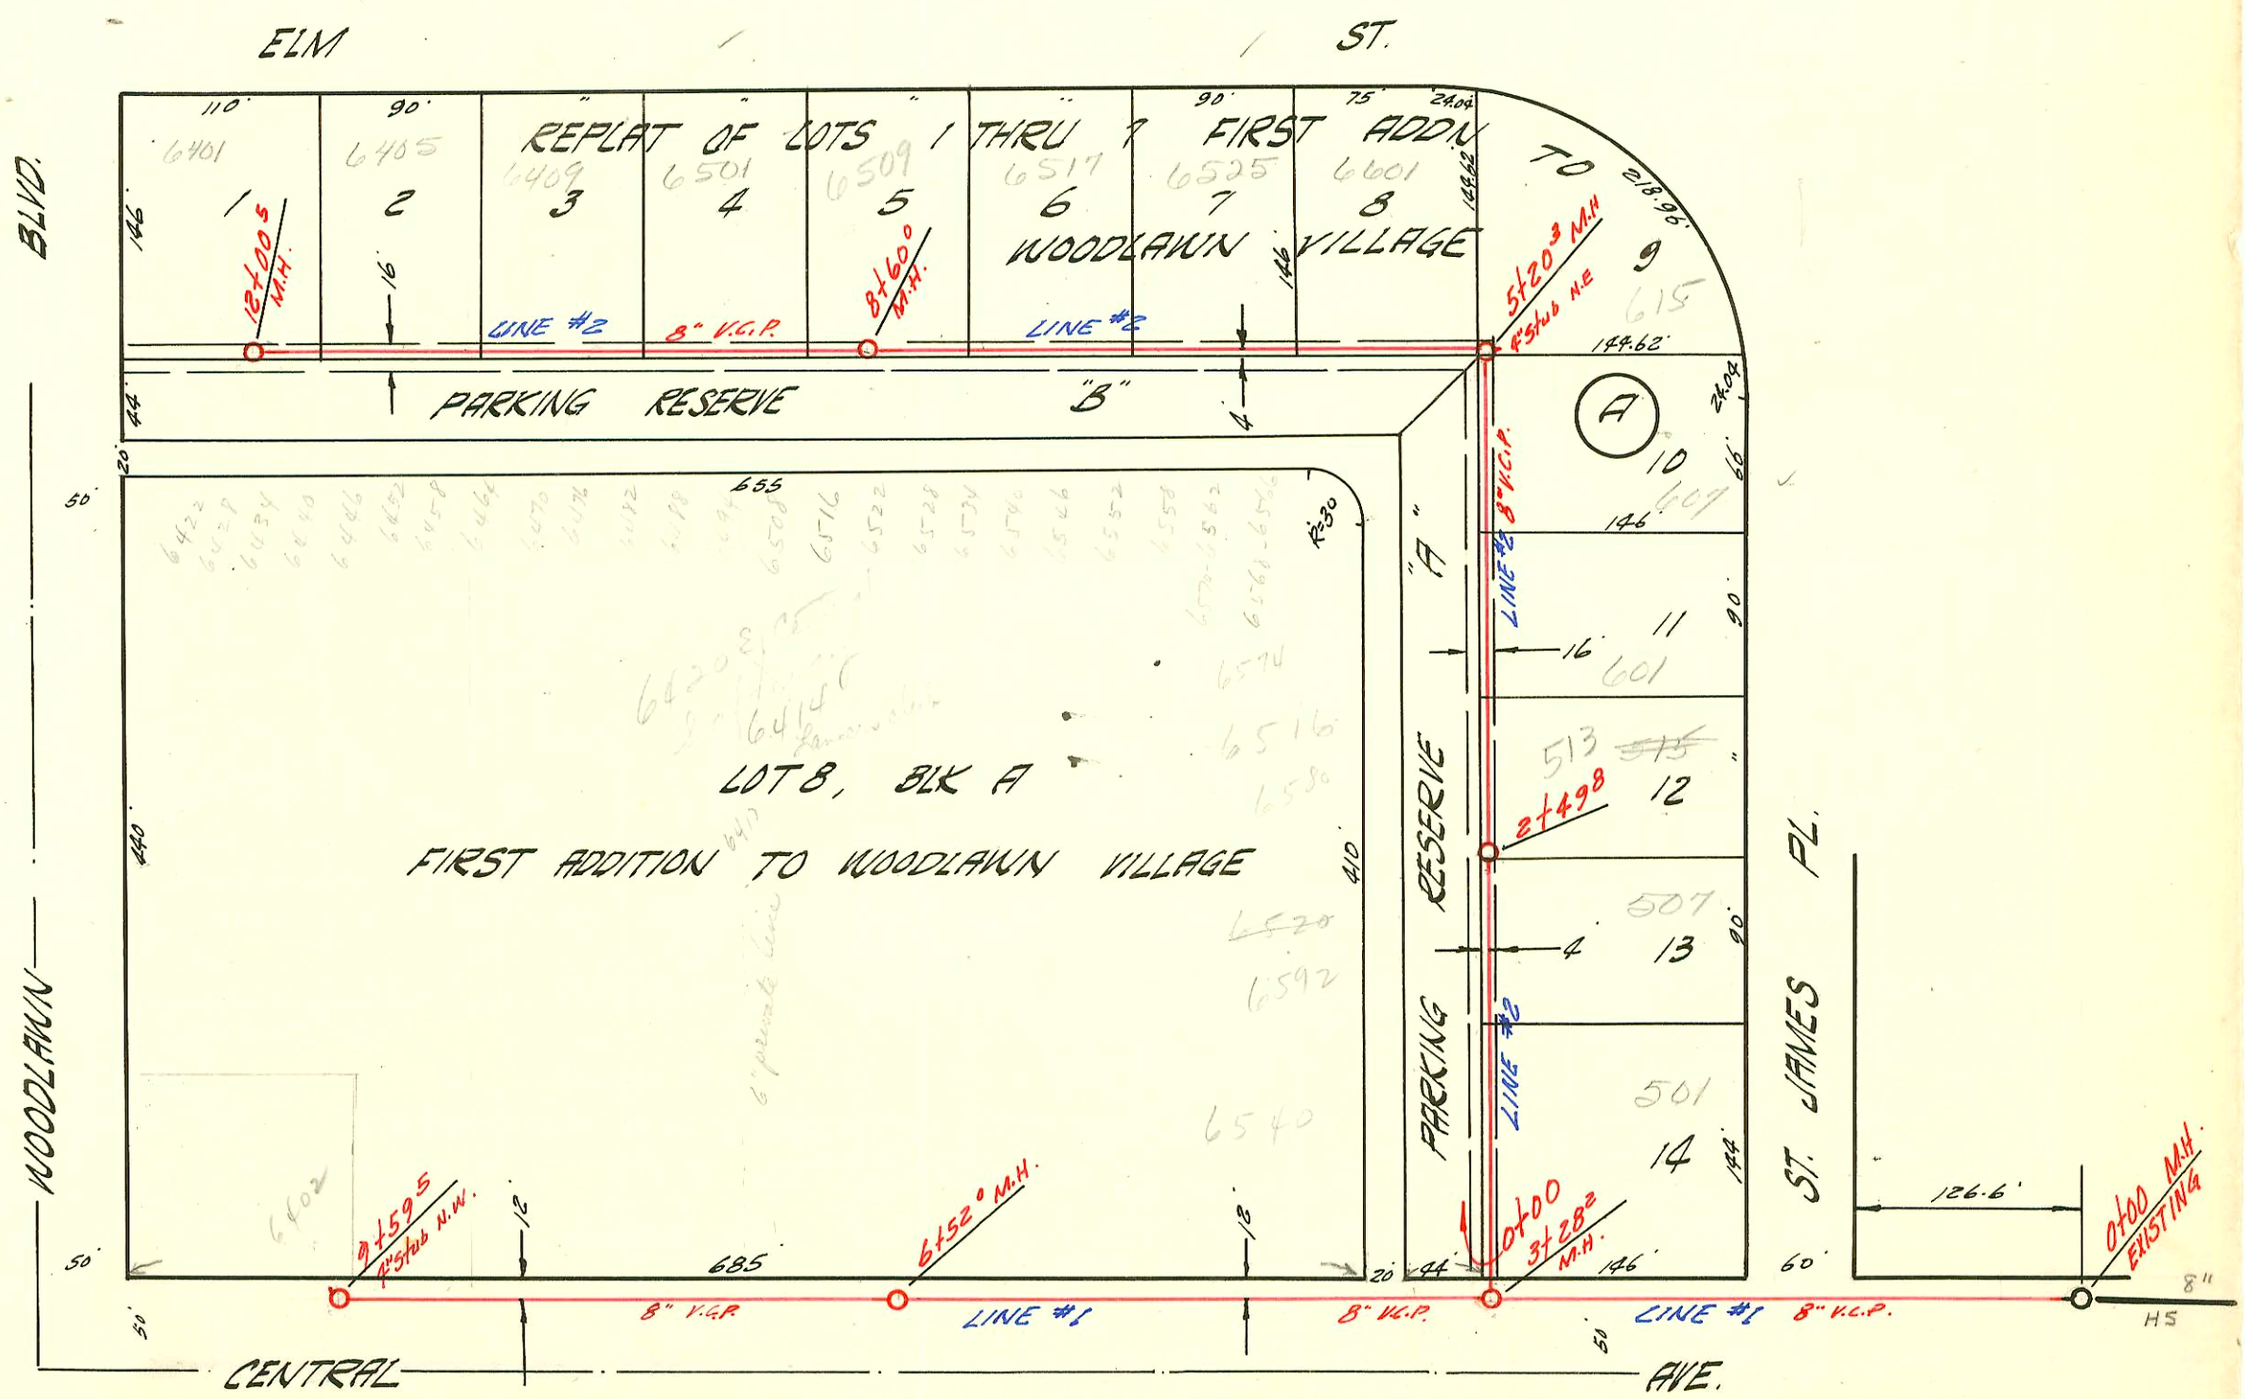

LATERAL 12 SUB. 5A W/S
UTILITY CONTRACTORS INC 2-11-59
BK. NO. K-64 PROJ. NO. C28-92

19

Form 41-(54) 6-57

CONSTRUCTION RECORD / SERVICE RECORD

STATION	ELEVATION Ground	ELEVATION Grade	Depth	MANHOLE	4-INCH "Y" BRANCHES ~~North~~ West	4-INCH "Y" BRANCHES ~~South~~ East	No. of Permit North West	No. of Permit South East	House Number North West	House Number South East	DATE OF PERMITS North West	DATE OF PERMITS South East
0+00	171.1	166.00	5.1	Existing M.H.								
1+00	175.3	168.00	7.3									
						1+53⁴						
					1+91⁴		10411		2640 Vacant		5-27-59	
2+00	179.7	170.00	9.7			2+13.0	2602 00084	6331	2622 Vacant	2643 Wellesley 2635	1-10-02	8-11-82
3+00						3+09.0		7194				11-30-82
	182.3	172.00	10.3	3+01'	3+71.7		6060		2618 N Vacant		6-25-82	
4+00	185.9	173.00	12.9		3+89.0		C 76123		2615 Wellesley	(addition)	1-15-80	
	187.0	173.50	13.5	4+50°	4" stub	8.	10412		2615 Wellesley		5-27-59	
LAT. 12 SUB SA WIS.												
LINE #1 0+00	184.0	174.00	10.0	Existing M.H.								
1+00	182.8	174.40	8.4									
2+00	185.1	174.80	10.3									
3+00	185.7	175.20	10.5									
	186.1	175.31 OUT 178.50 IN	10.8 7.3	3+28²								
4+00	186.8	179.07	7.7									
5+00	187.6	179.87	7.7									
6+00	188.4	180.67	7.7									
	188.6	181.07	7.5	6+52°								
7+00	189.0	181.47	7.5									
8+00	189.8	182.27	7.5				C67192		6 Central		7-3-78	
9+00	191.0	183.07	7.9		9+09⁵		Tap #C9341		6414 E. Central		6-28-68	mid. State
	190.4	183.56	6.8	9+59⁵	4" stub N.W.		9256		640 26 Central		2-24-59	
LINE #2 0+00	185.9	175.43	10.5	Existing M.H. 'Y' NORTH								
						1+60°		13727		St. James		6-30-65
1+00	185.3	175.81	9.5									
						1+78°		12476		St. James		4-6-60
2+00	185.5	176.21	9.3									
	185.8	176.41	9.4	2+49⁸								
						1+64²		13532		St. James		11-4-60
3+00	186.0	176.61	9.4									
						1+56°		15024		St. James		12-7-61
4+00	187.1	177.01	10.1									
						1+42³		13770		St. James		1-13-61
5+00	187.1	177.41	9.7									
	187.2	177.49 OUT 179.15 IN	9.7 8.0	5+20³	4" stub	NE.		14340		615 St. James		6-23-61
					1+52²		#15391		6601 E. Elm		4-2-62	
6+00	188.0	179.84	8.2			5+98.4		#B4278		6570 E Central		10-12-65
					1+47°	6+48.4	15106	B4277	6525 E. Elm	6552 E Central	1-17-62	10-8-65
7+00	188.8	180.64	8.2									
					1+37⁵	7+21	14172	B4276	6517 E. Elm	6546 E Central	5-10-61	10-6-65
8+00	189.6	181.44	8.2			8+00		B4275		6522 E Central		10-6-65
					1+19⁸		10452		6509 E. Elm		6-2-59	
	190.0	181.92	8.1	8+60°								
9+00	190.3	182.24	8.1									
					1+15³	9+32	14453	#B4274	6501 E. Elm	6482 E Central	7-17-61	10-6-65
10+00	191.2	183.04	8.2									
					1+06⁵	10+35.6	#14563	B4273	6409 E Elm	6452 E Central	8-14-61	10-6-65
					1+97⁵							
11+00	191.7	183.84	7.9									
					1+95²		#8891		6401 E. Elm		2-19-64	
12+00	192.5	184.64	7.9									
		184.64		12+00⁵								

C67192 - 6410 E. Central - W. Cooke - 6-30-78 - (4" tap 135' N of sidewalk on E. Central 6" private line)

B3964 tap 6494-6508 E. Central - Darnell Williams 8-13-65 tap (8+82.7) Line 2
B3965 " 6516 E. Central " " " (8+45.3) Line 2
B3966 " 6482-6488 E. Central " " "
B3967 " 6476 E. Central " " " (9+84.0) Line 2
B3968 " 6434-6440 E. Central " " " (11+21.7) Line 2
B3969 " 6422-6428 E. Central " " " (11+67.9) Line 2

10919 Tap 6420 E. Central - Caylu Kelly 7-15-59 7+58
11703 Tap 6405 E. Elm - Reynolds 10-15-59 10+76.5
#B4090 #13902 tap 6408 E. Central - Denmark Alley 2-27-61 8+90.5
Seal off Spencer Alley 9-3-65
#B2914 tap 6540 E. Central - Darnell Williams - 3-5-65 tap (1+94) line #2
#B2915 tap 6520 E. Central - Darnell Williams - 3-5-65 tap (1+04.8) line #2
#B2914 tap 6516 E. Central - Darnell Williams - 3-5-65 tap (0+79.8) line #2