28A

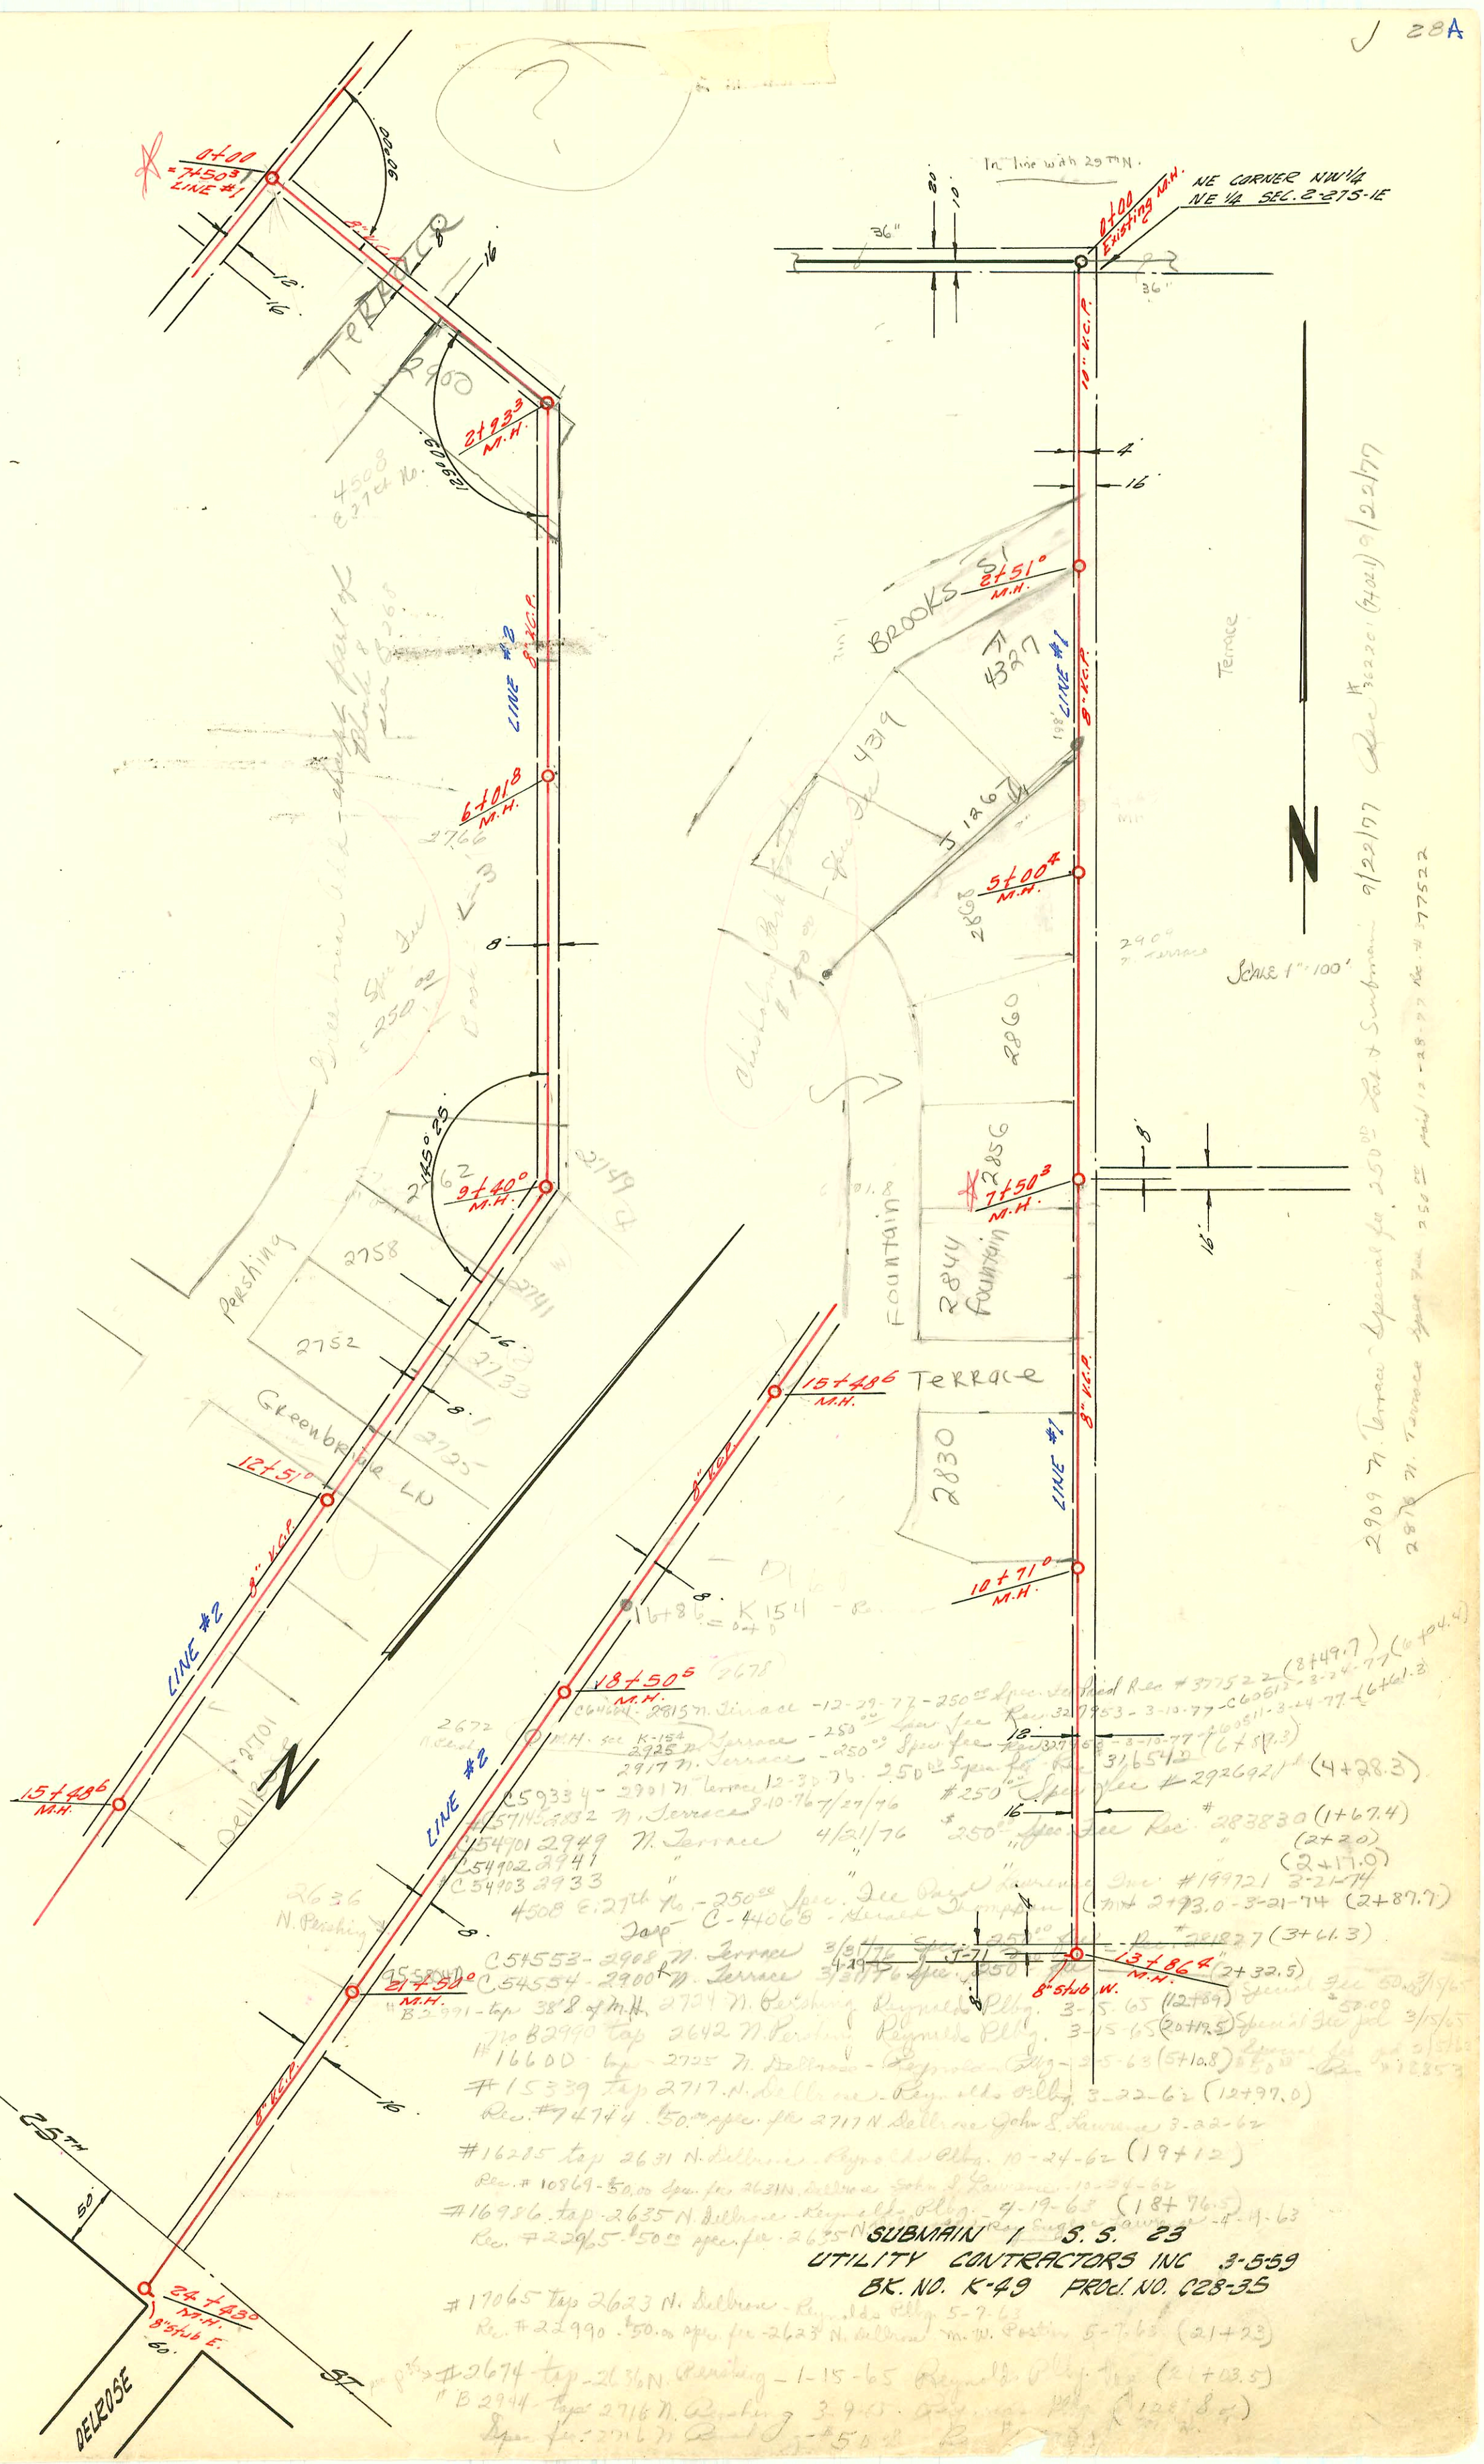
0+00 = 7+50³ LINE #1
In line with 29TH N.
NE CORNER NW¼ NE¼ SEC. 2-27S-1E
0+00 Existing M.H.
10" V.C.P.
2+933 M.H.
2+51° M.H.
5+00⁴ M.H.
7+50³ M.H.
6+01⁸ M.H.
9+40° M.H.
12+51°
15+48⁶ M.H.
18+50⁵ M.H.
21+50° M.H.
24+43° M.H.
8" V.C.P.
LINE #1
LINE #2
BROOKS ST
Fountain Terrace
Pershing
Greenbriar Ln
DELLROSE
25TH ST
N
Scale 1" = 100'
SUBMAIN 1 S.S. 23
UTILITY CONTRACTORS INC 3-5-59
BK. NO. K-49 PROJ. NO. C28-35

28

Form 41-(54) 6-57

	CONSTRUCTION RECORD							SERVICE RECORD					
	STATION	ELEVATION		Depth	MANHOLE	4-INCH "Y" BRANCHES		No. of Permit		House Number		DATE OF PERMITS	
		Ground	Grade			North West	South East	North West	South East	North West	South East	North West	South East
LINE #1	0+00	152.1	140.47	11.6	Existing M.H.								
	1+00	150.0	140.87	9.1									
	2+00	148.5	141.29	7.2									
		153.8	141.47	12.3	2+51°	8" V.C.P.							
	3+00	155.5	143.25	12.2									
	4+00	156.0	144.15	11.8									
	5+00	155.0	145.05	9.9	5+00⁴								
	6+00	154.6	145.95	8.6									
	7+00	156.2	146.85	9.3									
		156.2	147.30	8.9	7+50³			c63234		2909 N. Terrace		9-26-77	
	8+00	156.0	147.50	8.5									
	9+00	156.4	147.90	8.5									
	10+00	156.9	148.30	8.6									
		157.7	148.58	9.1	10+71°								
	11+00	157.4	148.70	8.7									
	12+00	158.2	149.10	9.1									
	13+00	158.6	149.50	9.1									
		159.4	149.85 149.41	9.5	13+86⁴	8" Stub W. FO 149.95							
LINE #2													
	0+00	156.1	147.36	8.7									
	1+00	155.3	148.01	7.3									
	2+00	156.3	148.65	7.6									
		156.0	149.16 OUT 149.26 IN	6.8 6.7	2+93³								
	3+00	155.7	149.31	6.4									
	4+00	155.8	149.91	5.9									
	5+00	156.6	150.51	6.1									
	6+00												
		157.4	151.11	6.3	6+01⁸								
	7+00	158.0	151.71	6.3									
	8+00	158.8	152.31	6.5									
	9+00	160.1	152.91	7.2									
		160.6	OUT 153.13 IN 153.23	7.5 7.4	9+40°								
	10+00	161.5	153.61	7.9									
	11+00	162.4	154.21	8.2									
	12+00	163.9	154.81	9.1									
		164.5	155.11	9.4	12+51°								
	13+00	164.4	155.41	9.0									
	14+00	165.4	156.01	9.4									
	15+00	163.4	156.61	6.8				2003		2701 Dellrose		7-3-03	
		165.8	156.91	8.9	15+48⁶								
	16+00	166.1	157.21	8.9									
	17+00	166.6	157.81	8.8									
	18+00	167.7	158.41	9.3									
		169.3	158.71	10.6	18+50⁵								
	19+00	169.6	159.01	10.6									
	20+00	170.0	159.61	10.4									
	21+00	171.7	160.21	11.5									
		173.0	160.51	12.5	21+50°								
	22+00	174.0	160.81	13.2									
	23+00	171.4	161.41	10.0									
	24+00	171.8	162.01	9.8									
		172.0	162.40	9.6	24+43°	8" Stub E.							

Top) C42069 - 4516 E. 27th - 11-6-73 Gerald Thompson (3+65.3) - 72 ft S. of 2+93.3
Special Fee #159906 - 4516 E. 27th - $250.00 - Lawrence, Inc 11-5-73
C40449 - 2770 N. Pershing - Gerald Thompson (5+44.4) top Rec 171196 250.00 Spec fee 8-6-73
C14887 - 2766 N. Pershing - Reynolds Alby 7-10-69 (8+48) Rec 36781 $250.00 Spec fee 7-10-69
C14886 - 2758 N. Pershing - Reynolds Alby 7-10-69 top (10+52.3) Rec. 36781 - 250.00 Spec fee 7-10-69
#C14117 - 2762 N. Pershing - Reynolds Alby. - 5-15-69 top (9+70) Rec. #35119 #250.00 Spec. fee paid. 5-15-69 (2762 N. Pershing)
C11989 - 2752 N. Pershing - Reynolds Alby 12-17-68 - top (11+28.4) Spec fee 250.00 Re-Rec 25453
#5950 - 2672 N. Pershing - Reynolds Alby. 7-5-66 top (18+30.7) Spec. fee $50.00 Rec. #97333 Refunded 7-13-66 See Bk K-154
#B5865 - 2660 N. Pershing - Reynolds Alby. 6-21-66 top (17+48.9) Spec. fee $50.00 Rec. #97304
#B5864 - 2678 N. Pershing - Reynolds Alby. - 6-21-66 top (17+18.5) Spec fee $50.00 - Rec. #97303
#5430 - 2654 N. Pershing - Reynolds Alby Co. - 4-12-66 top (18+77.2) Spec. Fee 50.00 Rec. 89321
#B3846 - 2648 N. Pershing - Joe's Lawn Service - 7-23-65 top (95.8' N. of M.H.) Spec fee 50.00 Rec 74971
B3491 - 2708 N. Pershing - Reynolds Alby - 5-25-65 - top (41' N. of M.H.) Spec fee 50.00 Rec 66628
B3490 - 2700 N. Pershing - Reynolds Alby - 5-25-65 - top (118.5' N. of M.H.) Spec fee 50.00 Rec 66628
#17076 - 2733 N. Dellrose - Reynolds Alby - 5-8-63 - Top (15+25.6) Spec fee 50.00 Rec 22998
#17077 - 2709 N. Dellrose - Reynolds Alby - 5-8-63 - Top (16+59.6) Spec fee 50.00 Rec 22999
#17078 - 2651 N. Dellrose - Reynolds Alby - 5-8-63 top (17+27.5) Spec fee 50.00 Rec 23000
#17079 - 2627 N. Dellrose - Reynolds Alby 5-8-63 top (20+89) Spec fee 50.00 Rec 24851
Rec. #48031 25.00 Lat. fee paid 2844 N. Fountain - J. Charles Smith 9-16-60
13520 Top Robert Jost 2844 N. Fountain 11-1-60 (0+10) (241' N. of M.H. South of 2844)
Rec. #57354 $150.00 Spec. fee for 2643, 2667 + 2701 N. Dellrose - Roy Eugene Lawrence 3-15-61
#13973 top - 2643 N. Dellrose - Reynolds Alby 3-15-61 (18+31.5) - Reynolds Alby. - Spec fee 50.00 3-15-61 Rec 57354
#13974 Top - 2667 N. Dellrose " " " (15+46.5) " " " " " " "
R94 #13975 Top - 2701 N. Dellrose " " " (14+52.5) " " " " " " "
#14851 Top 2675 N. Dellrose Jet Alby 10-19-61 (16+75.6) Alby Spec. fee 50.00 2675 N. Dellrose 10-19-61 Rec. 65857
15285 Top - 2651 N. Dellrose - Reynolds Alby - 2-26-62 ( ) Reynolds Alby Spec fee 50.00 - 2-26-62 Rec. 74766
#15682 Top - 2711 N. Dellrose - Jerome L. Alby - 5-28-62 (9+87) Spec fee 50.00 - 5-28-62 Rec. #3492
C56711 - Top 2867 N. [illegible] (4+55.0) Rec. 8876.00 7-14-76 Spec fee 100.00 - Rd. Rec. 290743 7-14-76