35A

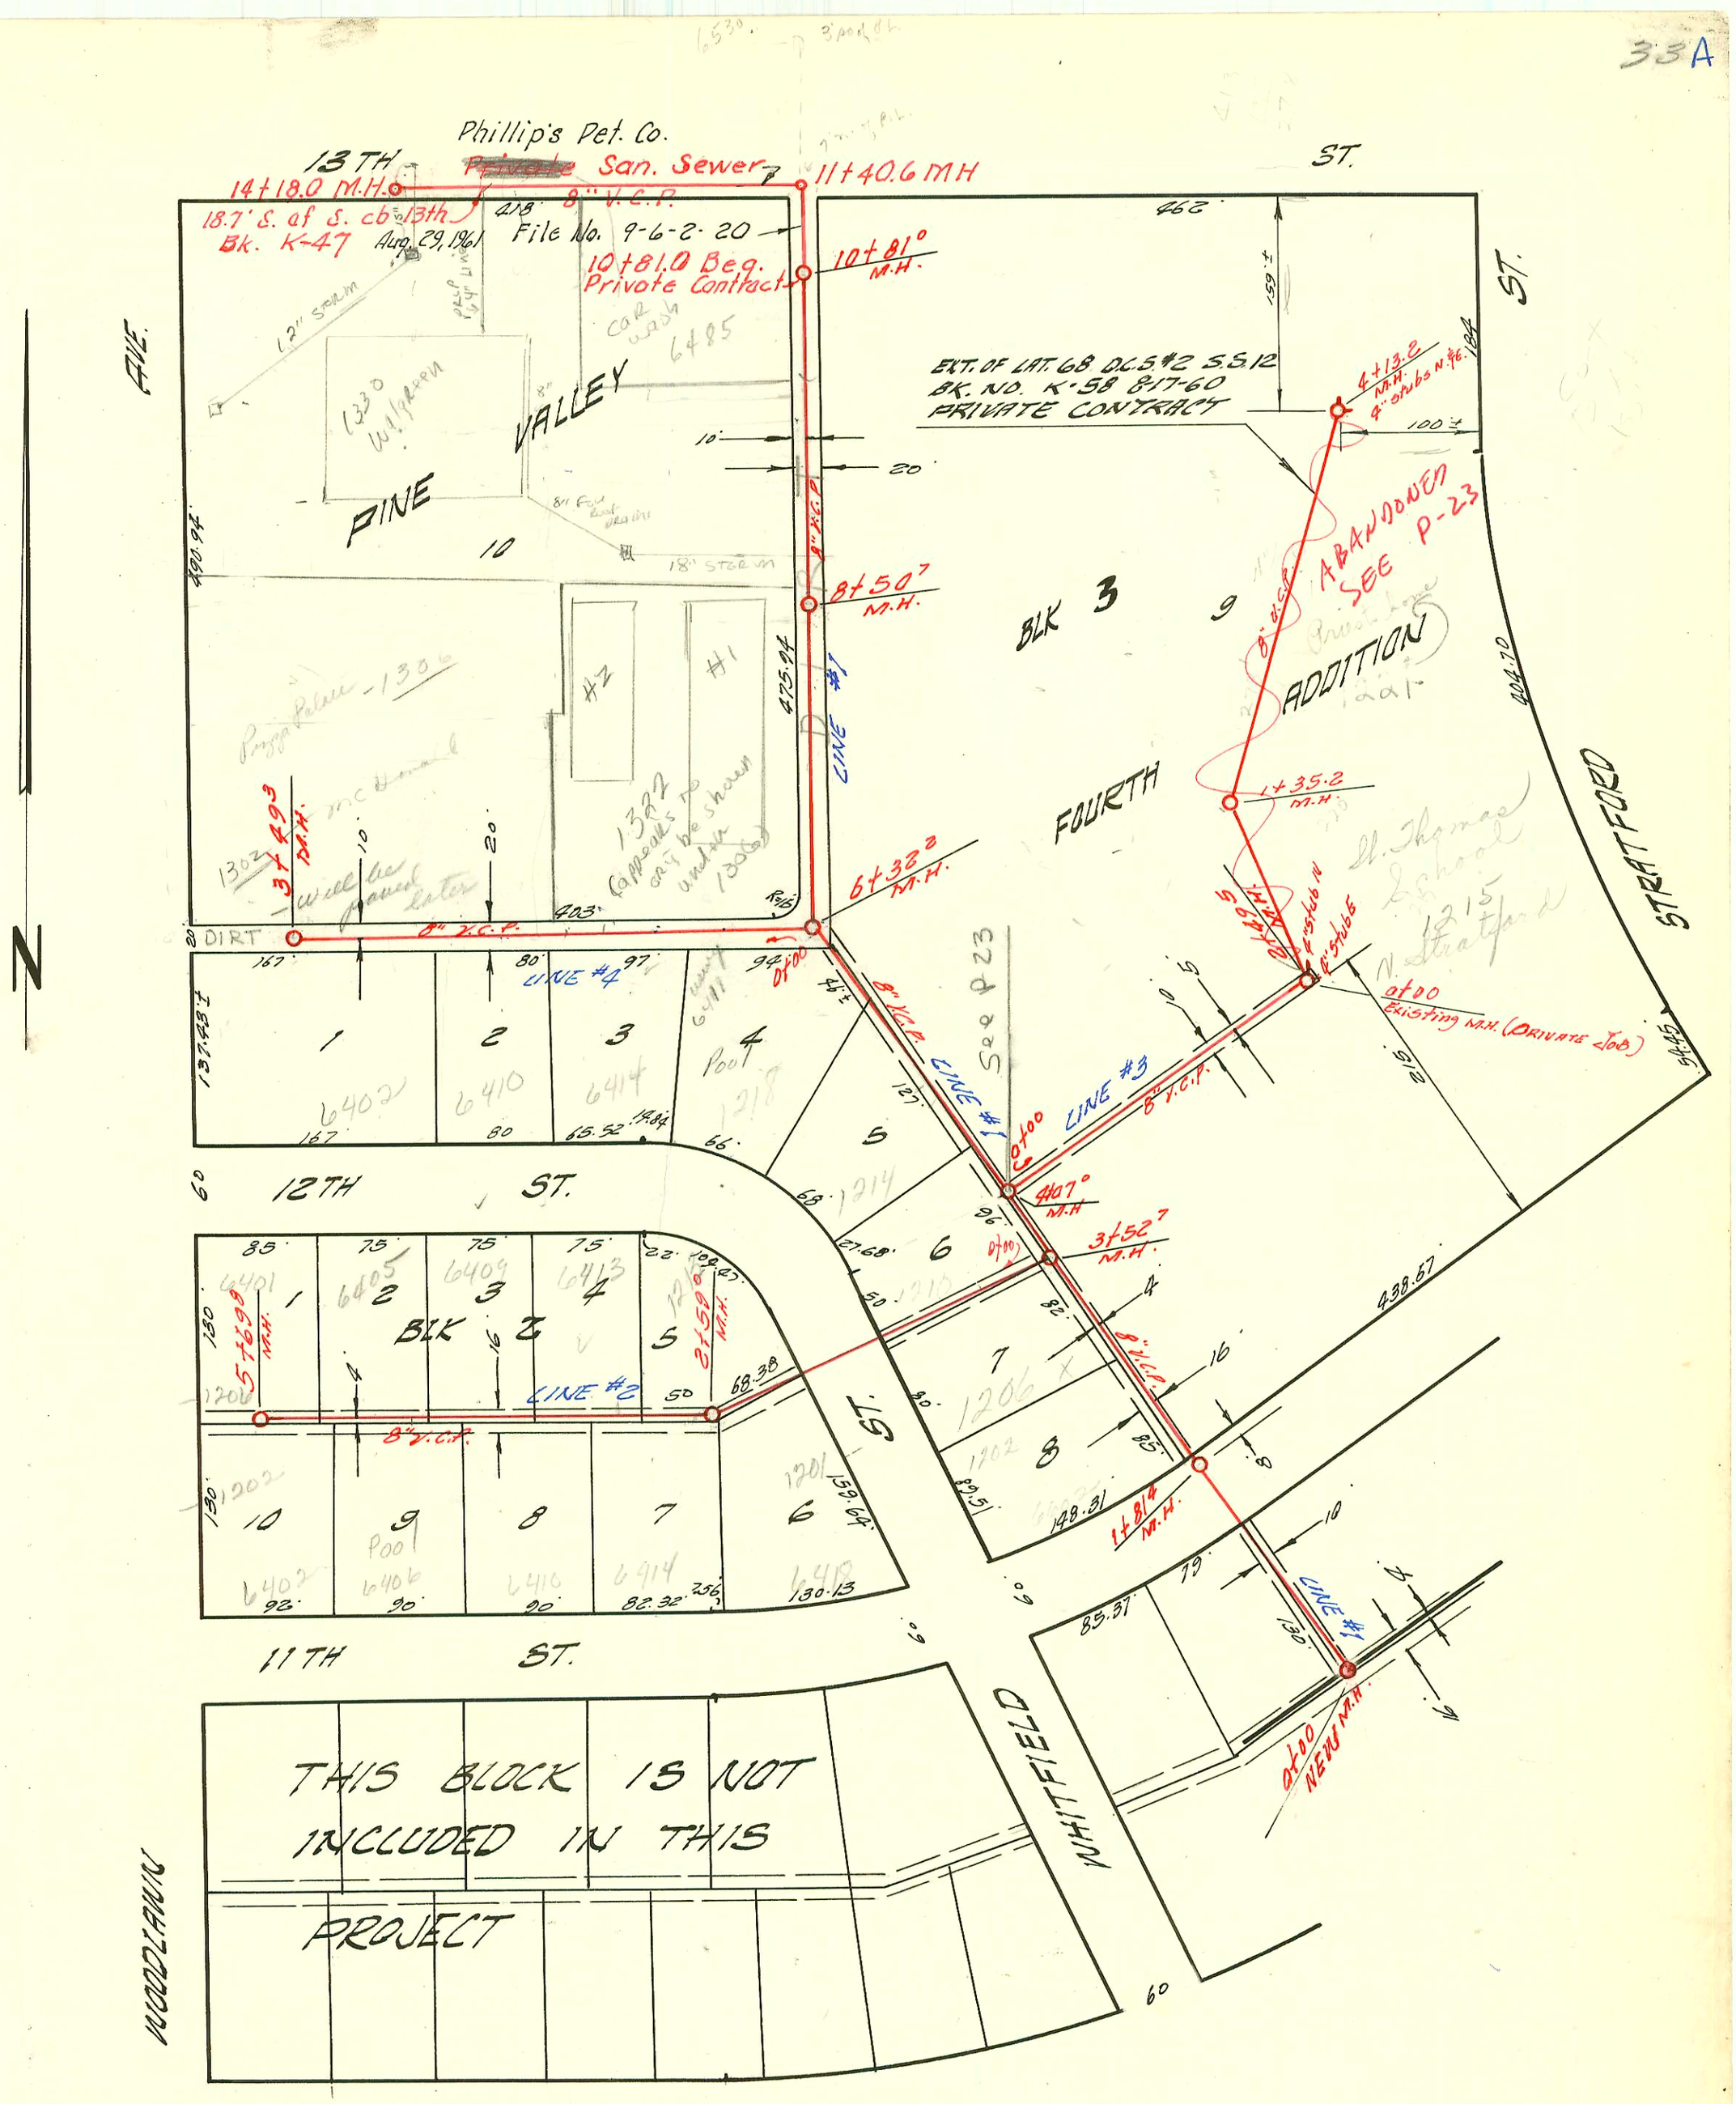

#13090 - 4" Stub (1221 Stratford) - Gaulding Plbg. 7-18-60 (6074) Roger Weidman 6-30-82

97G982390070I 11-10-97 6485 E 13th N/C - Smith Callahan Plbg - (NO INSP TURNED IN BR 6-26-00)

LATERAL 68 DCS #2 S.S. 12
W. B. CARTER CONSTR. 3-11-59
BK. NO. K-47 PROJ. NO C 28-119

SWR 2000-01890 8/24/00 1330 N Woodlawn - N/C - TRI State Plbg - (Walgreen) 4" SCH 40, Predco, 192' W. of MH 11+40.6 (13+32.6) ITWID CO, IV45

SWR

33

Form 41-(54) 6-57

CONSTRUCTION RECORD / SERVICE RECORD

	STATION	ELEVATION Ground	ELEVATION Grade	Depth	MANHOLE	4-INCH "Y" BRANCHES ~~North~~ West	4-INCH "Y" BRANCHES ~~South~~ East	No. of Permit North West	No. of Permit South East	House Number North West	House Number South East	DATE OF PERMITS North West	DATE OF PERMITS South East
LINE #1	0+00	188.6	179.54	9.1	Existing M.H.								
	1+00	189.0	179.74	9.3									
		188.4	179.90	8.5	1+81⁴								
	2+00	188.3	179.94	8.4									
						4+02⁴		10794		1202 Whitfield		7-7-59	
						4+89⁵		9595		1206 Whitfield		3-13-59	
	3+00	189.7	180.14	9.6									
		190.6	180.24	10.4	3+52⁷								
						4+77⁸		10675		1210 Whitfield		6-22-59	
	4+00	190.9	180.34	10.6									
		191.1	180.35 OUT / 180.50 IN	10.7 / 10.6	4+07⁰								
						4+99⁰		11417		1214 Whitfield		9-11-59	
	5+00	191.7	182.06	9.6									
						4+98⁵		13118		1218 Whitfield		8-19-60	
	6+00	192.1	182.66	9.4									
		192.1	182.85	9.2	6+32² 4" clay to 4" P.V.C			93-29735-7		R		11-23-93	
	7+00	190.1	183.26	6.8	top 7+95.7			C50134 / C36542		7306 Woodlawn		7-1-75 / 12-28-72	
	8+00	191.9	183.86	8.0	Zap 7+55.2			C51906		1306 N #1 Woodlawn		10-16-75	
		193.0	184.16	8.8	8+50⁷								
	9+00	193.7	185.46	8.2		9+76⁷	S/O	top C23823		1300 N, Woodlawn		6-9-00 / 4-19-71	
	10+00	194.6	186.06	8.5		10+21²		top C32714		1304 N.		1-26-71	see next page
		194.4	186.54	7.9	10+81⁰								
LINE #2	0+00	190.5	180.27	10.2	Existing M.H. "Y" NO.	"Y" SO.							
	1+00	190.8	181.54	9.3									
	2+00	192.3	182.74	9.6									
						4+35²	4+05⁰		11016		6418 E. 11th		7-28-59
		192.8	183.45	9.3	2+59⁰								
							4+80³		13381				10-12-0
	3+00	193.3	183.94	9.4									
						4+25²		12760		6413 E. 12th		5-12-60	
							4+61⁰		9752		6410 E. 11th		3-20-59
	4+00	195.3	185.19	10.2									
						4+05⁰		9879		6409 E. 12th		4-2-59	
							4+51²						
						4+79²	4+63.8	9594	11285 / 13845	6405 E. 12th	6406 E. 11th	3-12-59	6-27-69 / 8-24-59
	5+00	196.6	186.34	10.3									
						4+45²	4+47²		10608		6402 E. 11th		6-12-59
						4+57⁵		9780		6401 E. 12th		3-24-59	
		197.6	187.18	10.4	5+69⁸								
LINE #3	0+00	190.9	180.46	10.4	Existing M.H.								
	1+00	190.4	180.65	9.7									
	2+00												
		189.2	180.95	8.2	2+49⁵	4" stub N		#10550		1215 Stratford		6-3-59	
						6" stub E		#10551		1215 Stratford		6-3-59	
LINE #4	0+00	192.01	183.42	8.6	Existing M.H.		4+28.5		6418 E. 12th		7-30-80		
	1+00	193.5	184.90	8.6									
						top 1+45 4+18² (6" Y)	4+20²	C51907	13686	1306 N #2 Woodlawn	6414 E. 12th	10-16-75	12-15-60
	2+00	195.2	186.30	8.9		Vertical per Bill 9-23-60 1+66		C50135		1306 N Woodlawn	Walgreens	7-1-75	
						2+20⁰ (6" P)	4+22⁰		13433		6410 E. 12th		10-6-60
	3+00	196.7	187.70	9.0		top 3+40.9		C35276		1302 N. Woodlawn		10-10-72	
							4+12⁰		11384		6403 E. 12th		9-3-59
		197.2	188.40	8.8	3+49³								
EXT. OF LAT. 68 D.C.S. #2 S.S. 12													
	0+00	190.6	180.95	9.6	Existing M.H.								
	1+00	192.5	181.15	11.3									
		192.0	181.22 OUT / 181.32 IN	10.8 / 10.7	1+35.2								
	2+00	190.9	181.45	9.7									
	3+00	190.6	181.65	8.9									
	4+00	192.8	181.85	10.9									
		192.7	181.88	10.8	4+13.2	4" stub N & E							
PHILLIPS PET. Co. PRIVATE CONTRACT S.S.													
		194.8	186.05	8.7	Existing MH 10+81⁰								
	11+00	195.0											
		195.2	186.65 out / 186.75 in	8.5 / 8.4	11+40.6								
	12+00	196.0	187.33	8.7									
	13+00	197.2	188.34	8.9									
	14+00	198.0	189.34	8.7									
		198.2	189.53	8.7	14+18.0								

NOTE: Elev. shown are not on City datum.

6886-1221 Stratford 10-29-82 - Rogers Weidman Used Existing Stub E.

96-5245-7 4-16-96 1302 N Woodlawn - Playland add - N/C

6-8-00 S/O w/concrete at MH

Top C77235 - 6425 East 13th - 9-11-79 (M.H. Tap into 14+18.0) 97-19839-7 11-10-97 6485 E. 13th - N/C

Top C38058 - 6435 E. 13th - Hank Hoover - 6-8-00 - 4-4-73 (13+17) (13+78) S/O

Top C77425 - 6425 E. 13th St. - Doug Griffin - 5-2-79 - 5-22-70 (13+70.4)

6-8-00 S/O

6405 E. 13th - 9-5-74 - Cal Robertson Bldg. → AKA 1360, 1356 & 1358 N Woodlawn → sealed w/concrete at MH

Top 1213 Stratford - Kenneth - 9-2-59 2+64'