


LATERAL 24 SUB. 3 S.S. 22
 MID-STATES CONSTR. CO. 3-24-59
 BK. NO. K-68 PROJ. NO. C28-22

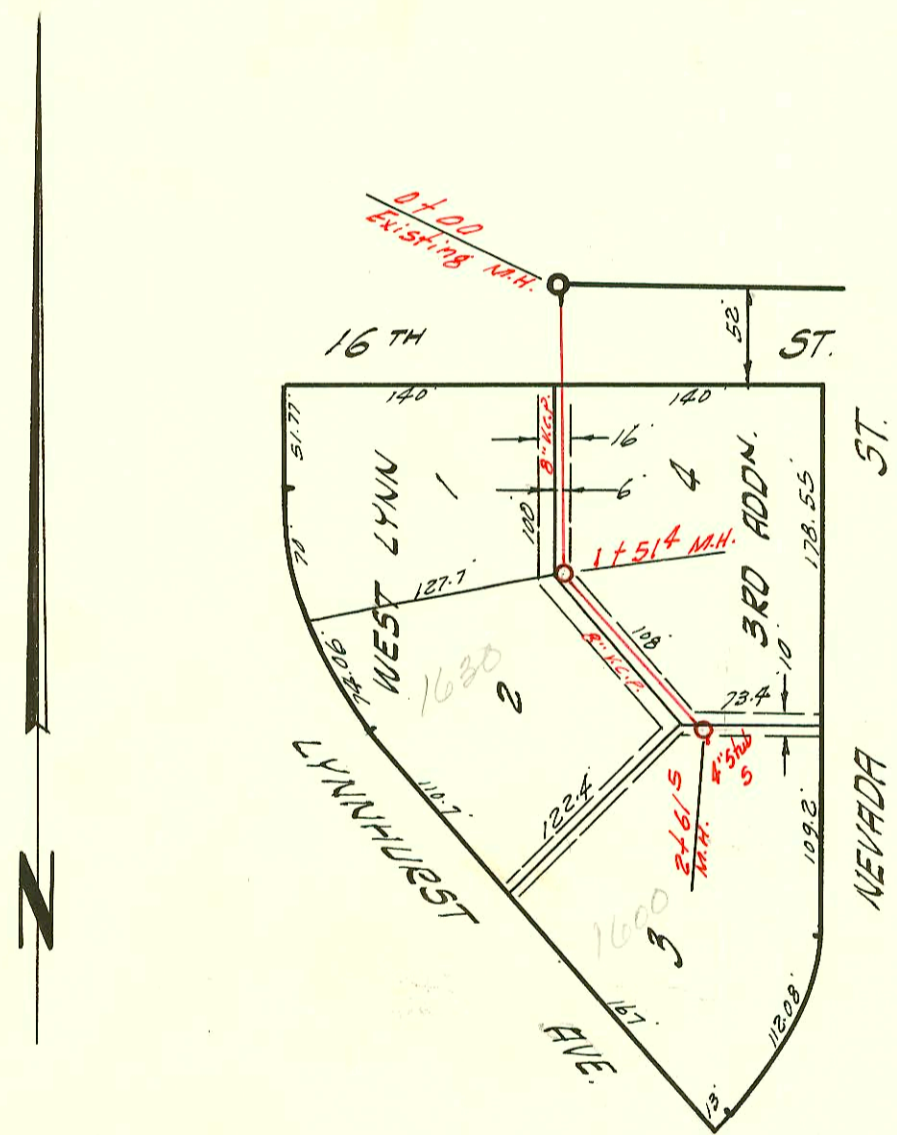


LATERAL 70 SUB. 5 S.S. 22
 MID-STATES CONSTR. CO. 3-24-59
 BK. NO. K-45A PROJ. NO. C28-77

Neighborhood Revitalization Area

LATERAL 87 SUB. 5 S.S. 22
 W.B. CARTER CONSTR. CO. 3-24-59
 BK. NO. K-44 PROJ. NO. C28-111

County Carrier as S35
 This is out of number of ORCHARD BK. #22105

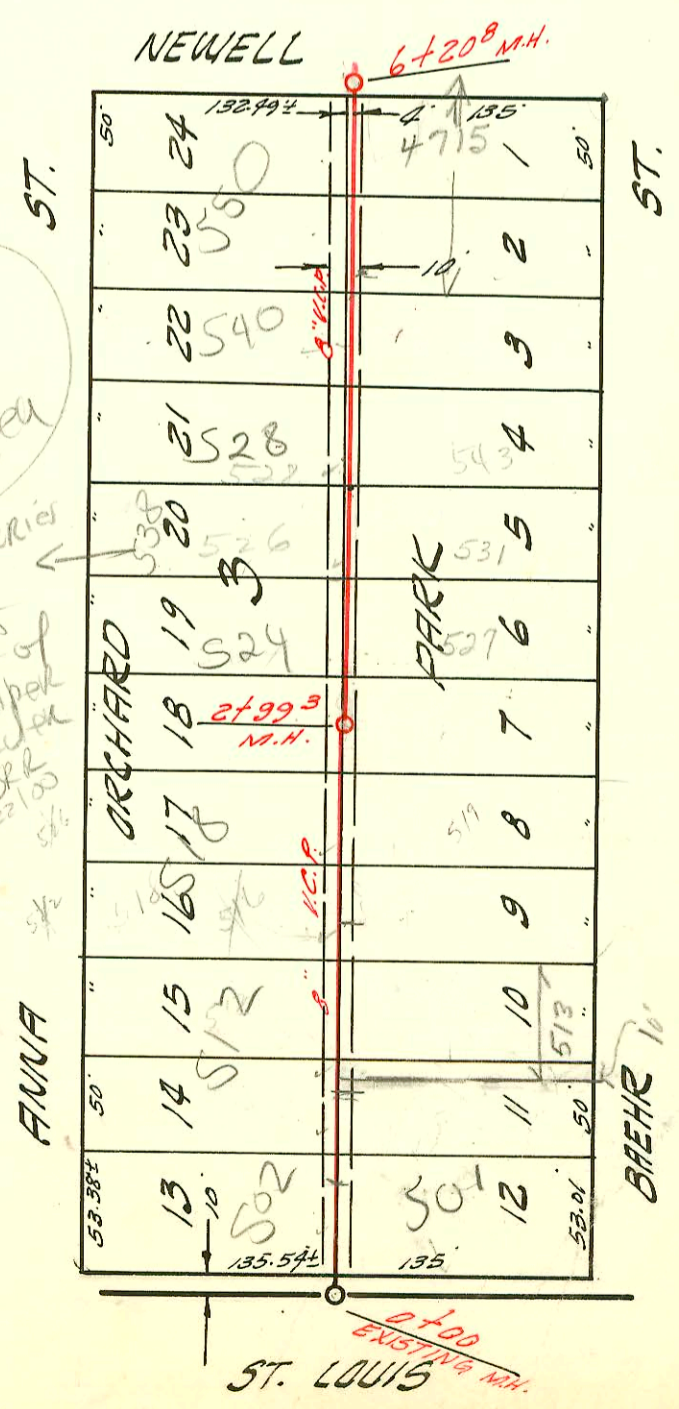

CONSTRUCTION RECORD

SERVICE RECORD

STATION	ELEVATION		Depth	MANHOLE	4-INCH "Y" BRANCHES		No. of Permit		House Number		DATE OF PERMITS	
	Ground	Grade			North West	South East	North West	South East	North West	South East	North West	South East
0+00	101.13	94.30	6.8	Existing MH.								
LAT. 87 SUB. 5	103.2	96.16	7.0	9+28°								
0+00	127.8	119.72	8.0	Existing MH.	Y WEST	Y EAST						
1+00	128.7	120.12	8.6		+86°							
2+00	128.9	120.32	8.6	1+514	+21°		11805		1660 P Kynhurst		11-3-59	
3+00	128.6	120.77	7.8	8+615	+435		11804		1661 Kynhurst			11-3-59
4+00	120.2	111.85	8.3	Existing MH.	+653		9846		1680 Kynhurst		3-31-59	
5+00	120.6	112.25	8.3		+877							
6+00	120.7	112.65	8.0		+31°		9847		1600 Kynhurst		3-31-59	
7+00	120.2	111.85	8.3	Existing MH.	4" stub 50.							
8+00	120.6	112.25	8.3		+30°(1)		181867		5027 Kynhurst		8-31-64	
9+00	120.7	112.65	8.0		+79°		184640		5017 Kynhurst		11-24-65	
0+00	120.2	111.85	8.3	Existing MH.	+005	+025	9806		512 N. Anna		3-27-59	
1+00	120.6	112.25	8.3		+698		10090		516 N. Anna	513 Baehr	4-27-59	101901
2+00	120.7	112.65	8.0		+975	+917	20344		518 N. Anna		8-4-70	
3+00	121.1	113.05	8.0	2+993	+264	+365						
4+00	120.8	113.45	7.3		+846	+826	15358		519 N. R Baehr		3-26-62	
5+00	121.6	113.85	7.7		+18°							
6+00	121.9	114.25	7.6		3+363		14602		524 N. Anna	527 N. Baehr	8-25-61	11-18-75
7+00	121.6	114.33	7.3	6+208	3+725	+705	14096		526 N. Anna	531 N. Baehr	4-21-61	11-13-62
8+00	121.6	114.33	7.3	6+208	4+203	+183	10992		528 N. Anna	543 N. Baehr	7-24-59	5-24-61
9+00	121.6	114.33	7.3	6+208	+812	+792	25451		540 N. Anna		7-13-71	
0+00	121.6	113.85	7.7		5+354		15326		550 N. R Anna		7-13-71	3-20-62
1+00	121.9	114.25	7.6		3+453							

99-4920-7 3-15-99 555 N Baehr - NIC - Morris Dixhous -
 4-19-99 2795
