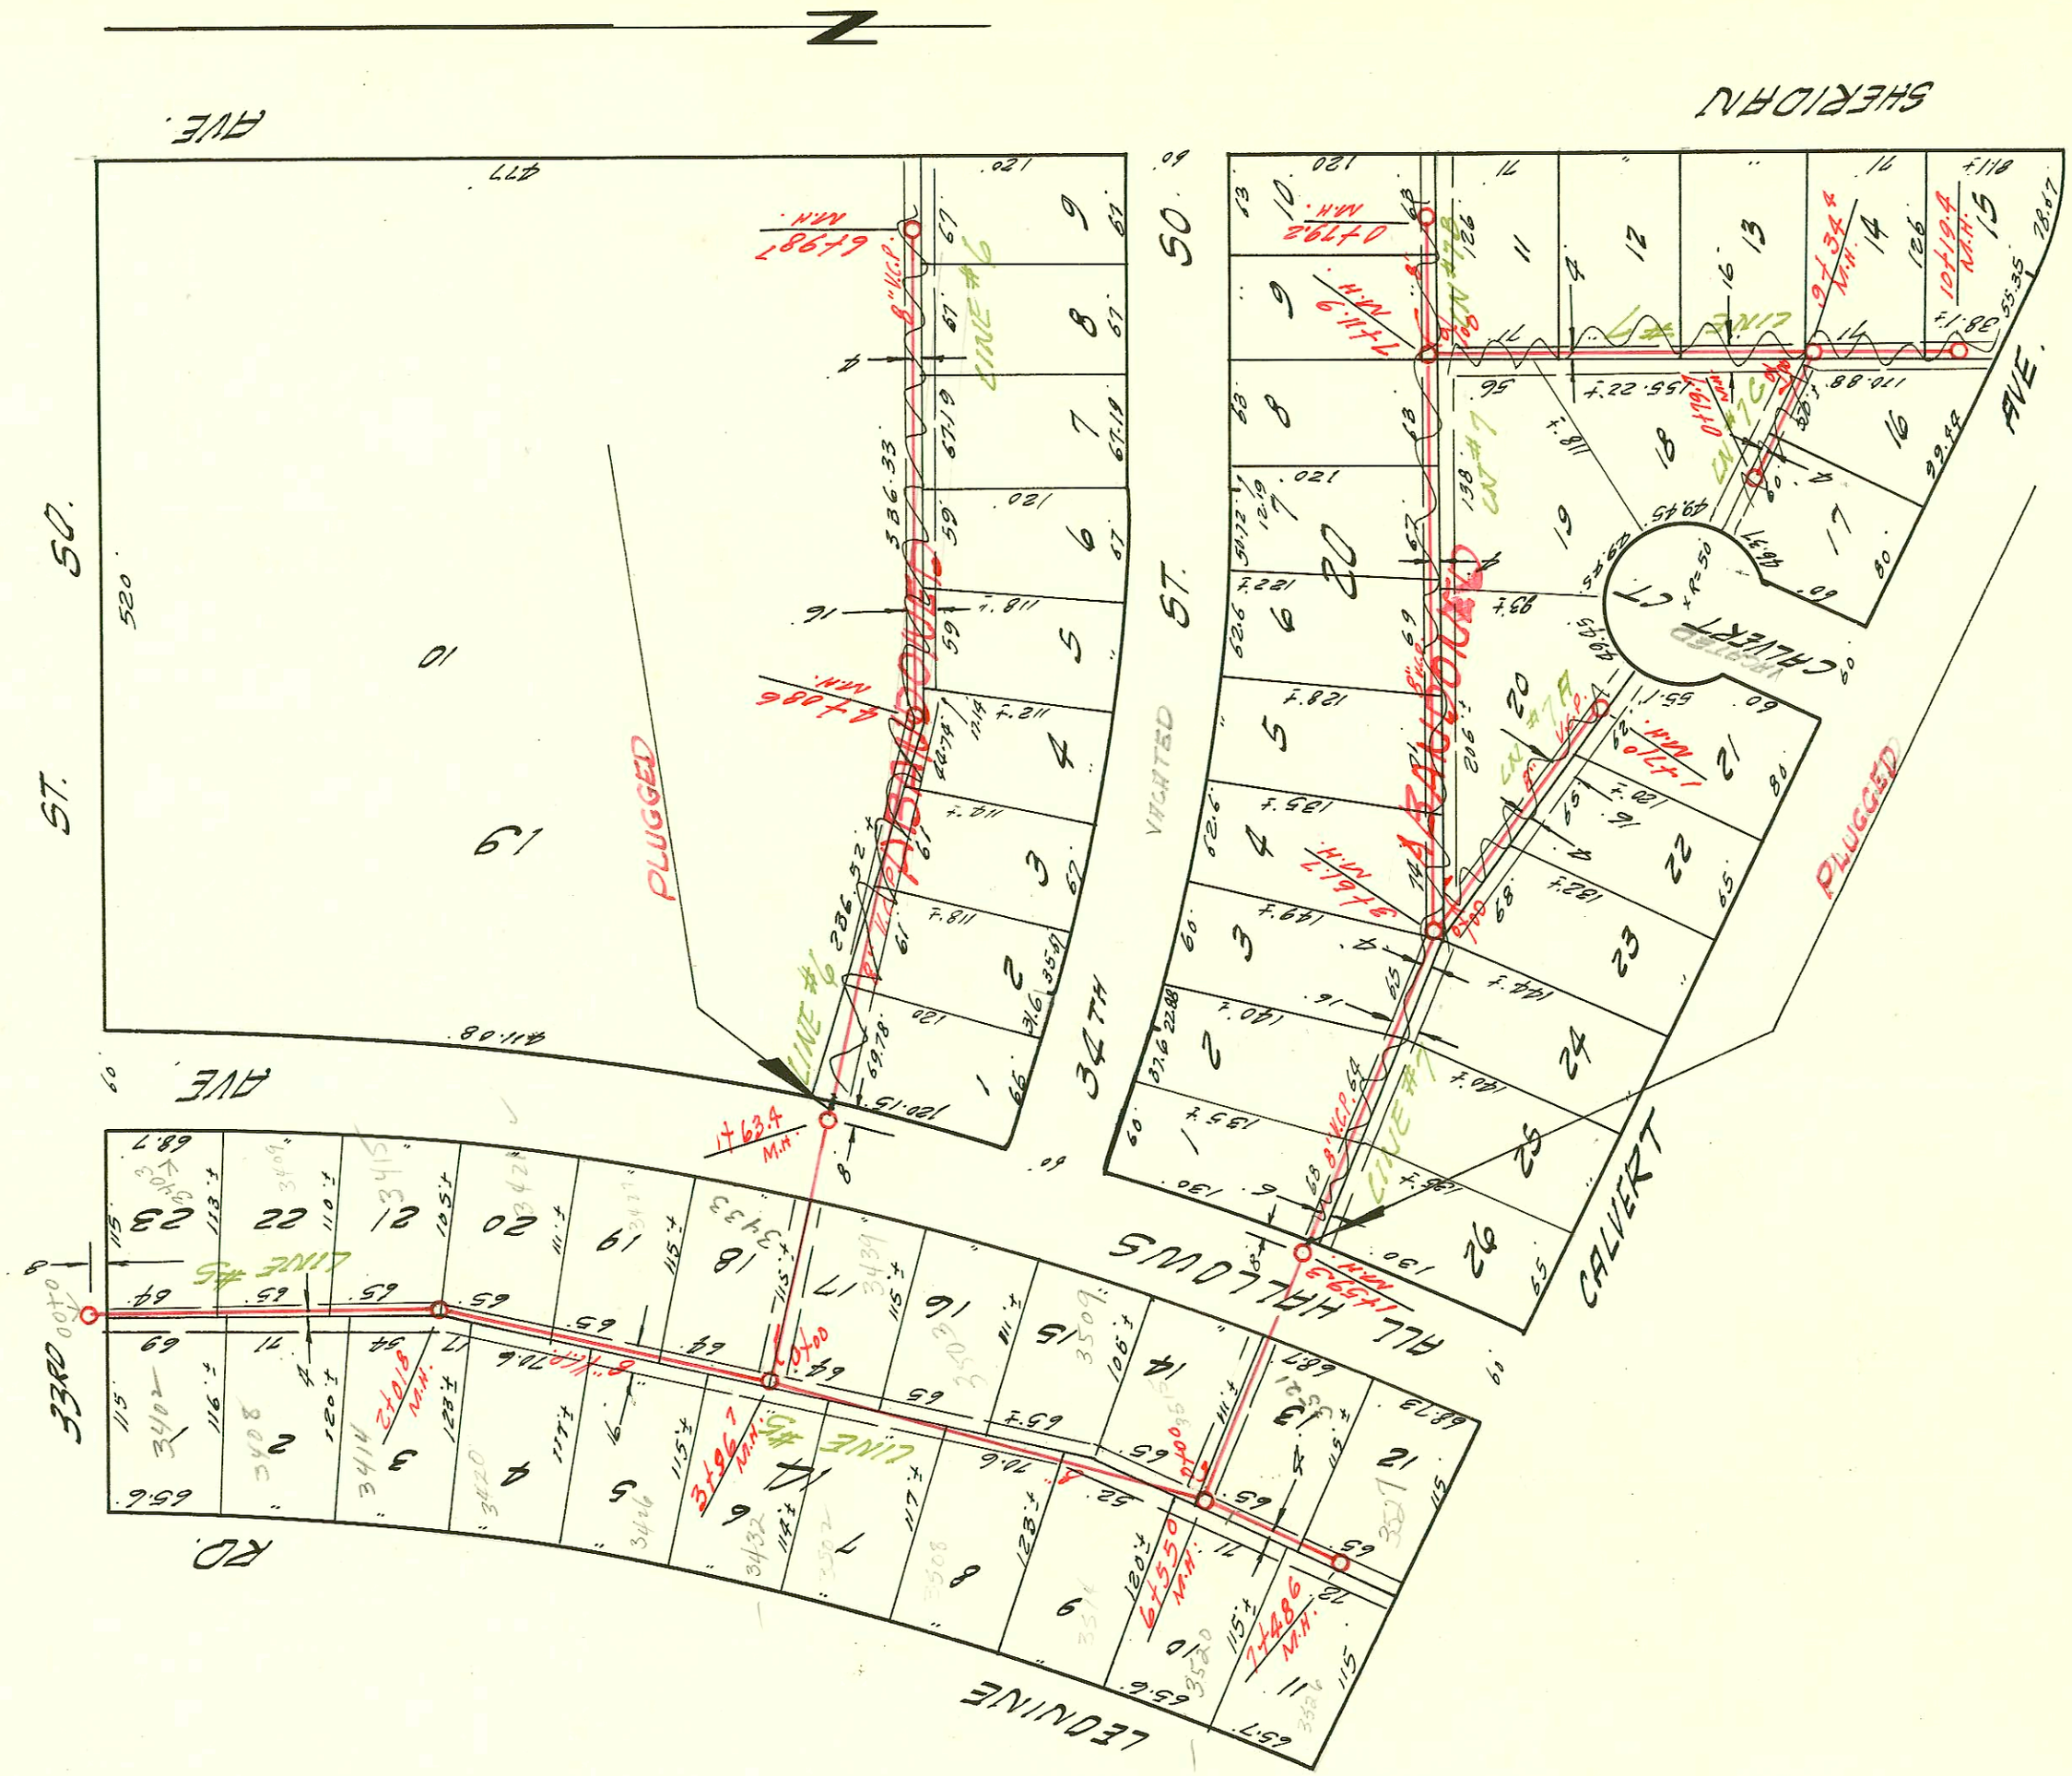
N
SHERIDAN
AVE.
50.
ST.
PLUGGED
VACATED
34TH
CALVERT
CHALLERT CT.
ALL HALLOWS
LEQUINE
RD.
33RD
LINE #5
LINE #6
LAT. 54 55.22
C 28-83

47

Form 41-(54) 6-57

CONSTRUCTION RECORD							SERVICE RECORD					
STATION	ELEVATION		Depth	MANHOLE	4-INCH "Y" BRANCHES		No. of Permit		House Number		DATE OF PERMITS	
	Ground	Grade			~~North~~ West	~~South~~ East	North West	South East	North West	South East	North West	South East
					11+8	09+8	11280	12449	3232 All Hallows	3230 S. Dow	8-28-59	4-4-60
	99.3	94.85	4.4	9+24.6								
					4" P.V.C. 40 9+76.5	74.5	94-26360-7 11279	10202	3226 R All Hallows	3227 S. Dow	3-2-94 8-28-59	4-30-59
10+00	99.1	95.00	4.1									
					10+47.3	45.3	11278	10201	3220 All Hallows	3221 S. Dow	8-28-59	4-30-59
11+00	99.5	95.20	4.3									
					11+12.2	(Est) ~~+10~~ 12.2	11277	14399	3217 All Hallows	3215 S. Dow	8-28-59	7-5-61
					11+77.0	75.0	11275	11797	3208 All Hallows	3207 S. Dow	8-28-59	11-12-59
12+00	99.5	95.40	4.1		12+42.6	40.6	11276	11796	3205 W 31 21-80	3203 S. Dow	8-28-59	11-12-59
	99.7	95.50	4.2	12+49.3								
LINE #2 0+00	98.9	93.38	5.5	Existing M.H.								
					0+75.6	0+73.6		#C7585		3351 S. All Hallows		3-27-68
1+00	99.8	93.60	6.2									
					1+40.2	1+38.2	C49898	#B9010	3344 Leonine	3345 S. All Hallows	6-12-75	6-7-68
2+00	98.7	93.80	4.9									
					1+97.3 ~~2+03.6~~	2+03.6	C49897	C17431	3338 Leonine	3339 S All Hallows	6-12-75	12-22-69
					2+70.5	2+68.5	C49896	C17432	3332 Leonine	3333 S All Hallows	6-12-75	12-22-69
	99.6	94.00	5.6	2+99.3								
3+00												
					3+34.6	3+32.6	C46123	#C17882	3326 Leonine	3327 So. All Hallows	8-8-74	2-5-70
					3+99.8	3+97.8	C46122	#C19452	3320 Leonine	3321 So. All Hallows	8-8-74	5-25-70
4+00	99.1	94.20	4.9									
					4+63' ~~4+65'~~	4+61' ~~4+63'~~	C46120	C16985	3314 Leonine	3315 S All Hallows	8-8-74	11-20-69
5+00	99.3	94.40	4.9									
					5+30.3	5+28.3	C53938	#C7586	3308 S Leonine	3309 S. All Hallows	2-25-76	3-27-68
					5+90.0	5+88.0	C40125	C42708	3302 S. Leonine	3303 S All Hallows	7-19-73	12-11-73
	99.1	94.60	4.5	5+98.7								
6+00												
7+00	99.2	94.80	4.4									
					4" SCH 40 CO 7+22.0	7+20.0	2001-01646 C45727	#C14106	3250 R Leonine	3251 All Hallows	7-6-01 7-15-74	5-15-69
					7+87.3	7+85.3	C24743	C10303	3244 Leonine	3246 All Hallows	6-4-71	9-3-68
8+00	99.4	95.00	4.4									
					8+51.2	8+49.2	C28493	#B449	3238 Leonine	3239 All Hallows	10-8-71	11-26-63
9+00	99.5	95.20	4.3									
					9+14.0	9+12.0	C26360	C13034	3232 S. Leonine	3233 All Hallows	8-11-71	3-5-69
	99.4	95.25	4.1	9+24.4								
					9+82.0	9+80.0	C45726	C11625	3226 Leonine	3227 All Hallows	7-15-74	11-20-68
10+00	99.6	95.40	4.2									
					10+46.0	10+44.0	C48228	C6763	3220 Leonine	3221 S. All Hallows	1-29-75	2-6-68
11+00	99.6	95.60	4.0									
					11+12.1	11+10.1	C47257	#C9906	3214 Leonine	3215 S All Hallows	11-1-74	8-2-68
					Top 11+85.9 Lr ~~11+76.0~~	75.3 ~~11+74.0~~	C41364	#C14618	3208 Leonine	3209 S. All Hallows	9-21-73	6-23-69
12+00	99.8	95.80	4.0									
					Top 12+44.8 Lr ~~12+34.8~~	12+32.8	C41363	C13838	3202 Leonine	3203 All Hallows	9-21-73	4-29-69
	99.7	95.90	3.8	12+48.7								
LINE #3 0+00	98.8	89.63	9.2	Existing M.H.								
					0+30.2	0+28.2 (5 Risers)	C52816	C19917	3402 Leonine	3403 S All Hallows	12-15-75	7-1-70
					1+19.9 ~~0+94.4~~	0+92.4 (5 Risers)	C52817	#C20576	3408 Leonine	3409 So. All Hallows	12-15-75	8-14-70
1+00	98.2	89.81	8.4									
					0+54.4	0+52.4 (5 Risers)	C52818	C20046	3414 Leonine	3415 All Hallows	12-15-75	7-10-70
2+00												
	98.1	90.02	8.1	2+01.8								
						2+19.3 ~~2+17.3~~ (5 Riser)	92-5465-7 C20919		3420 S. Leonine	3421 So. All Hallows		4-20-92 9-10-70
					2+39.6	(5 R.) 53150 2+89.0 (5 R.)		C20920		3427 So All Hallows	1-14-76	9-10-70
3+00	97.6	90.21	7.4									
					3+10.7 (5R)		#C20384		3426 So. Leonine	3433 S All Hallows	8-6-70	
						3+49.2 (5R)		C-22946				2-16-71
					3+83.2 (5R)		#C22247		3432 So Leonine		12-17-70	
4+00	97.7	90.41	7.3	3+96.7								
						4+16.6 (5R)		#C20383		3439 So. All Hallows		8-6-70
					4+54.3 (3R)							
					Top 4+70.2	~~4+94.7~~ 4+80.0 (3R)	C53151	11520	3502 S. Leonine	3503 All Hallows	1-15-76	2-19-89
5+00	97.9	90.61	7.3									
					5+22.5 (3R)		C53152		3508 S. Leonine		1-14-76	
						5+45.6 (3R)		#C21968		3509 So All Hallows		12-1-70
					5+94.3 (3R)		C53153		3514 S. Leonine		1-14-76	
6+00	97.7	90.81	6.9									