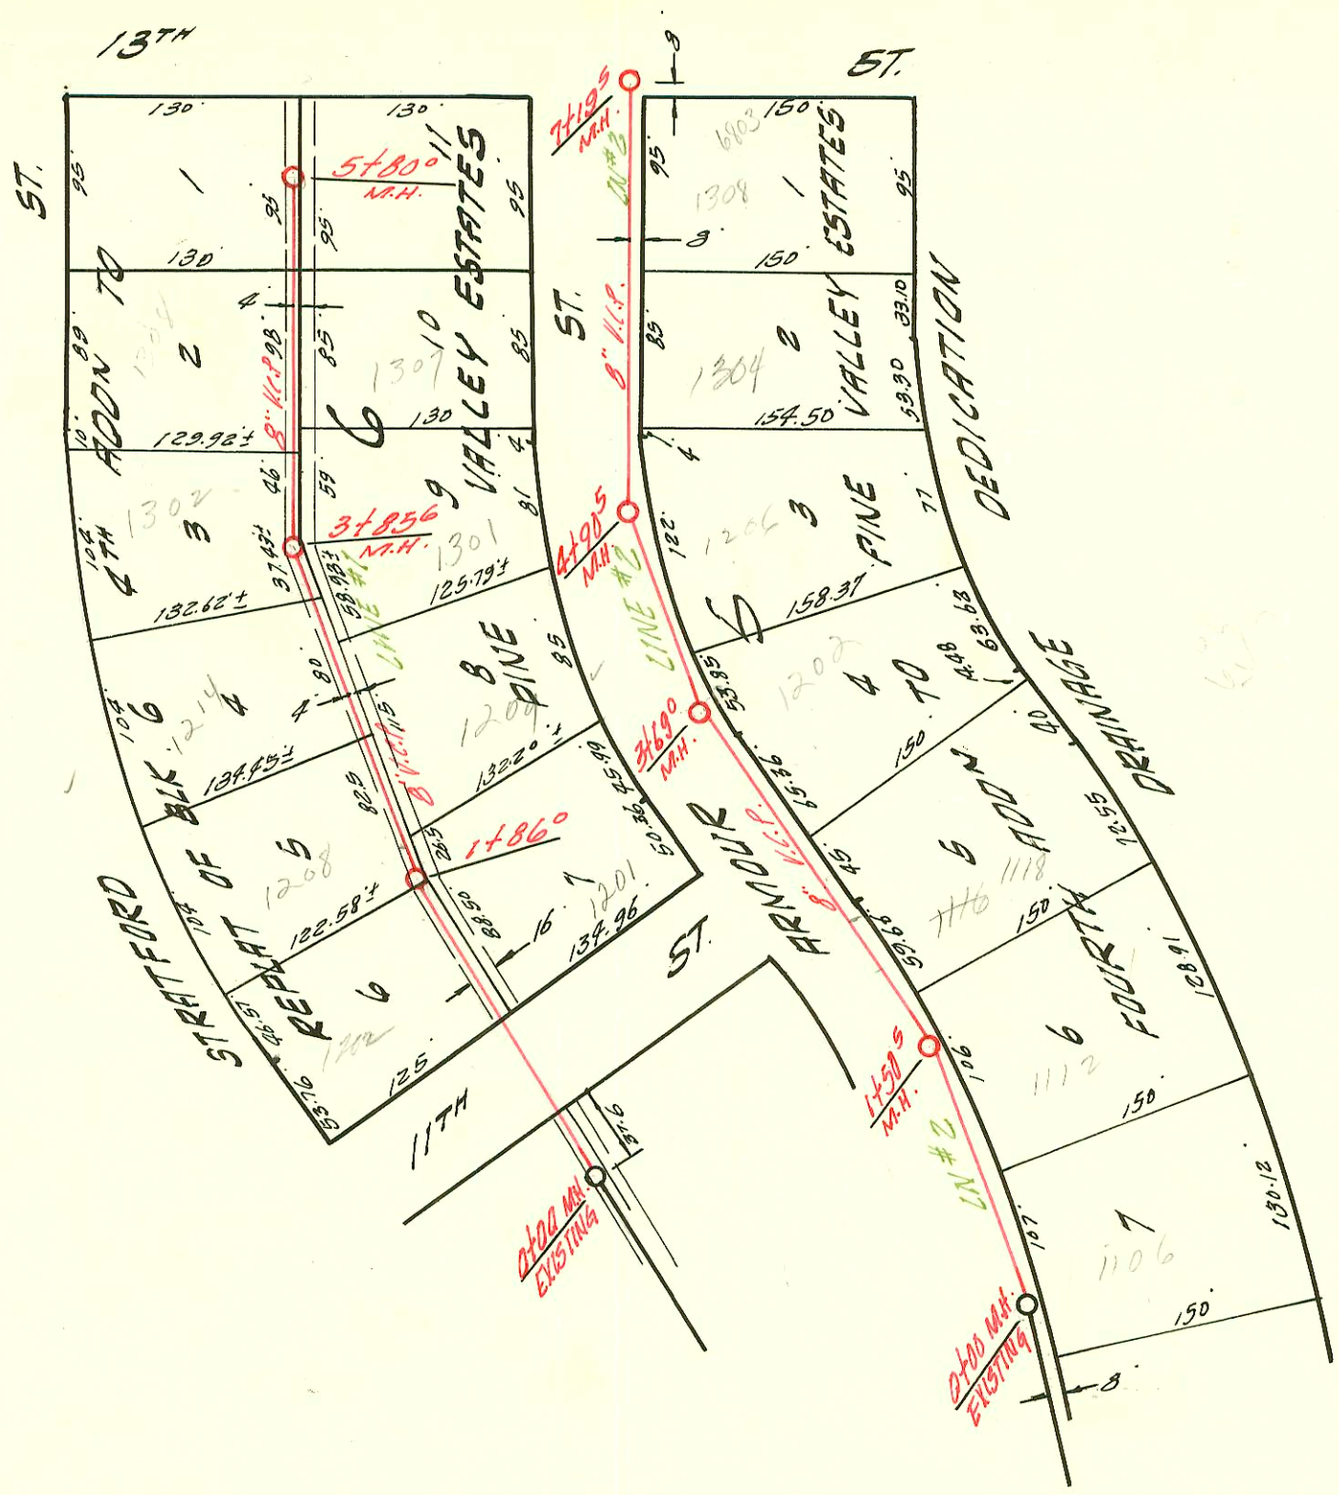

LAT. 69 D.C.S #2 S.S.12
W. B. CARTER CONSTR. CO. MAY 5'59
BK. NO. K-61 PROJ. NO. C28-120

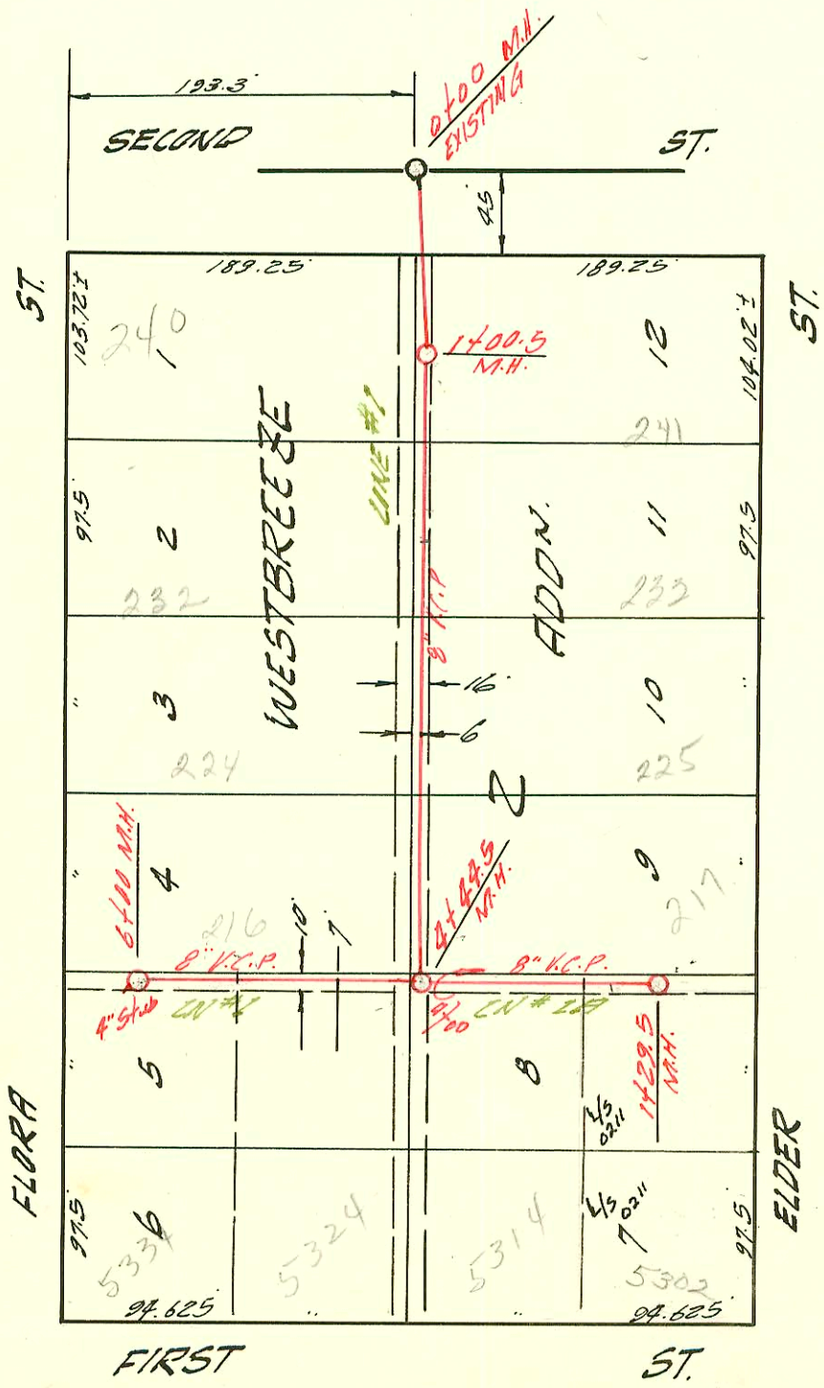

LATERAL 101 SUB. 5 S.S. 22
W. B. CARTER CONSTR. CO. MAY 1959
BK. NO. K-59 PROJ. NO. C29-8

51

Form 41-(54) 6-57

	CONSTRUCTION RECORD							SERVICE RECORD					
	STATION	ELEVATION Ground	ELEVATION Grade	Depth	MANHOLE	4-INCH "Y" BRANCHES ~~North~~ West	4-INCH "Y" BRANCHES ~~South~~ East	No. of Permit North West	No. of Permit South East	House Number North West	House Number South East	DATE OF PERMITS North West	DATE OF PERMITS South East
LINE #1	0+00	184.5	177.40	7.1	Existing M.H.								
	1+00	186.2	177.80	8.4		4" P.V.C. 40 1+19.5	top 1+34.6 / 1+17.5	2118 12603	C30767	1202 Stratford R	1201 N Armour	2-18-92 4-5-60	3-2-72
		187.7	178.14	9.6	1+86.0								
	2+00	187.8	178.25	9.5									
						2+10.0		10701		1208 Stratford		6-15-59	
							1+35.5	see 3 of 1833 12278	14649	1214 Stratford R	1209 Armour	7-14-63 2-19-60	9-8-61
						1+90.5							
	3+00	189.2	179.05	10.1									
							1+50.6		11680		1301 N. Armour		10-28-59
						1+66.5		11853		1302 Stratford		11-12-59	
		190.3	179.75	10.5	3+85.6								
	4+00	190.4	179.85	10.5									
						1+35.0		10328	2001 22391 11852	1308 Stratford	1307 R Armour	5-8-59	9-25-01 11-12-59
							4+64.8						
	5+00	190.3	180.65	9.6									
							1+48.6		15283		1315 Armour		3-12-62
						1+58.0		10233		1315 Stratford		5-5-59	
		190.8	181.29	9.5	5+80.0								
LINE #2	0+00	182.9	176.20	6.7	EXISTING M.H.								
	1+00	184.0	176.60	7.4									
							1+00.5						
		185.2	176.80	8.4	1+50.5								
							1+99.0						
	2+00	185.1	177.00	8.1									
							1+98.0						
	3+00	186.0	177.40	8.6									
		187.3	177.68	9.6	3+69.0								
	4+00	187.5	177.80	9.7									
							4+20.0		15386		1206 Armour		3-30-62
		187.5	178.16	9.3	4+90.5								
	5+00	187.4	178.20	9.2									
							1+45.0		11041		1304 Armour		8-4-59
	6+00	186.5	178.60	7.9									
							1+37.0		15076		1308 Armour		1-3-62
	7+00	187.8	179.00	8.8									
		187.4	179.08	8.3	7+19.5								
	LOT. 101 SUB. 5 S.S. 22												
LINE #1	0+00	120.2	111.85	8.3	Existing M.H.								
	1+00												
		119.4	112.05	7.3	1+00.5								
						+16.0	1+14.0 4" SCH 40 1+86.5	10427	10395 19-5519-1 10300	240 N. Elora	241 N. Elder 233 N Elder R	5-27-59	5-19-59 3/31/99 5-21-59
	2+00	118.2	112.25	5.9									
						4" SDR-35 2+04.0		27134 10393		232 N Elora		2-25-91 5-19-59	
						+74.0	2+84.0	10392	10394	234 N Elora	235 Elder	5-19-59	5-19-59
	3+00	117.5	112.45	5.0									
							3+75.0						
	4+00	117.8	112.65	5.1									
		118.2	OUT 112.74 IN 112.84	5.5 5.4	4+44.5								
							4+78.0 (N.S)		10517		5324 W. 1st		5-26-59
	5+00	118.7	112.95	5.7									
						5+64.0 (N.N)	+62.0 (N.S)	#6 18257 10391	10666	216 N. Elora	5334 W. 1st	16-2896 5-19-59	6-18-59
	6+00	118.7	113.15	5.5	6+00.0	4" stub	S.W.						
LINE #1A	0+00	117.7	112.86	4.8	Existing M.H.								
							+36.0 (N.S)		19829 10516		5314 W. 1st R		12-07-87 5-26-59
	1+00	118.3	113.05	5.2									
						1+02.0 (N.N)	+04.0 (N.S)	19817 10578	B3882	217 N. Elder R	5307 W. 1st R	6111 6-8-59	7-28-65
		118.3	113.11	5.1	1+29.5								

10917 Conway 1116 N. Armour Lippoldt 7-15-59 2+26.5
11387 Top 1202 N. Armour Reynolds 9-3-59 3+46
12621 Top 1201 N. Armour Hendley 5-2-60 (1+74) - C 30766 - 5.0 - 1201 N. Armour - 3-2-72 Jay Scanlon
15616 - top - 1106 Armour - Ken Lippoldt - 5-11-62 (0+06)
P16967 - top - 1112 Armour - Ken Lippoldt 4-18-63 (1+38.5)