J 60A

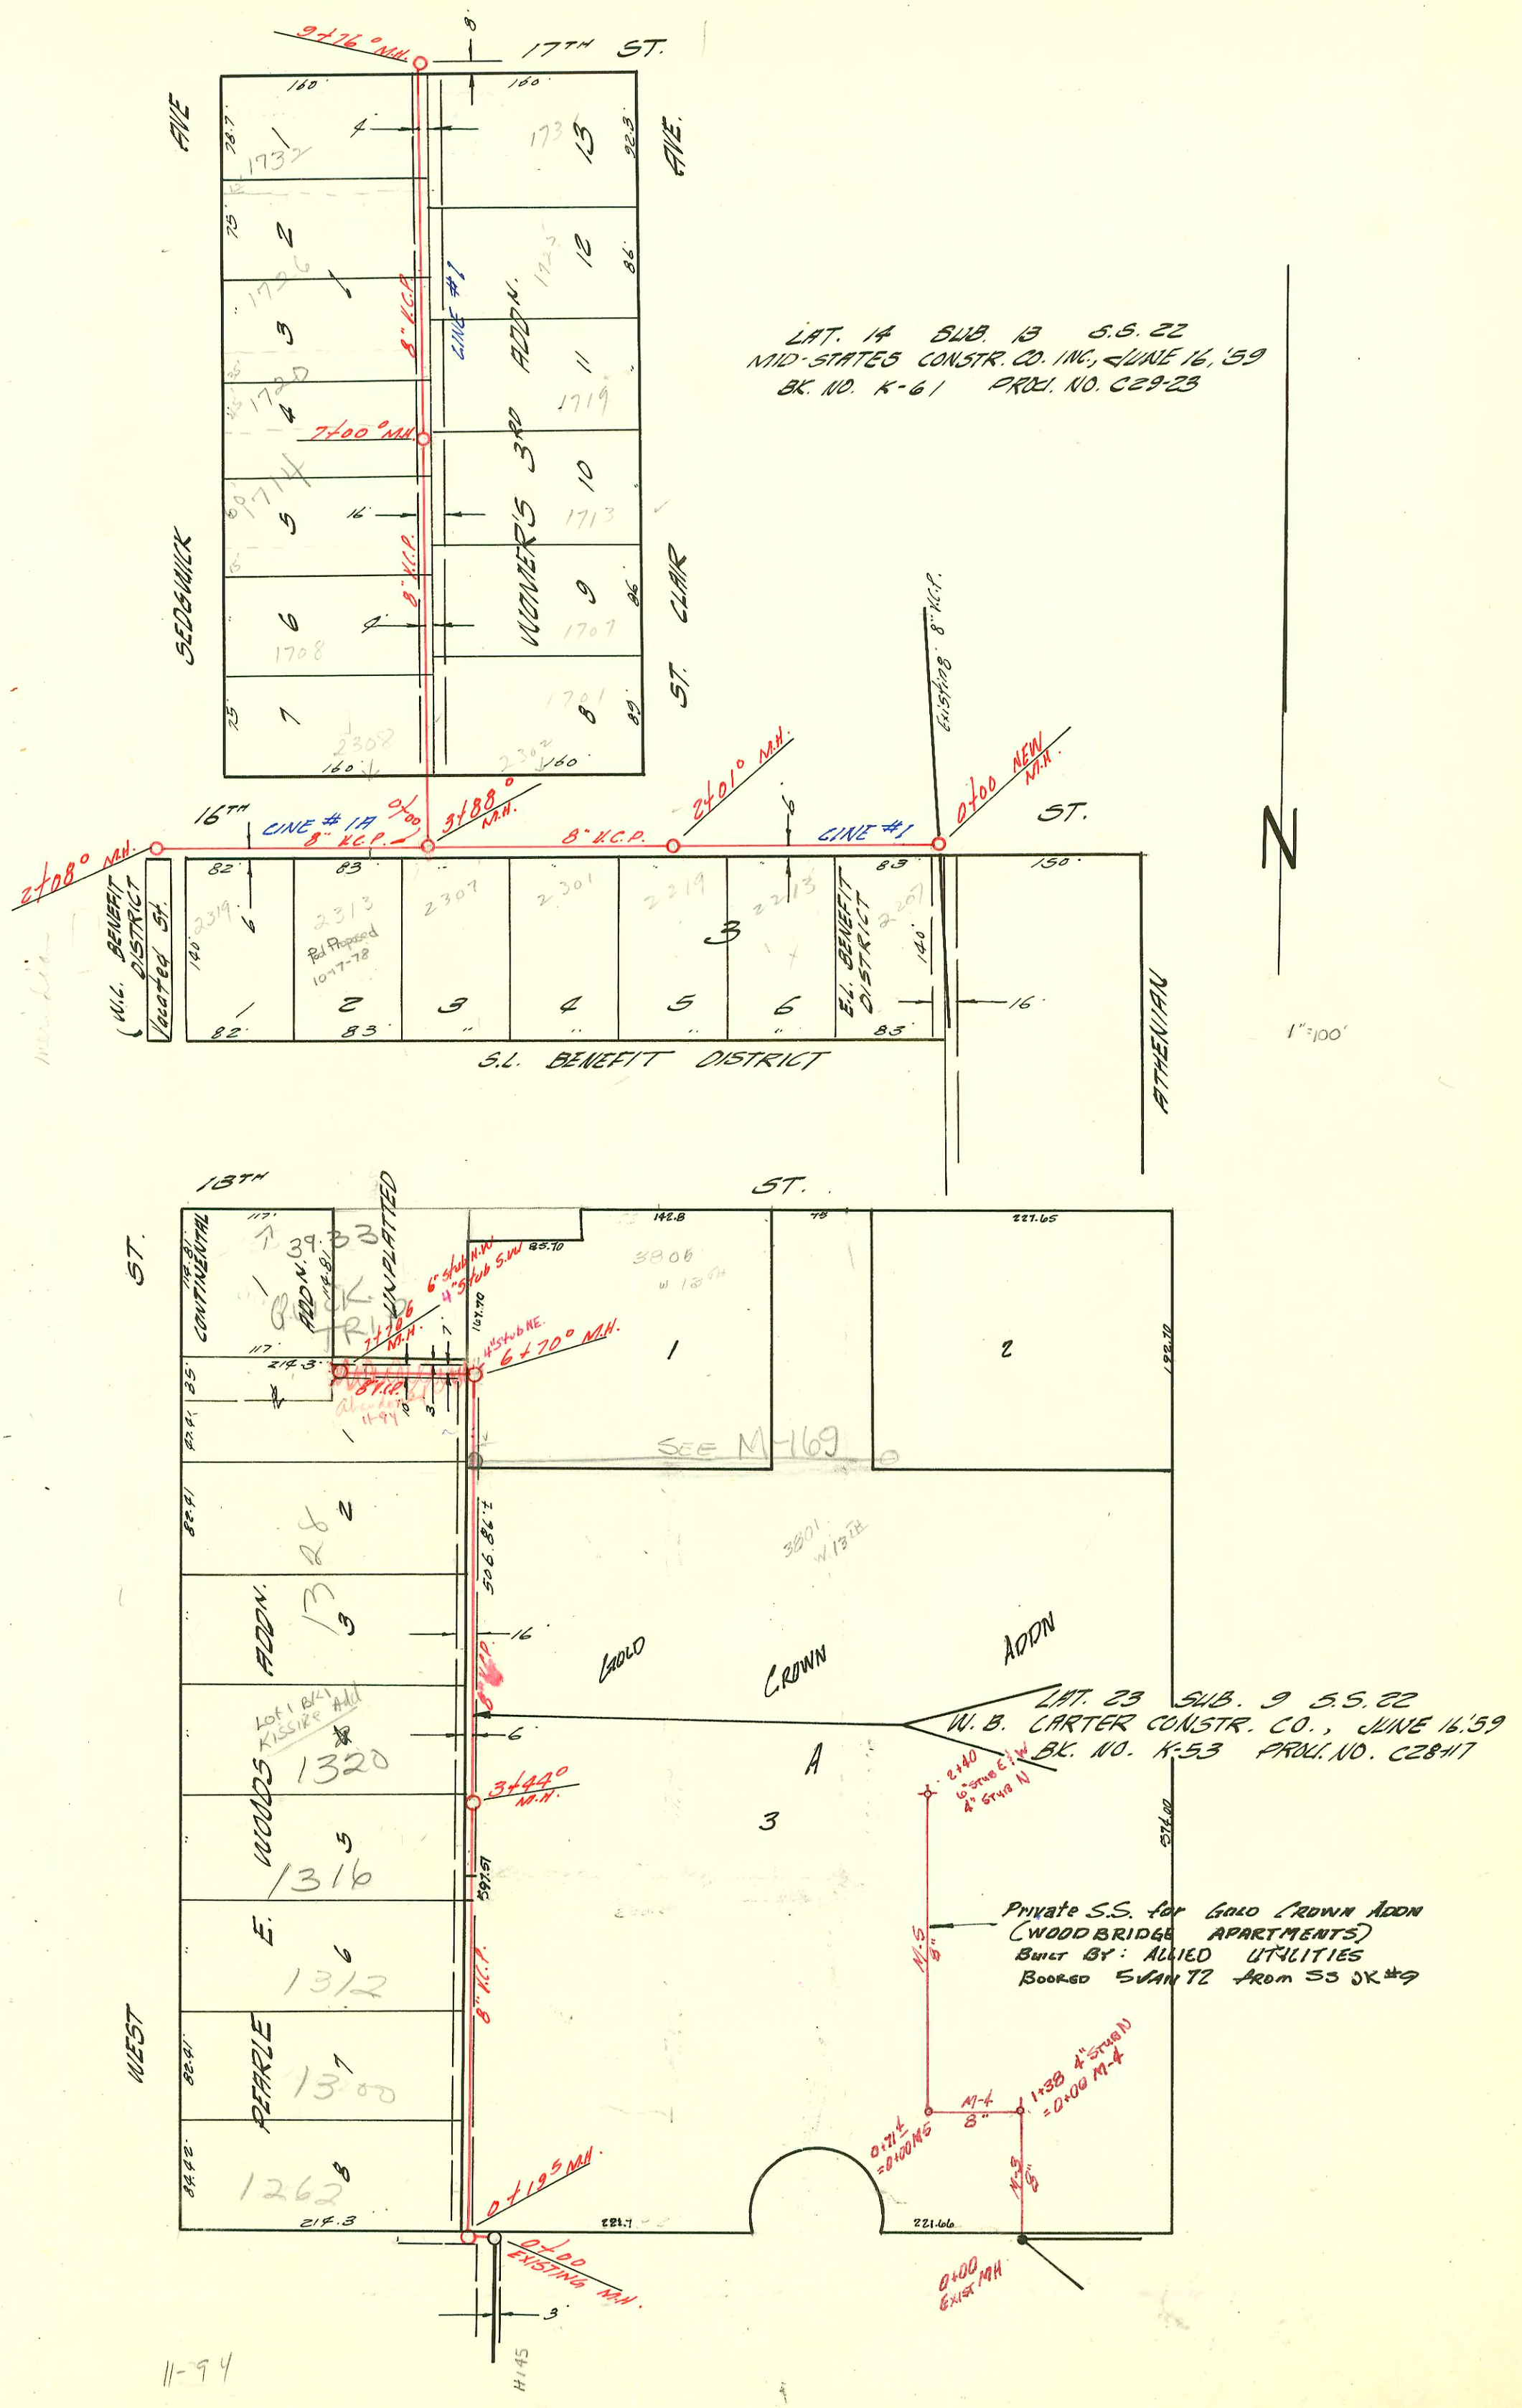
17TH ST.
SEDGWICK AVE.
ST. CLAIR AVE.
WUNTER'S ADDN.
LINE #1
8" K.C.P.
9+76 ° M.H.
7+00 ° M.H.
16TH ST.
LINE #1A
3+88 ° M.H.
2+01 ° M.H.
0+00 NEW M.H.
2+08 ° M.H.
W.L. BENEFIT DISTRICT
Vacated St.
S.L. BENEFIT DISTRICT
E.L. BENEFIT DISTRICT
ATHENIAN
N
1"=100'
LAT. 14 SUB. 13 S.S. 22
MID-STATES CONSTR. CO. INC., JUNE 16, '59
BK. NO. K-61 PROJ. NO. C29-23
13TH ST.
CONTINENTAL
UNPLATTED
SEE M-169
GOLD CROWN ADDN
LAT. 23 SUB. 9 S.S. 22
W. B. CARTER CONSTR. CO., JUNE 16, '59
BK. NO. K-53 PROJ. NO. C28-117
Private S.S. for GOLD CROWN ADDN
(WOODBRIDGE APARTMENTS)
BUILT BY: ALLIED UTILITIES
BOOKED SVAN 72 FROM SS BK #9
WOODS ADDN.
PEARLE
WEST
0+195 MH.
0+00 EXISTING MH.
0+00 EXIST MH
11-94

60

Form 41-(54) 6-57

CONSTRUCTION RECORD							SERVICE RECORD					
STATION	ELEVATION		Depth	MANHOLE	4-INCH "Y" BRANCHES		No. of Permit		House Number		DATE OF PERMITS	
	Ground	Grade			~~North~~ West	~~South~~ East	North West	South East	North West	South East	North West	South East
LINE #1 0+00	120.0	111.90	8.1	NEW-N.H								
						0+22° (S.Y.)		12225		2207 W. 16th		1-14-60
1+00	120.1	112.10	8.0									
						+04° (S.Y.)		12444		2213 W. 16th		4-4-60
						+90° (S.Y.)		13211		2219 W. 16th		7-27-60
2+00												
	120.8	112.30	8.5	2+01°								
						+73° (S.Y.)		12877		2301 W. 16th		6-9-60
3+00	121.3	112.50	8.8									
						+55 (S.Y.)		#14791		2307 W. 16th		10-6-61
	123.9	OUT 112.68 IN 112.79	11.2 11.1	3+88°								
4+00	124.1	112.80	11.3									
					+69°	+67°	10983		2308 W. 16th		7-13-59	
5+00	125.8	113.00	12.8									
					+41°	+53°						
6+00	125.1	113.20	11.9									
					+13°	+39°	14596	14190	1714 N. Lafayette	1713 N. St. Clair	8-24-61	5-16-61
					+83°							
7+00	124.7	113.40	11.3	7+00°								
					+65°	7+28°		12700		1719 N. St. Clair		4-25-60
8+00	122.6	113.60	9.0									
					+40°	8+12.5		11710		1725 N. St Clair		10-19-59
						8+93.8		10542		1731 N. St Clair		6-16-59
9+00	125.4	113.80	11.6									
					9+15°							
	124.8	113.95	10.8	9+76°								
LINE #1A 0+00	125.9	112.68	11.2	Existing N.H.								
						+41° (N.S.)		#14423		2313 W. 16th		7-10-61
1+00	125.2	112.88	12.3									
						+25° (N.S.)		#15519		2319 W. 16th		4-23-62
						+98.5 (N.S.)		12707		2401 W. 16th		4-27-60
2+00	125.5	113.08	12.4									
	125.6	113.09	12.5	2+08°								
LAT. 23 SUB. 9 6.5.22												
0+00	128.0	118.84	9.2	Existing N.H.								
	128.4	OUT 118.88 IN 118.98	9.5 9.4	+19.5								
					+53°	+42°	11063		1254 N. West		8-7-59	
						+90.5						
1+00	126.6	119.14	7.5									
						+23.5		C29804		3801 W 13th Bldg #5		
						+42°						
					1+64°		14941		1262 N. West		11-16-61	
						+86°						
2+00	126.4	119.34	7.1									
					2+17.5	+39°	10859		1300 N. West		7-13-59	
3+00	126.7	119.54	7.2									
						2+50.4		C29803		3801 W 13th Bldg #4		1-3-72
					3+01°	+08°	10663		1312 N. West		6-18-59	
	126.7	119.63	7.1	3+44°								
					3+82°	+56°	25320 12142		1320 N. West		5-15-60 1-5-60	
4+00	126.6	119.74	6.9									
						4+01°		C29802		3801 W 13th Bldg #3		1-3-72
						+08						
					4+66°	+68°	20725 12143		1328 N. West		5-25-60 1-5-60	
						5+01°		C29801		3801 W 13th Bldg #2		1-3-72
5+00	126.4	119.84	6.6									
					5+49°	5+09°						
						5+64°						
						6+26°		C33263		3805-41 W. 13th		6-29-72
6+00	125.8	120.14	5.7									
					4" Stub 35 6+32.4 tap	6+11°	94-18827		3933 W. 13th Quik Trip		11-16-94	
	126.0	OUT 120.28 IN 120.38	5.7 5.6	6+70°	4" Stub NE.							
					+82° (N.N.)		Seal #C1882 12228		3931 W. 13	3915	2-14-67 1-15-60	
7+00	126.0	120.44	5.6									
					+43.4 (N.N.)		94 15287 2097	24109	3935 W. 13th	3925 W. 13th	9-22-94 1-6-60	10-16-89 4-14-67
	126.3	120.58	5.8	7+70.6	6" Stub N.W. & 4" Stub S.W.		12358	C2700				
M-3												
0+00	127.0	117.59	9.4	0+00 Exist	tap 0+91			C29807	3801 W 13th Bldg #7		1-3-72	
	127.4	118.13	9.3	1+38 4" Stub N = 0+00 M4								
M-4												
0+00	127.4	118.23	9.2	0+00 = 1+38 M-3								
	128.0	118.51	9.5	0+71.4 = 0+00 M5								
M-5												
0+00	128.0	118.61	9.4	0+00 = 0+71.4 M4								
1+00	128.4	119.01	9.4		tap 0+29	tap 0+64	C29806	C29808	3801 W 13th Bldg #6	3801 W 13th Bldg #8	1-3-72	1-3-72
2+00	128.1	119.41	8.9			tap 2+13.6		C29809		3801 W 13th Bldg #9		1-3-72
	127.8	119.51	8.2	2+40 6" Stub E & W 4" Stub N.			C29805	C29810	3801 W 13th Bldg #1	3801 W 13th Bldg #10	1-3-72	1-3-72

PRIVATE S.S. WOOD BRIDGE APTS.

14592 tap - 1720 N. Sedgwick - G L Joy, Jr - 8-24-61 (7+30)
14792 - tap - 1707 N. St. Clair - Jayhawk Bldg - 10-6-61 (5+68.0)
14932 - tap - 1738 N. Sedgwick - Jayhawk Bldg 11-22-61 (9+43)
15723 - tap - 1726 N. Sedgwick - Jayhawk Bldg 6-7-62 (8+10)
13488 Tap 2308 W 16th North - Al Henning 11-7-60 (5+07)
14035 Tap 1708 N Sedgwick Al Henning 4-3-61 (5+59)
C 32454 tap 3801 W 13th - Dean Lee 5-24-72 (1+(4°) line M-5)
Club House