6/A

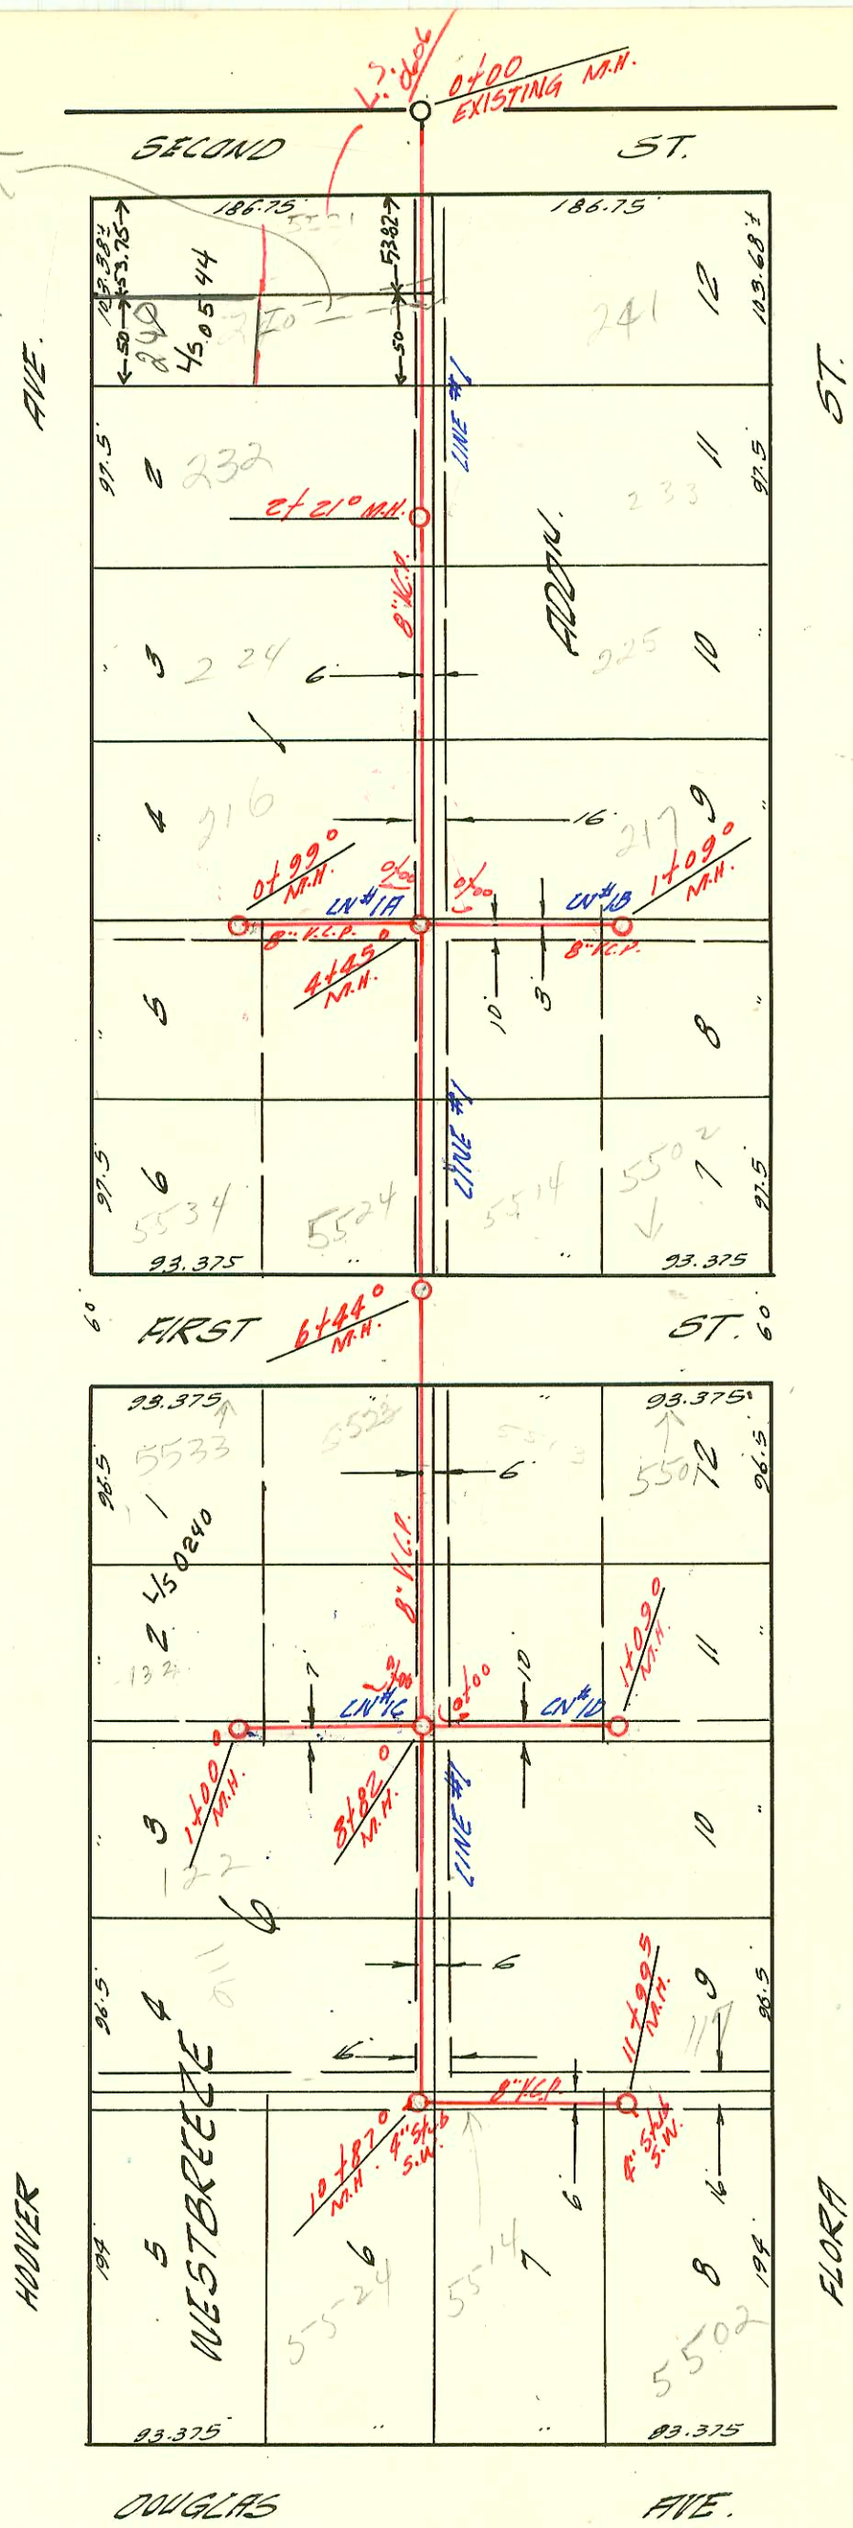

LAT. 54 SUB. 5 S.S.22
W.B. CARTER CONSTR. CO. INC., JUNE 16, '59
BK. NO. K-64A PROJ. NO. C28-54

61

Form 41-(54) 6-57

	CONSTRUCTION RECORD							SERVICE RECORD					
	STATION	ELEVATION Ground	ELEVATION Grade	Depth	MANHOLE	4-INCH "Y" BRANCHES ~~North~~ West	4-INCH "Y" BRANCHES ~~South~~ East	No. of Permit North West	No. of Permit South East	House Number North West	House Number South East	DATE OF PERMITS North West	DATE OF PERMITS South East
LINE #1	0+00	120.5	110.00	10.5	EXISTING M.H.								
	1+00					0+98.6		12219		5521 W. 2nd		10-11-84	
						1+05°	1+03°	13212	22432 / 14529	240 N Hoover	241 N Flora	7-27-60	1-18-89 / 8-7-61
						1+76.5	1+78.5	11609 / 06812	15374	232 N. Hoover	233 N. Flora	10-8-59 / 10-19-82	3-28-62
	2+00	118.0	110.20	7.8									
		118.0	110.44	7.6	2+21°								
						3+76.5	3+72.5	B217	B4811	224 N. Hoover	225 N. Flora	10-2-63	12-22-65
	3+00	117.7	110.60	7.1									
	4+00	117.5	110.80	6.7									
		117.6	110.89	6.7	4+45°								
	5+00	117.4	111.00	6.4									
						5+61.5	5+24 / 5+29°	22698 / 11407	21326 / 15919	5524 R / 12	5514 R West 1/2	3-13-89 R / 9-4-59	8-18-88 / 7-18-62
	6+00	117.1	111.20	5.9									
		116.6	111.29	5.3	6+44°								
	7+00	118.6	111.40	7.2									
						7+55°	7+57°	12242	B1124	5523 W. 1st	5513 W. 1st	1-26-60	4-21-64
	8+00	119.0	111.60	7.4									
		118.4	111.76	6.6	8+82°								
	9+00	118.1	111.80	6.3									
	10+00	118.5	112.00	6.5									
						9+29°		9508 / 10690		116 N. Hoover		10-26-83 / 6-23-59	was never connected to sewer in 1959 Abandoned in 1983
		118.1	OUT 112.18 IN 112.28	5.9 / 5.8	10+87°	4" stub S.W.		12512		5524 W Douglas		4-19-60	
	11+00												
						11+26.5 (K.S.) 4" SDR 35			# 14009		5514 W Douglas R		3-28-61
						11+77° (K.N.)	11+87.5 (K.S.)	12497	93 28523-7 13489	117 N. Flora	5502 R Douglas	4-15-60	11-29-60 / 11-4-60
		118.3	112.50	5.8	11+99.5	4" stub S.E.							
LN #1A	0+00	117.7	113.02	4.7	Existing M.H.								
						1+89°	1+92°	17409	14013	216 N. Hoover	5534 W. 1st	7-17-63	3-29-61
		117.6	113.40	4.3	0+99°								
LN #1B	0+00	117.7	112.48	5.2	Existing M.H.								
						0+99°		15252		217 N. Flora		3-7-62	
	1+00	117.0	112.90	4.1			SDR 35 1+01°		96-66633-7 R 15279		5502 R W. 1st		5-7-96 R / 3-9-62
		117.0	112.94	4.1	1+09°								
LN #1C	0+00	118.9	112.52	6.4									
						1+82.5	1+80.5						
	1+00°	118.2	112.90	5.3	1+00°	M.H. tap		15910		1327 N. Hoover		10-6-75	
LN #1D	0+00	118.9	111.84	7.1	Existing M.H.								
	1+00	118.3	112.26	6.0									
						1+04°	1+02°	14513	10712	5501 W. 1st	123 N Flora	8-3-61	6-16-59
		118.9	112.30	6.6	1+09°								

10691 Tap 5533 W 1st Bowers Plbg 6-24-59 0+95
#10933 tap - 122 N. Hoover - Bowers Plbg 6-26-59 0+97 Line 1C
15919 tap 5514 W 1st - Reynolds 7-18-62