J 71 A

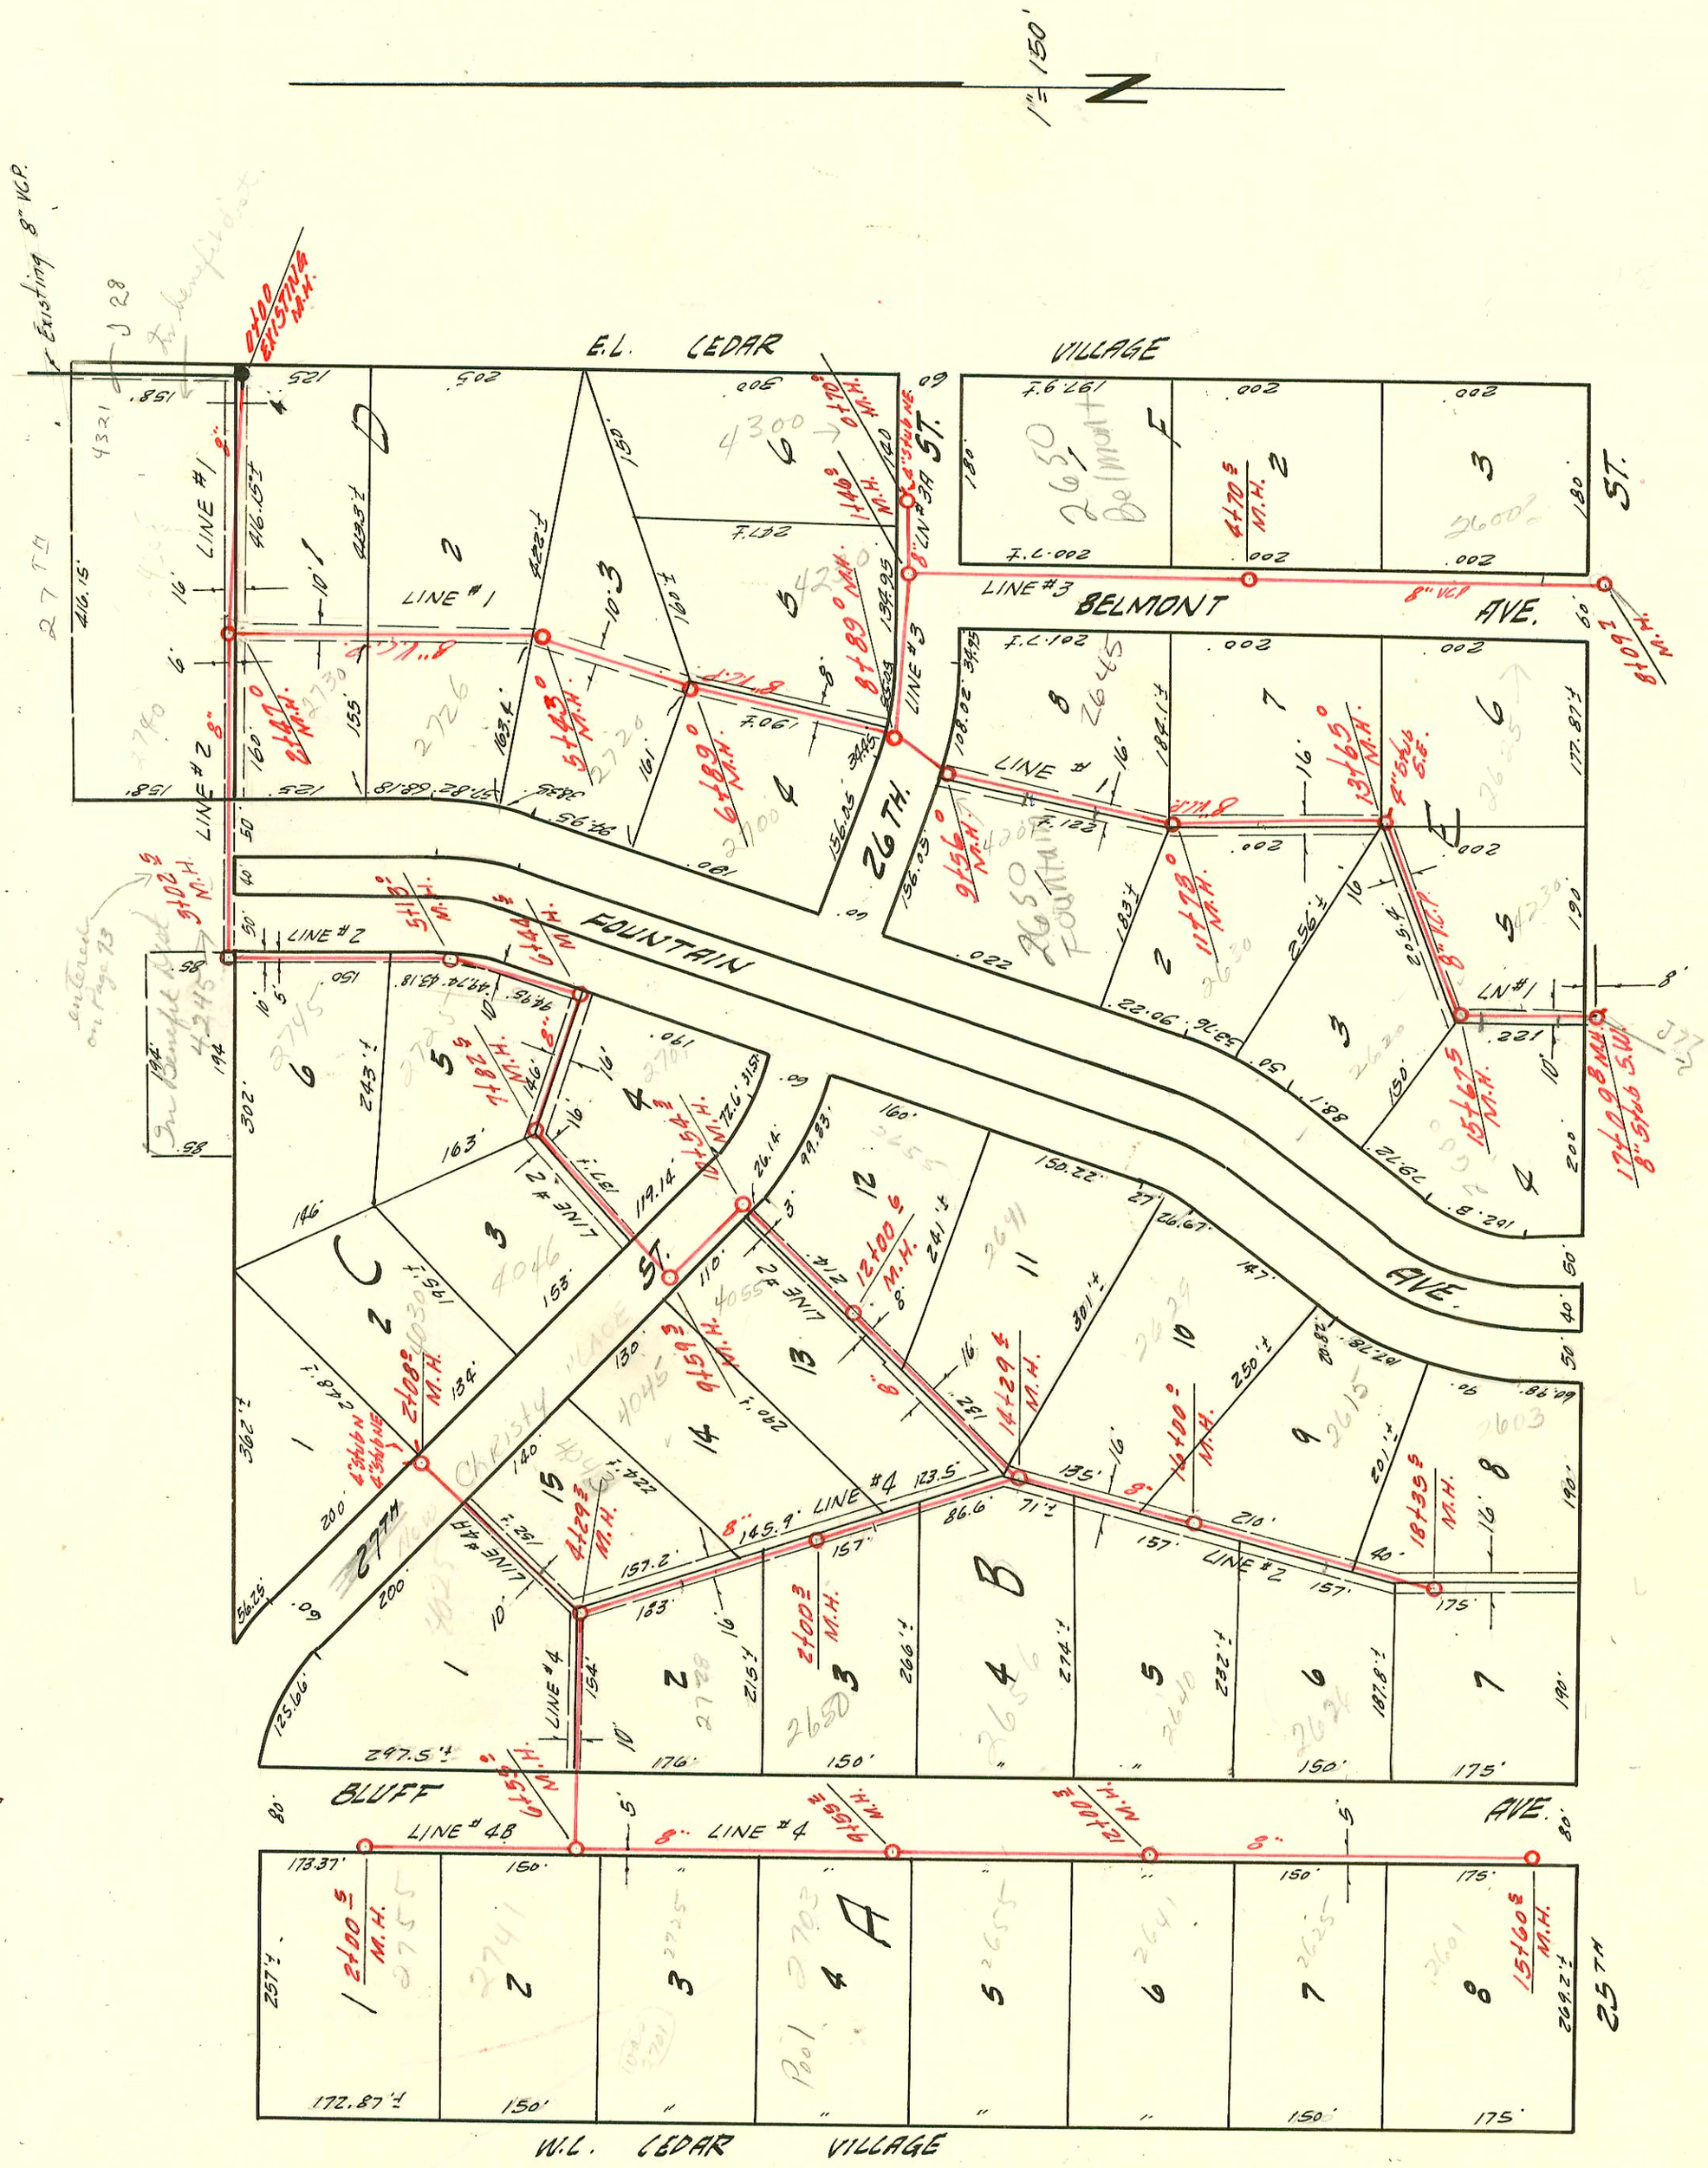

LAT. 4 SUB. 1 SAN. SEWER 23
W.B. CARTER CONST. CO. JULY, 1959
BOOK NO. K-45 A. PROJ. NO. CZB-52

Rep 2000-02031- 9/15/00- 2726 N Fountain Ave- Reddi Rootr- 4" SCH40 76'N of MH 5+43 (4+67) 1 Twin co, 1 V22, 2 H22, 1 V45, 1 Fernco to clay 2' from Main / Fernco to cast iron athouse / looks like tap on top of Main (old tap) / tap not uncovered.

71

Form 41-(54) 6-57

CONSTRUCTION RECORD							SERVICE RECORD					
STATION	ELEVATION		Depth	MANHOLE	4-INCH "Y" BRANCHES		No. of Permit		House Number		DATE OF PERMITS	
	Ground	Grade			~~North~~ West	~~South~~ East	North West	South East	North West	South East	North West	South East
						LINE #1						
0+00	160.4	149.51	10.9	Existing M.H.								
1+00	159.0	149.91	9.1		Tap 0+20		263433		4321 E. 27th N.		10-10-79	
2+00	159.1	150.31	8.8									
	159.3	OUT 150.50 IN 150.64	8.8 8.7	2+47°								
3+00	159.5	150.97	8.5									
					4+08.6 (4' Riser)		10937.		2736 N. Fountain		7-16-59	
4+00	160.4	151.67	8.7									
					4+15.5 (4' Riser)		12187		2726 N. Fountain		2-1-60	
					4+ 3CH40		2000-02091		2726 N. Fountain	R see next pg	9-15-00	
					4+67° (4' Riser)		12186				2-1-60	
5+00	160.7	152.37	8.3									
	160.5	OUT 152.68 IN 156.00	7.8 4.5	5+43°								
6+00	161.4	156.50	4.9									
					6+06°							
					6+38°		#10788		2710 N. Fountain		7-6-59	
	162.8	157.31	5.5	6+89°								
7+00	163.5	157.40	6.1									
					7+14°						see Line 3 (2nd conn)	
						7+56.5		11122		4239 E. 26th		7-30-59
					7+99°		11109		2700 N. Fountain		7-29-59	
8+00	165.2	158.30	6.9									
	166.2	159.11	7.1	8+89°								
9+00												
	167.0	159.52	7.5	9+56°								
10+00	167.3	159.77	7.5									
					10+35°		#10817		2650 N. Fountain		7-7-59	
						+66°		10758		2645 N. Belmont		6-30-59
11+00	168.0	160.37	7.6		11+00°		#10818		2650 N. Fountain		7-7-59	
	168.7	160.82	7.9	11+73°								
12+00	169.5	160.97	8.5									
						+26.5		10910		2635 N. Belmont		7-13-59
					12+60°		21077 11353		2630 N. Fountain	R	7-15-88 8-31-59	
13+00	170.5	161.57	8.9									
						+03°		10911		2635 N. Belmont		7-13-59
	171.7	161.98	9.7	13+65°	4" Stub S.E.		11378		2625 N. Belmont		9-2-59	
14+00	170.7	162.27	8.4									
					14+28° (South wye)			North wye		4230 E. 25th		
					14+70.5							
15+00	169.4	162.87	6.5									
						North wye +48°						
	168.6	163.29	5.3	15+67.5	15+72.1		1958		2620 N. Fountain		11-24-80	
					15+99.5 (1" Riser)		#10790		2600 N. Fountain		7-6-59	
16+00	169.2	163.57	5.6									
					16+72° (1" Riser)		#10782		2600 N. Fountain		7-6-59	
					+95.5 (3" Riser)		11134			4260 E. 25th		8-3-59
17+00	170.2	164.17	6.0									
	169.9	164.22	5.7	17+09.8	8" Stub S.W.							
					LINE #4							
0+00	170.7	156.80	13.9	0+00								
					+28° (8' Riser)							
1+00	172.5	157.20	15.3									
					1+46.5 (11' Riser)		223380 12086		2650 N. Bluff	Repair	12-29-03 12-28-59	
					1+85° (11' Riser)			13262		4045 Christy		8-26-60
2+00	175.3	157.60	17.7									
				2+00.3								
					2+93° (11' Riser)							
3+00	177.2	158.00	19.2									
4+00	173.5	158.40	15.1									
	171.9	158.51	13.4	4+29.3								
5+00	170.3	158.90	11.4									
6+00	168.1	159.30	8.8			6+00.5 Tap		26425		2728 Bluff		10-30-90
	167.7	159.50	8.2	6+55°								
7+00	169.3	162.35	7.0									
8+00	170.8	163.80	7.0									
					8+04°		11074		2725 N. Bluff		8-10-59	
9+00	173.0	165.28	7.7									
					9+31.5		10971		2703 N. Bluff		7-21-59	
	173.5	165.90	7.6	9+55.2								
10+00	173.6	166.60	7.0									
					10+39.5		B4408		2655 N. Bluff		10-25-65	
11+00	175.0	168.00	7.0									

(Continued on next sheet)

1958
#12877 - tap - 2620 N. Fountain - Burley 11-24-80 5-27-60 (14+71.5)
#11249 - tap - 2640 N. Fountain - Art Dockum - 6-2-61 (line 2, 0+51)
#B2101 Tap - 4305 E. 270 No. - Leopold T - 10-8-61 (1+89.6)
#B3300 - tap - 2656 N. Bluff - Reynolds Rly - 5-7-65 (14+83.8)

7