J 71 A

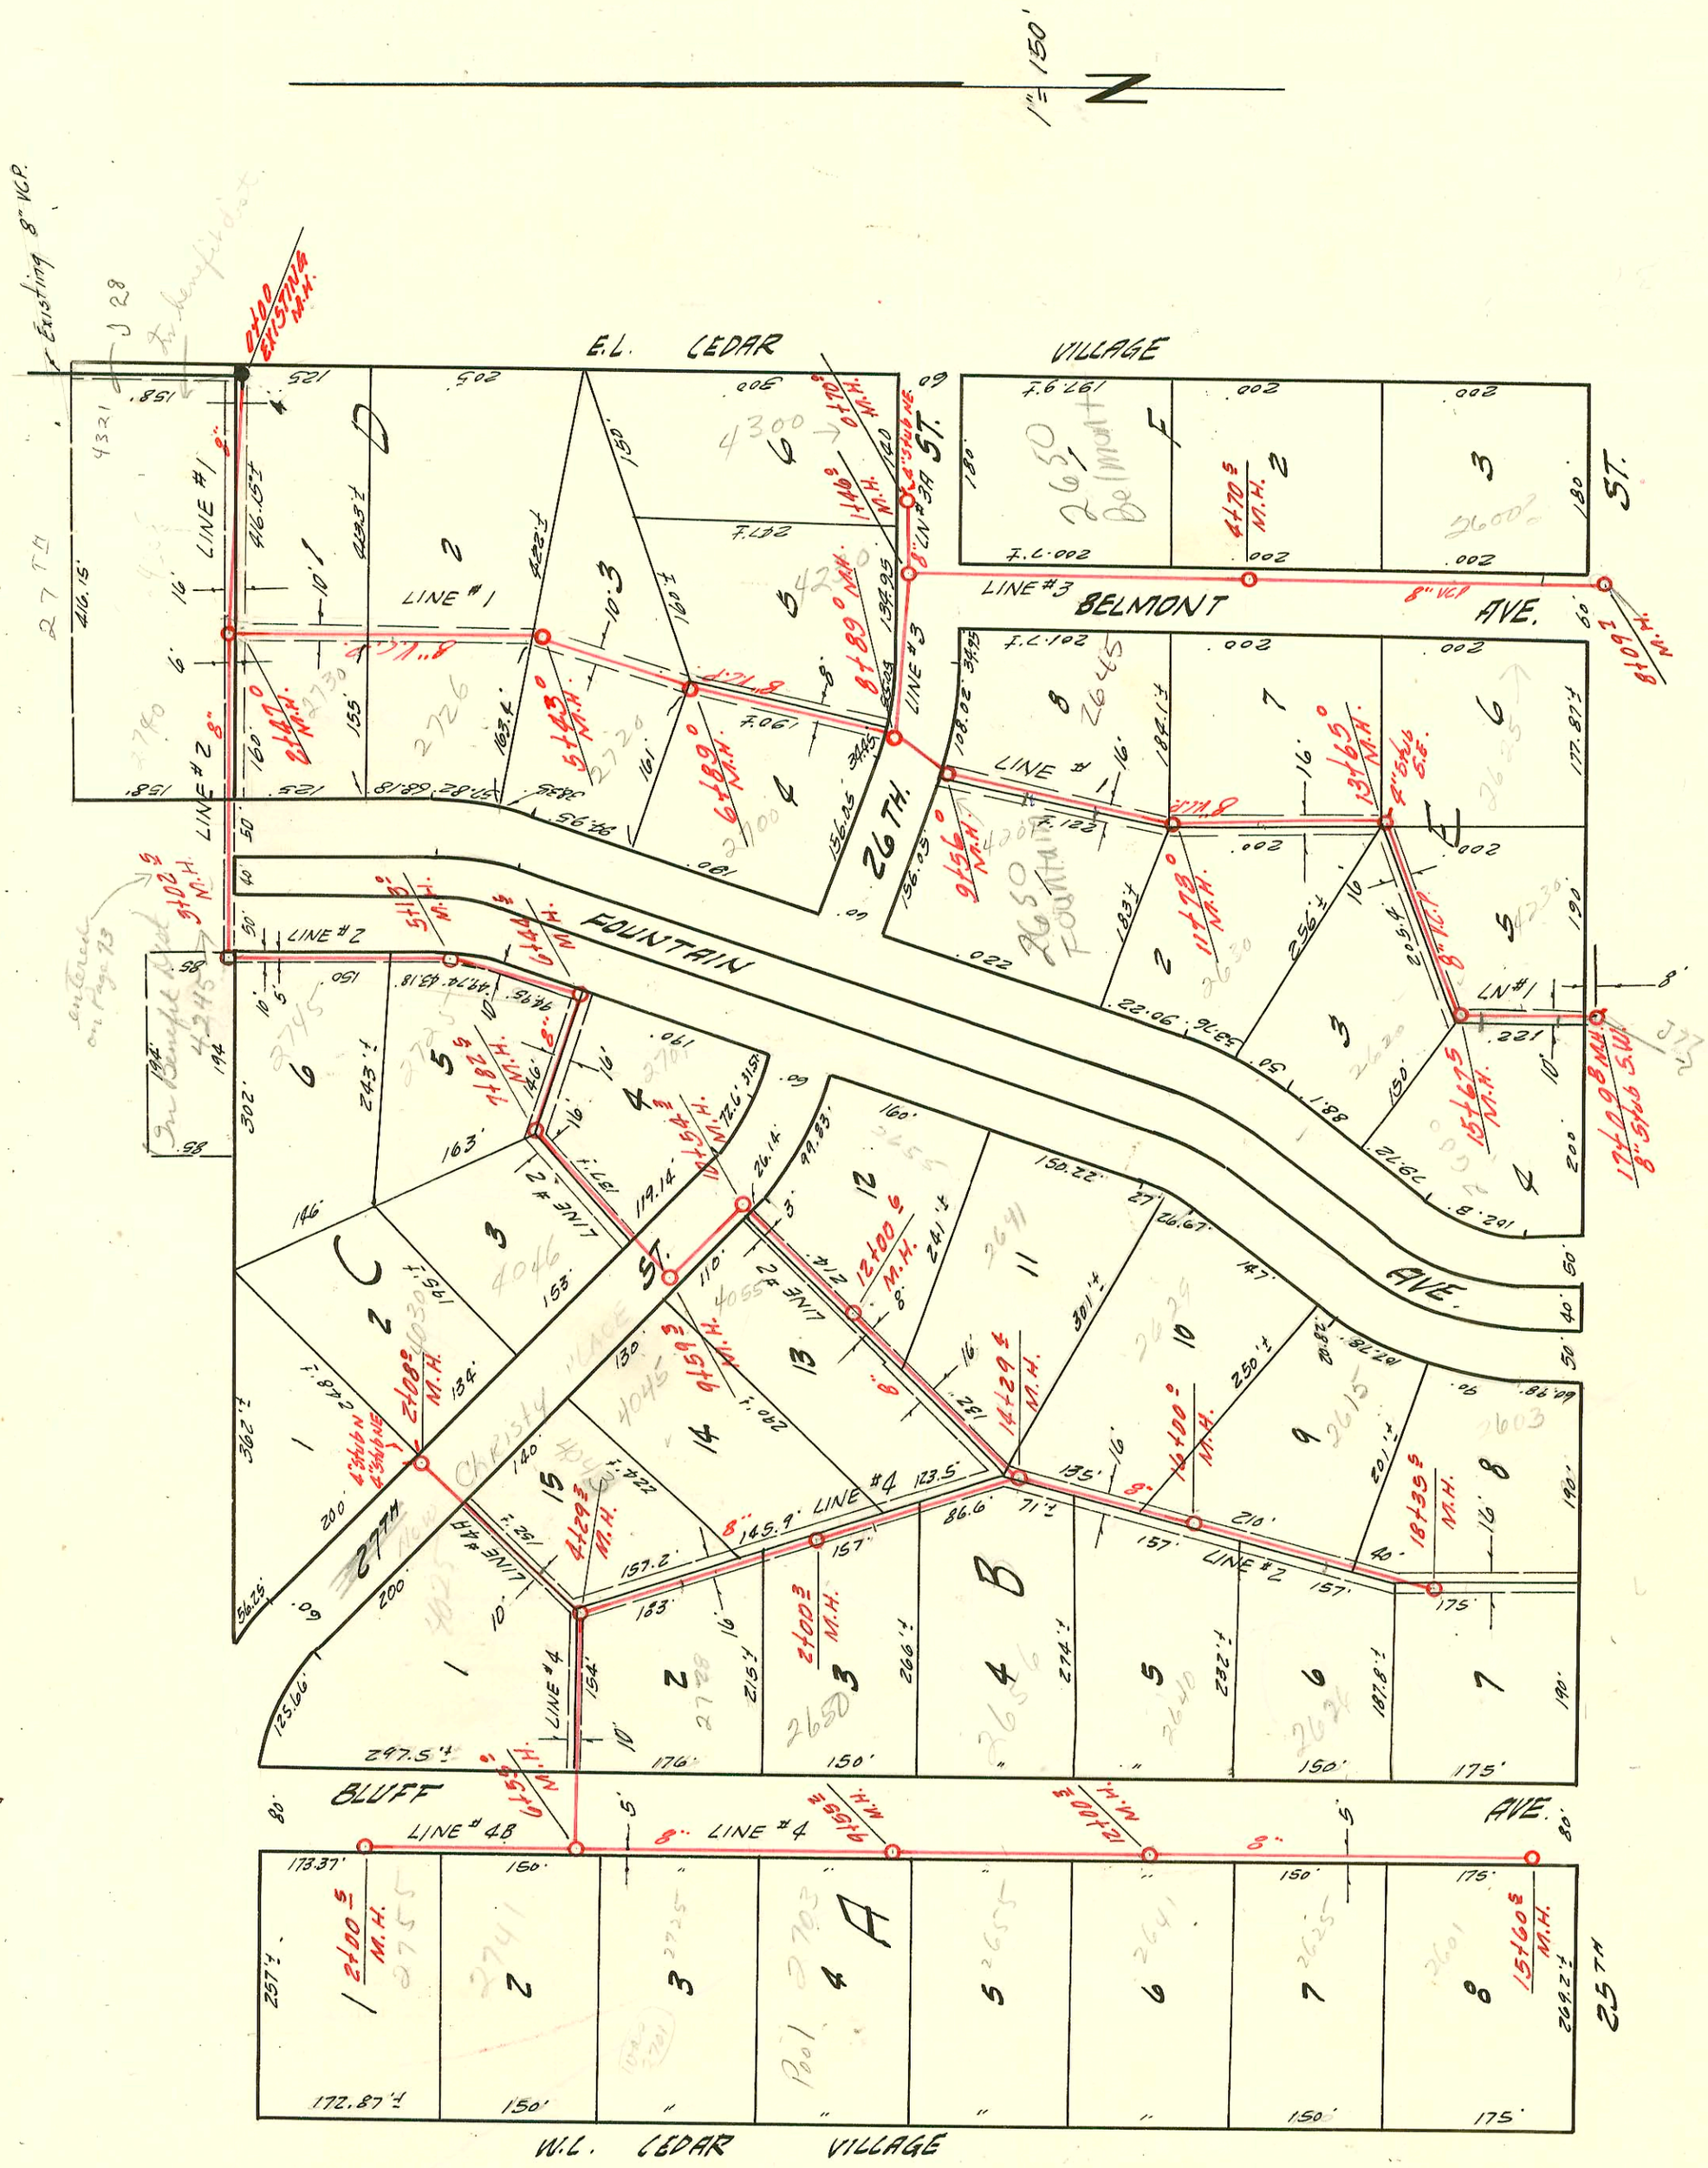

LAT. 4 SUB. 1 SAN. SEWER 23
W.B. CARTER CONST. CO. JULY, 1959
BOOK NO. K-45 A. PROJ. NO. CZB-52

Rep 2000-02031- 9/15/00- 2726 N Fountain Ave- Reddi Rootr- 4" SCH40 76'N of MH 5+43 (4+67) 1 Twin co, 1 V22, 2 H22, 1 V45, 1 Fernco to clay 2' from Main / Fernco to cast iron athouse / looks like tap on top of Main (old tap) / tap not uncovered.

72

Form 41-(54) 6-57

CONSTRUCTION RECORD							SERVICE RECORD					
STATION	ELEVATION		Depth	MANHOLE	4-INCH "Y" BRANCHES		No. of Permit		House Number		DATE OF PERMITS	
	Ground	Grade			North West	South East	North West	South East	North West	South East	North West	South East
				(LINE #4 Continued)								
11+00	175.0	168.00	8.0		1+11 +66.5							
12+00	177.5	169.40	8.1		11+77°		C58975		2641 N. Bluff		12-6-76	
				12+00 3								
13+00	179.2	169.80	9.4		13+93.7							
14+00	179.8	170.20	9.6		~~13+34.5~~		C72381		2625 N. Bluff		6-18-79	
15+00	179.3	170.60	8.7									
					15+47 2 (2° Riser)		11237		2611 N. Bluff		8-19-59	
				15+60 5								
				(LINE #3)								
0+00	166.1	160.45	5.6'	0+00								
					0+70°		11123		4230 S 26th		7-30-59	
1+00	166.7	161.30	5.4									
				1+46°								
2+00	167.4	162.20	10.6									
3+00	169.6	163.00	6.6			4" PVC 40 3+78.5 tap		93-24944-7		(see below) 2650 N Belmont A		9-16-93
						3+85°		10759		2650 N Belmont		6-30-59
4+00	171.9	163.80	8.1									
				4+70 5								
5+00	173.1	164.60	8.5									
						5+33°		11124		2630 N Belmont		7-30-59
6+00	173.8	165.40	8.4									
7+00	174.9	166.20	8.7									
						7+56° 4" ABS 40 ✓		92-12947 11138		2600 N R Belmont		1-31-92 8-3-59
8+00	175.5	167.00	8.5									
	175.5	167.03	8.5	8+09 1								
				LINE # 3A								
0+00				0+00								
				0+70° (4" stub NE)			10760		4300 E 26th		6-30-59	
				~~LINE #4~~								
0+00				0+00								
					0+28° (8' Riser)							
1+00												
					1+46 5 (11' Riser)							
						1+85° (11' Riser)						
2+00												
				2+00 3								
					2+93° (11° Riser)							
3+00												
4+00												
				4+29 3								
5+00												
6+00												
				6+55°								
7+00												
8+00												
					8+04°							
9+00					9+31 5							
				9+55 2								
10+00												
					10+39 5							
11+00												
					11+77°							
12+00				12+00 3								
13+00												
					13+34 5							
15+00												
16+00												

VOID

93-24944-7 - 2650 N. Belmont - 4" PVC40 - 4" City tap - 92 ft north - 1/4" pf shallow - (NOTE: Stubout from rear of house is not connected to this sewer.)

72 A