J 105A

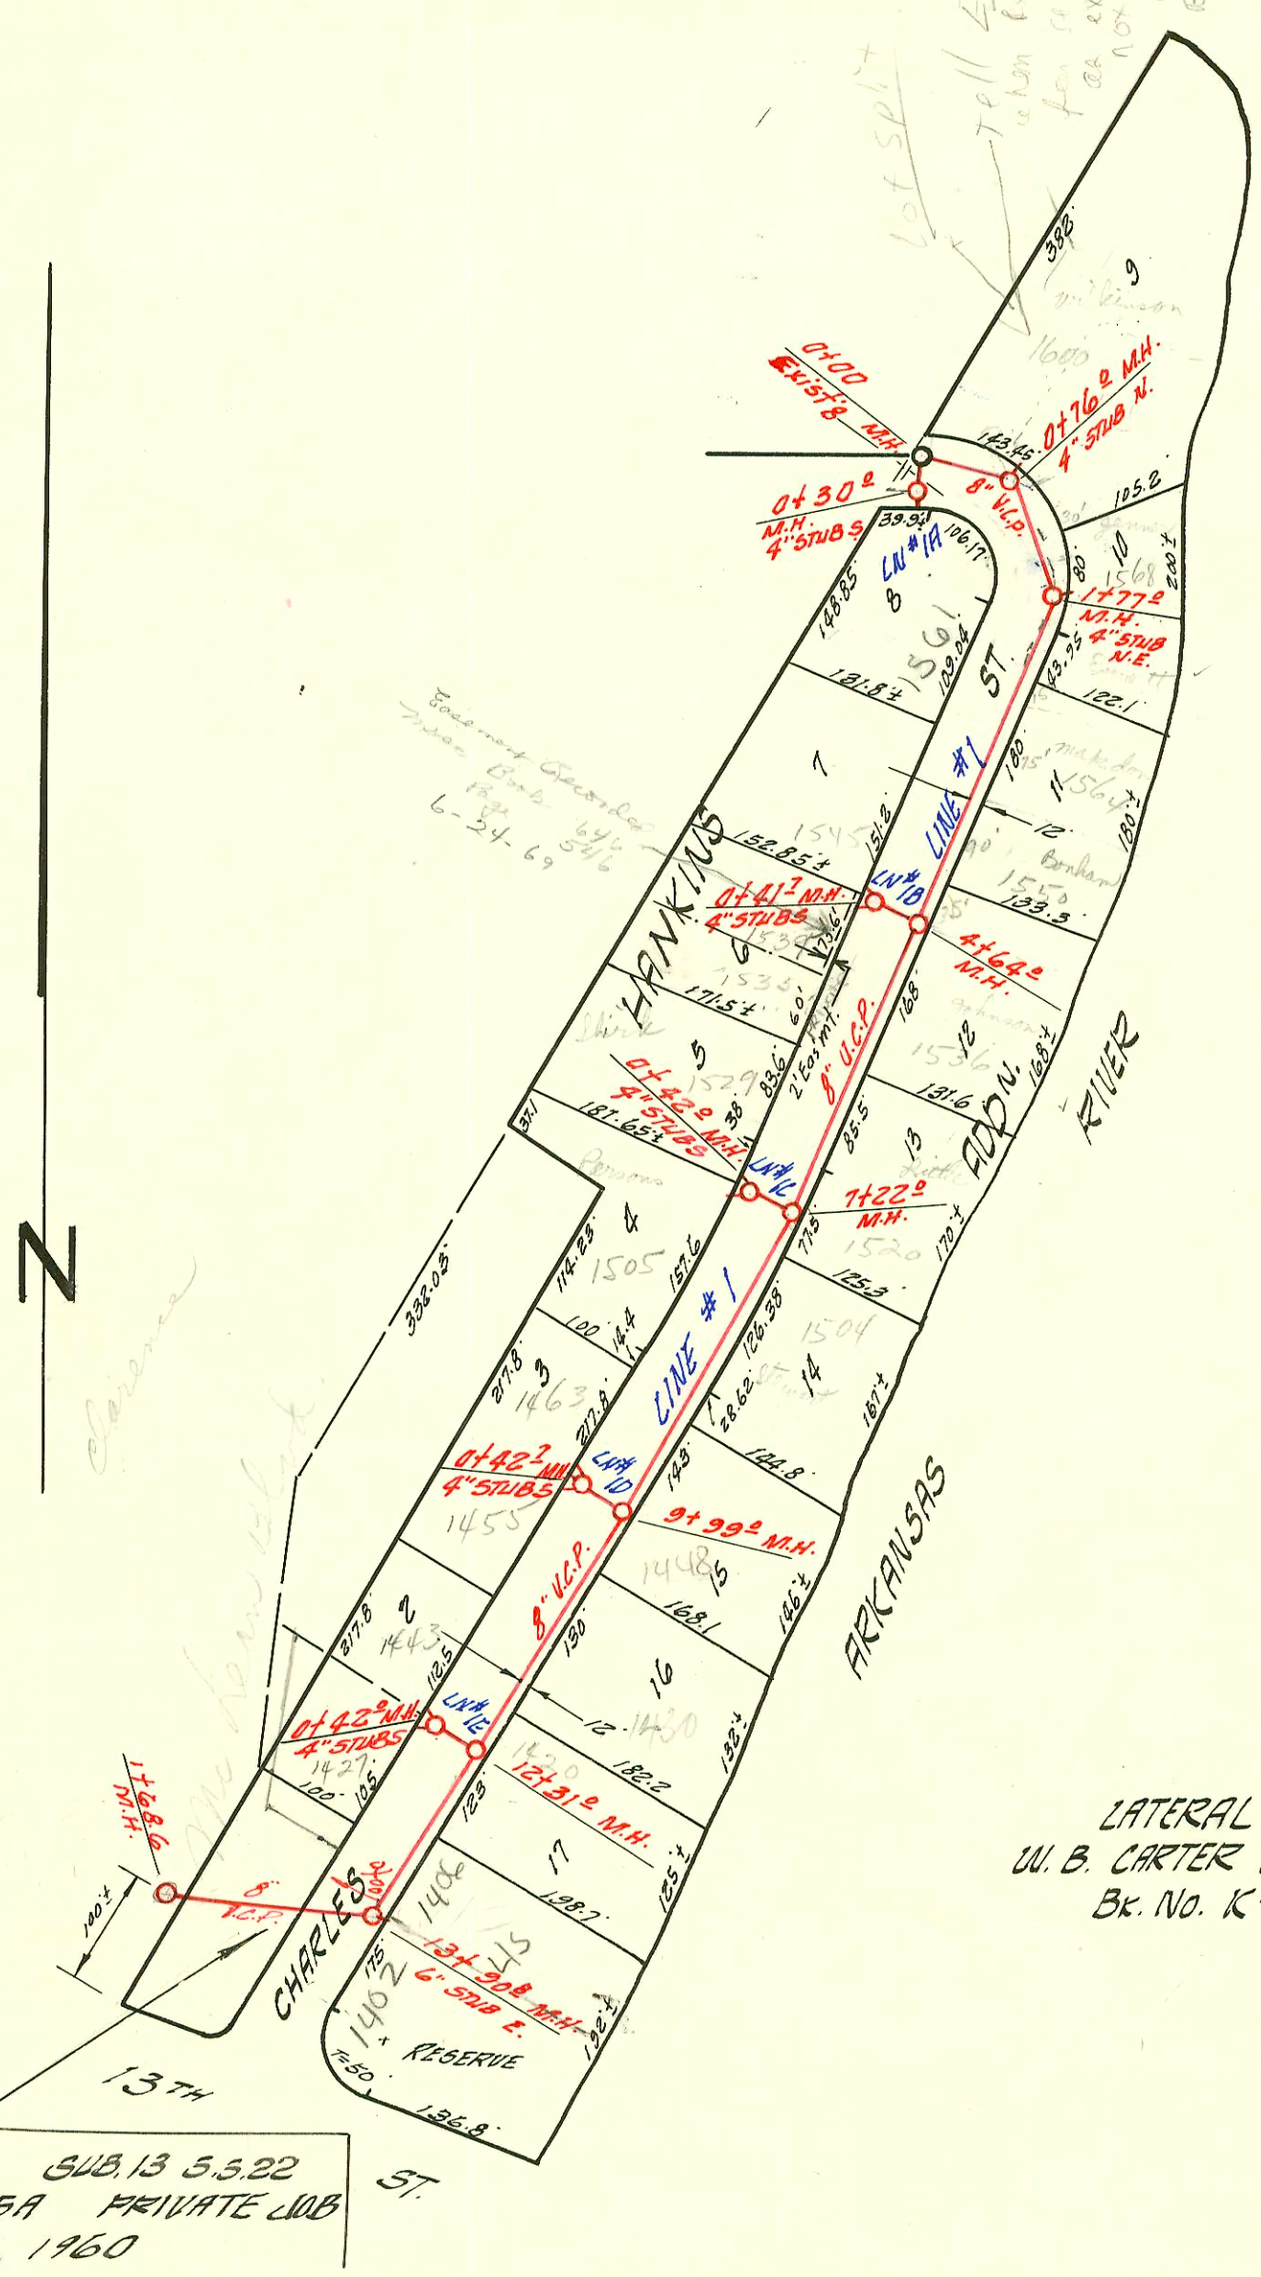

EXT. LAT. 16 SUB. 13 S.S. 22
BK. NO. K-45A PRIVATE JOB
SEPT. 14, 1960

LATERAL 16 SUB. 13 S.S. 22
W. B. CARTER CONSTR. CO. NOV. 25 '59
BK. NO. K-51A PROJ. NO. C29-87

See Betty R. 5/12/87

105

Form 41-(54) 6-57

CONSTRUCTION RECORD / SERVICE RECORD

STATION	ELEVATION Ground	ELEVATION Grade	Depth	MANHOLE	4-INCH "Y" BRANCHES North West	4-INCH "Y" BRANCHES South East	No. of Permit North West	No. of Permit South East	House Number North West	House Number South East	DATE OF PERMITS North West	DATE OF PERMITS South East
LINE #1												
0+00	119.1	113.67	5.4	Existing M.H.								
	121.0	113.75 (out) 113.85 (in)	7.2 7.1	+76°	4" Stub N.E.			12534		1600 N. Charles		4-25-60
1+00	120.5	113.87	6.6									
	121.3	113.95 (out) 114.05 (in)	7.3 7.2	+77°	4" Stub N.E.			13494		1574 N. Charles		11-8-60
2+00	121.2	114.07	7.1									
						+30°		12052		1568 N. Charles		12-11-59
3+00	120.8	114.17	6.6									
						+19°		16814		1564 N. Charles		3-21-63
						+97°		C47892		1550 N. Charles		12-26-74
4+00	120.7	114.27	6.4									
	120.3	114.34	6.0	4+64°								
5+00	120.3	114.37	5.9									
						+84°		12109		1536 N. Charles		12-23-59
6+00	120.4	114.47	5.9									
7+00	120.8	114.57	6.2									
	120.5	114.59	5.9	7+22°								
						+25°		12068		1520 N. Charles		12-18-59
8+00	120.3	114.67	5.6									
						+12°		12678		1504 N. Charles		4-21-60
						+43°						
9+00	119.6	114.77	4.8									
	119.7	114.87	4.8	9+99°								
10+00												
						10+14°		12848		1448 N. Charles		5-27-60
11+00	119.5	114.97	4.5									
						+01°		12041		1430 N. Charles		12-7-59
						+87.5		11976		1420 N. Charles		12-9-59
12+00	119.8	115.07	4.7									
	119.6	115.10	4.5	12+31°								
13+00	119.3	115.17	4.1					96-41857		1406 N Charles		3-28-96
						+14°		91-39105-7		1402 Charles		12-13-91
	118.5	115.26	3.2	13+90°	4" Stub E		91-39105-7	3601 15579	1400 N. Charles	1400 N. Charles	12-13-91	7-2-81 5-4-62
LINE #1A												
0+00	119.1	113.77	5.3	Existing M.H.								
	120.5	113.97	6.5	0+30°	4" Stub S.			995337		1561 Charles		1-6-99
LINE #1B												
0+00	120.4	114.35	6.0	Existing M.H.								
	121.0	114.45	6.5	0+41.7	4" Stubs N.W. & S.W.		14950	C14942	1545 N. Charles	1535 N. Charles	11-17-61	7-15-69
LINE #1C												
0+00	120.3	114.69	5.6	Existing M.H.			#24983	10178				
	120.4	114.89	5.5	0+42°	4" Stubs S.W. & N.W.		11966	11965	1524 N. Charles	1505 N. Charles	3-9-90 12-7-59	2-9-84 12-7-59
LINE #1D												
0+00	119.9	114.97	4.9	Existing M.H.			#19859	1463				
	119.9	115.40	4.5	0+42.7	4" Stubs N.W. & W & S.W.				N. Charles		3-21-60	
								12560	1455 N. Charles		5-5-60	
LINE #1E												
0+00	119.7	115.20	4.5	Existing M.H.			4"S4140	2000-00843				
	119.4	115.40	4.0	0+42°	4" Stub S.W. & N.W.		12329	13334	1427 N. Charles	1443 N. Charles	(R) see below 2-18-60	4-5-00 9-19-60
EXT. LAT. 16		SUB. 13		S.S. 22								
0+00	118.5	115.50	3.0	Existing M.H.								
1+00	119.1	115.80	3.3				C33184		Sewer off		6-27-72	
					48.6 +38°		#13279		2014 W. 13th		9-6-60	
	122.2	115.84	6.4	1+68.6	C.M.H. top		C33193		2014 W 13th		6-27-72	

R- 2000-00843 - 1443 N Charles - Padgett Exc, tied to old MH Stub, 2 Twinco, 1H22, 2V45, 5H45 4/6/00

12110 tap 1536 N. Charles, Riggs Bldg. 12-23-59 (4+96)

C 25935 1539 N Charles tap - K m Tuley 7-1-11 - MH tap 0+41.7

91-24035 7 6/12/91 1448 N. Charles - (Soil pipe ext. under Room Add.)