J-148 A

See P-226

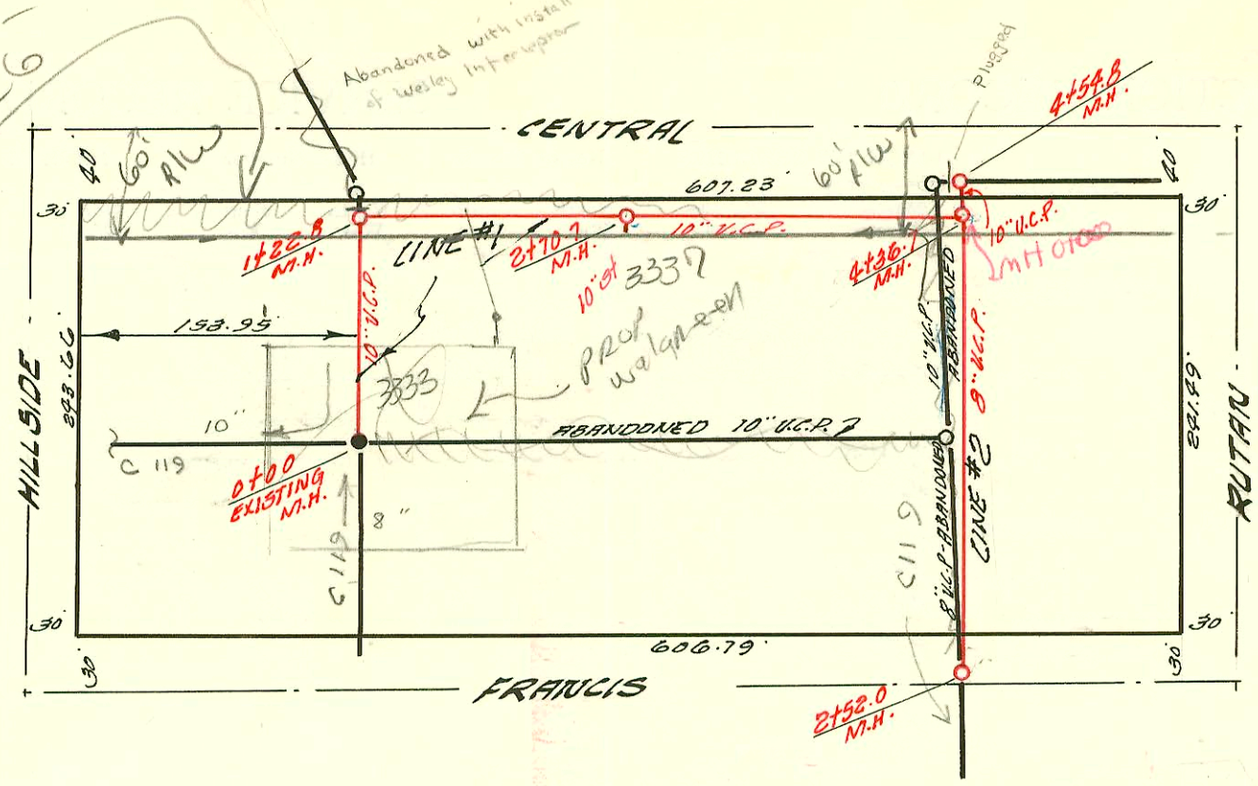

RELOCATION OF A PORTION
OF DIST. C S.S. 12 9-14-60
BK. NO. K-64 PRIVATE JOB

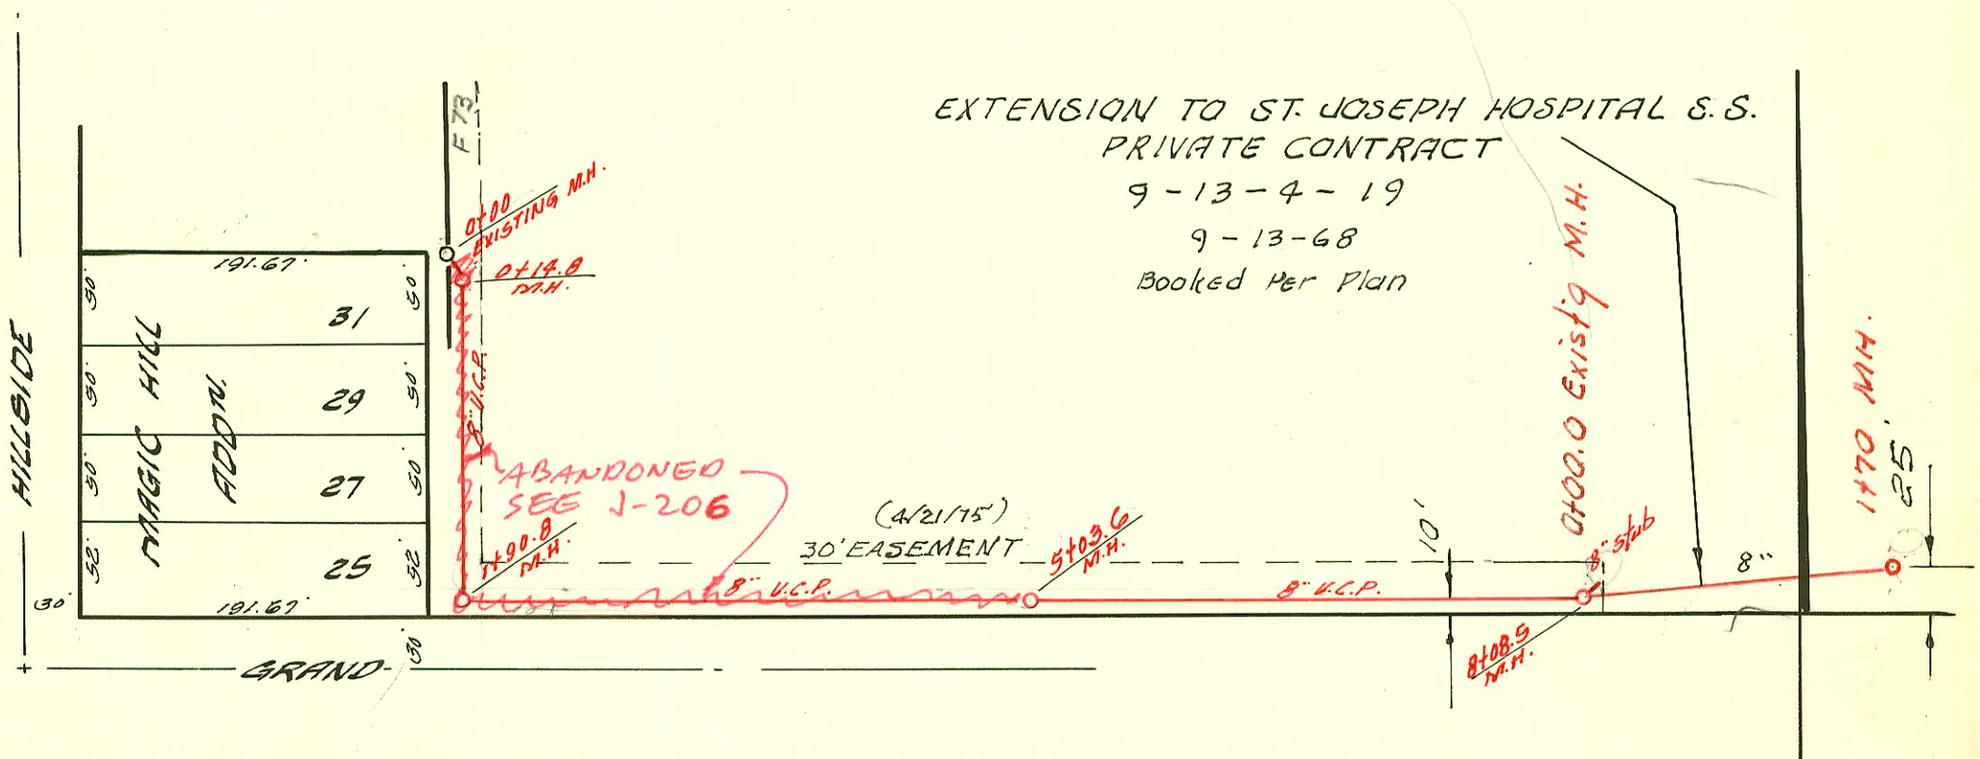

PRIVATE S.S. FOR ST. JOSEPH HOSPITAL
BK. NO. K-48 PRIVATE JOB
SEPT 14, 1960

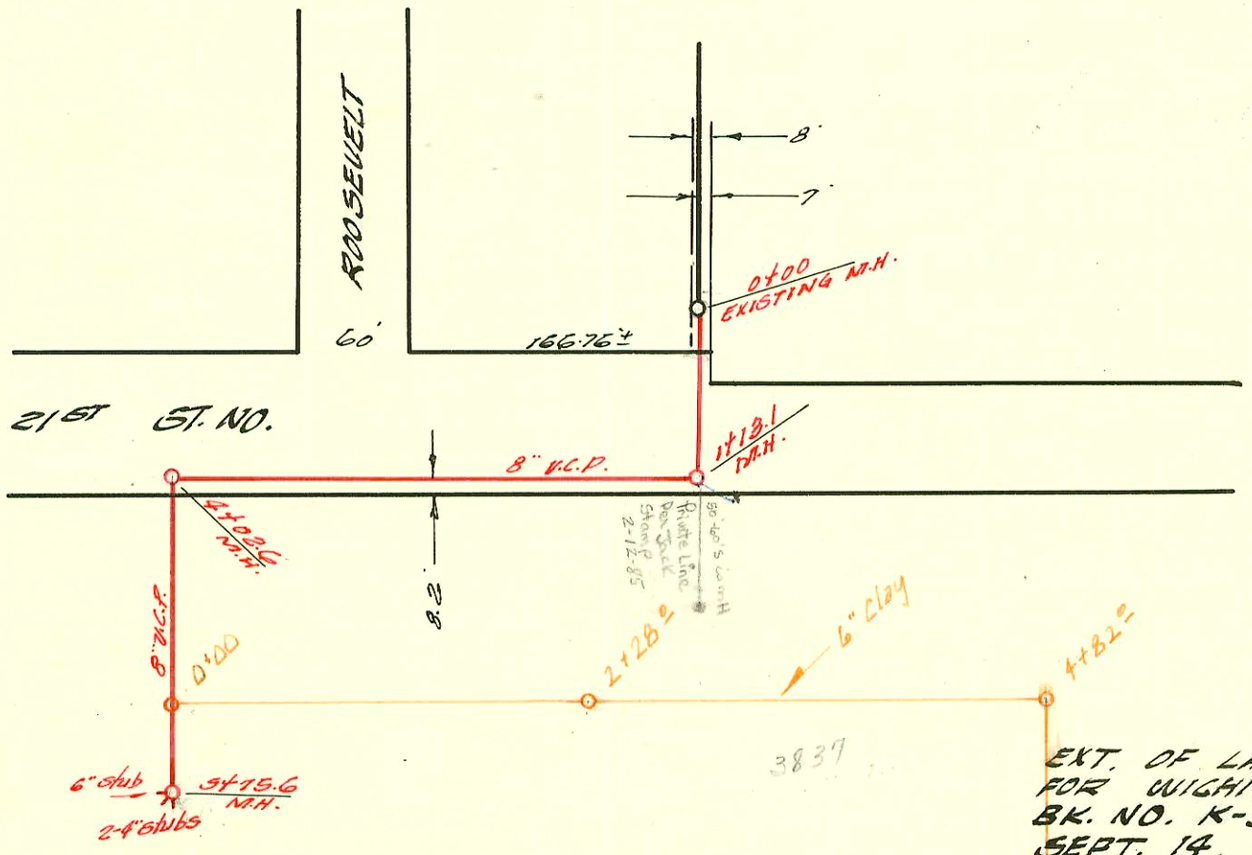

EXT. OF LAT. 7 S.S. 23
FOR WICHITA UNIV.
BK. NO. K-55 PRIVATE JOB
SEPT. 14, 1960

Wichita State University
San. Sew. Replacement
Booked 8-21-73 from "As Built" plan
Pro No BHKB503040

Sent 2003 00056 1-9-03 3337 N Central - David Leffler Mgr!

148

Form 41-(54) 7-60

	CONSTRUCTION RECORD							SERVICE RECORD					
	STATION	ELEVATION		Depth	MANHOLE	4-INCH "Y" BRANCHES		No. of Permit		House Number		DATE OF PERMITS	
		Ground	Grade			North West	South East	North West	South East	North West	South East	North West	South East
LN #1	0+00	140.2	131.00	9.2	Existing M.H.								
	1+00	141.7	131.22	10.5									
		141.9	OUT 131.27 IN 131.39	10.6 10.5	1+22.8								
	2+00	141.9	131.56	10.3									
		141.3	131.70	9.6	2+70.7	8" Lex pipe to 10" Stub S.			2002-01120 14026		3833 S.T.O. 3715 E. Central	See next page	4-1882 3-30-61
	3+00	141.8	131.78	10.0									
	4+00	141.0	132.00	9.0									
		141.6	132.07	9.5	4+36.7								
		141.3	132.21	9.1	4+54.8								
LN #2	0+00	142.0	132.30	9.7									
	1+00	141.9	132.80	9.1									
	2+00	142.0	133.30	8.7									
		143.8	133.74	10.1	2+52.0								
S.S. FOR ST. JOSEPH HOSPITAL													
	0+00	116.4	109.01	7.4									
		116.9	109.16	7.7	0+14.8								
	1+00	120.7	110.01	10.7									
		125.0	OUT 110.91 IN 111.04	14.1 14.0	1+90.8	25' BK OF N.CB Grand							
	2+00	125.2	113.13	12.1									
	3+00	129.0	112.13	16.9									
	4+00	132.7	113.13	19.6									
	5+00	132.5	114.13	18.4									
		132.0	114.43	17.6	5+03.6			2000 01211		3310 E. Grand (St. Joe Inn)		5-1600	
	6+00	130.6	115.13	15.5									
	7+00	131.8	116.13	15.7									
	8+00	134.0	117.13	14.9									
		134.1	117.22	16.9	8+08.5	8" stub							
EXTENSION LAT. 7 S.S. 23													
	0+00	196.1	189.60	6.5	Existing M.H.								
	1+00												
		195.6	190.03	5.6	1+13.1								
							+81.8 (4.5)		13309		3635 E. 21st		9-7-60
	2+00	195.7	190.50	5.2									
	3+00	197.4	190.90	6.5									
	4+00												
		199.6	191.31	8.3	4+02.6								
	5+00	202.6	191.80	10.8									
		201.1	192.10	9.0	5+75.6	4" Stub S. 4" Stub S.W. 6" Stub W.		13304 13303 9236 13302		3625 E. 21st (Corbin Center) 3625 E. 21st 2150 N. yale		9-7-60 9-7-60 9-19-83 9-7-60	
						0+60		16700		1845 Fairmount		2-25-63 - W. H.	
EXTENSION TO ST. JOSEPH HOSPITAL S. S.													
	0+00	132.6	116.95 out 120.95 in	15.7 11.6	0+09.0 Exist'g MH								
	1+00	134.8	127.22	7.6		Y-N ?		C6903 to C6918 (16 conn.)		3400 E. GRAND St. Joseph Hosp.		8-16-68	Snodgrass + Lane Const. (Private line extension)
		137.8	131.60	5.6	1+70			C25661 (set 4" on 6" wye)		3400 E. Grand		7-16-71	(Private line extension) Dan Lee
Wichita State University San. Sew. Replacement.													
	0+00	198.0	out. 190.3 in 191.0	7.7 7.0	0+00								
	1+00												
	2+00												
		199.2	191.91	7.3	2+28 ±								
	3+00												
	4+00												
		199.3	191.87	7.4	4+68 ±								

C40007 - 3837 E. 21st - Corbin Center - Frank Jenkins - New 6" line ext. E from 0+00 - 7/12/73

Rev. #48008 Lev. 3 at 50 gph. 9-7-60 2150 N. yale W.B. Carter (Permit #13304)

Rev. #48007 Lev. 3 at 50 gph. 9-7-60 3635 E. 21st W.B. Carter (Permit #13309)

#13301 Private line connection 3625 E. 21st (Dormitory) W.B. Carter 9-7-60 (6" line from 2150 N. yale to MH 5+75.6)

#16685 - top into M.H. 1+13.1 - Mid-Cont. Const. Co. - Junior Cultural Bldg. W.H. 2-25-63

#16699 - top into M.H. 1+76 - Gray Const. Co. - Junior Culture Bldg. W.H. 2-25-63 - 1845 Fairmount